



Protected Structures  
 Mining Completed Area  
 Lease Coal To Be Mined

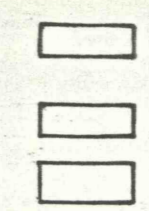

ANNIE ZOLDY  
 92.42 Ac.

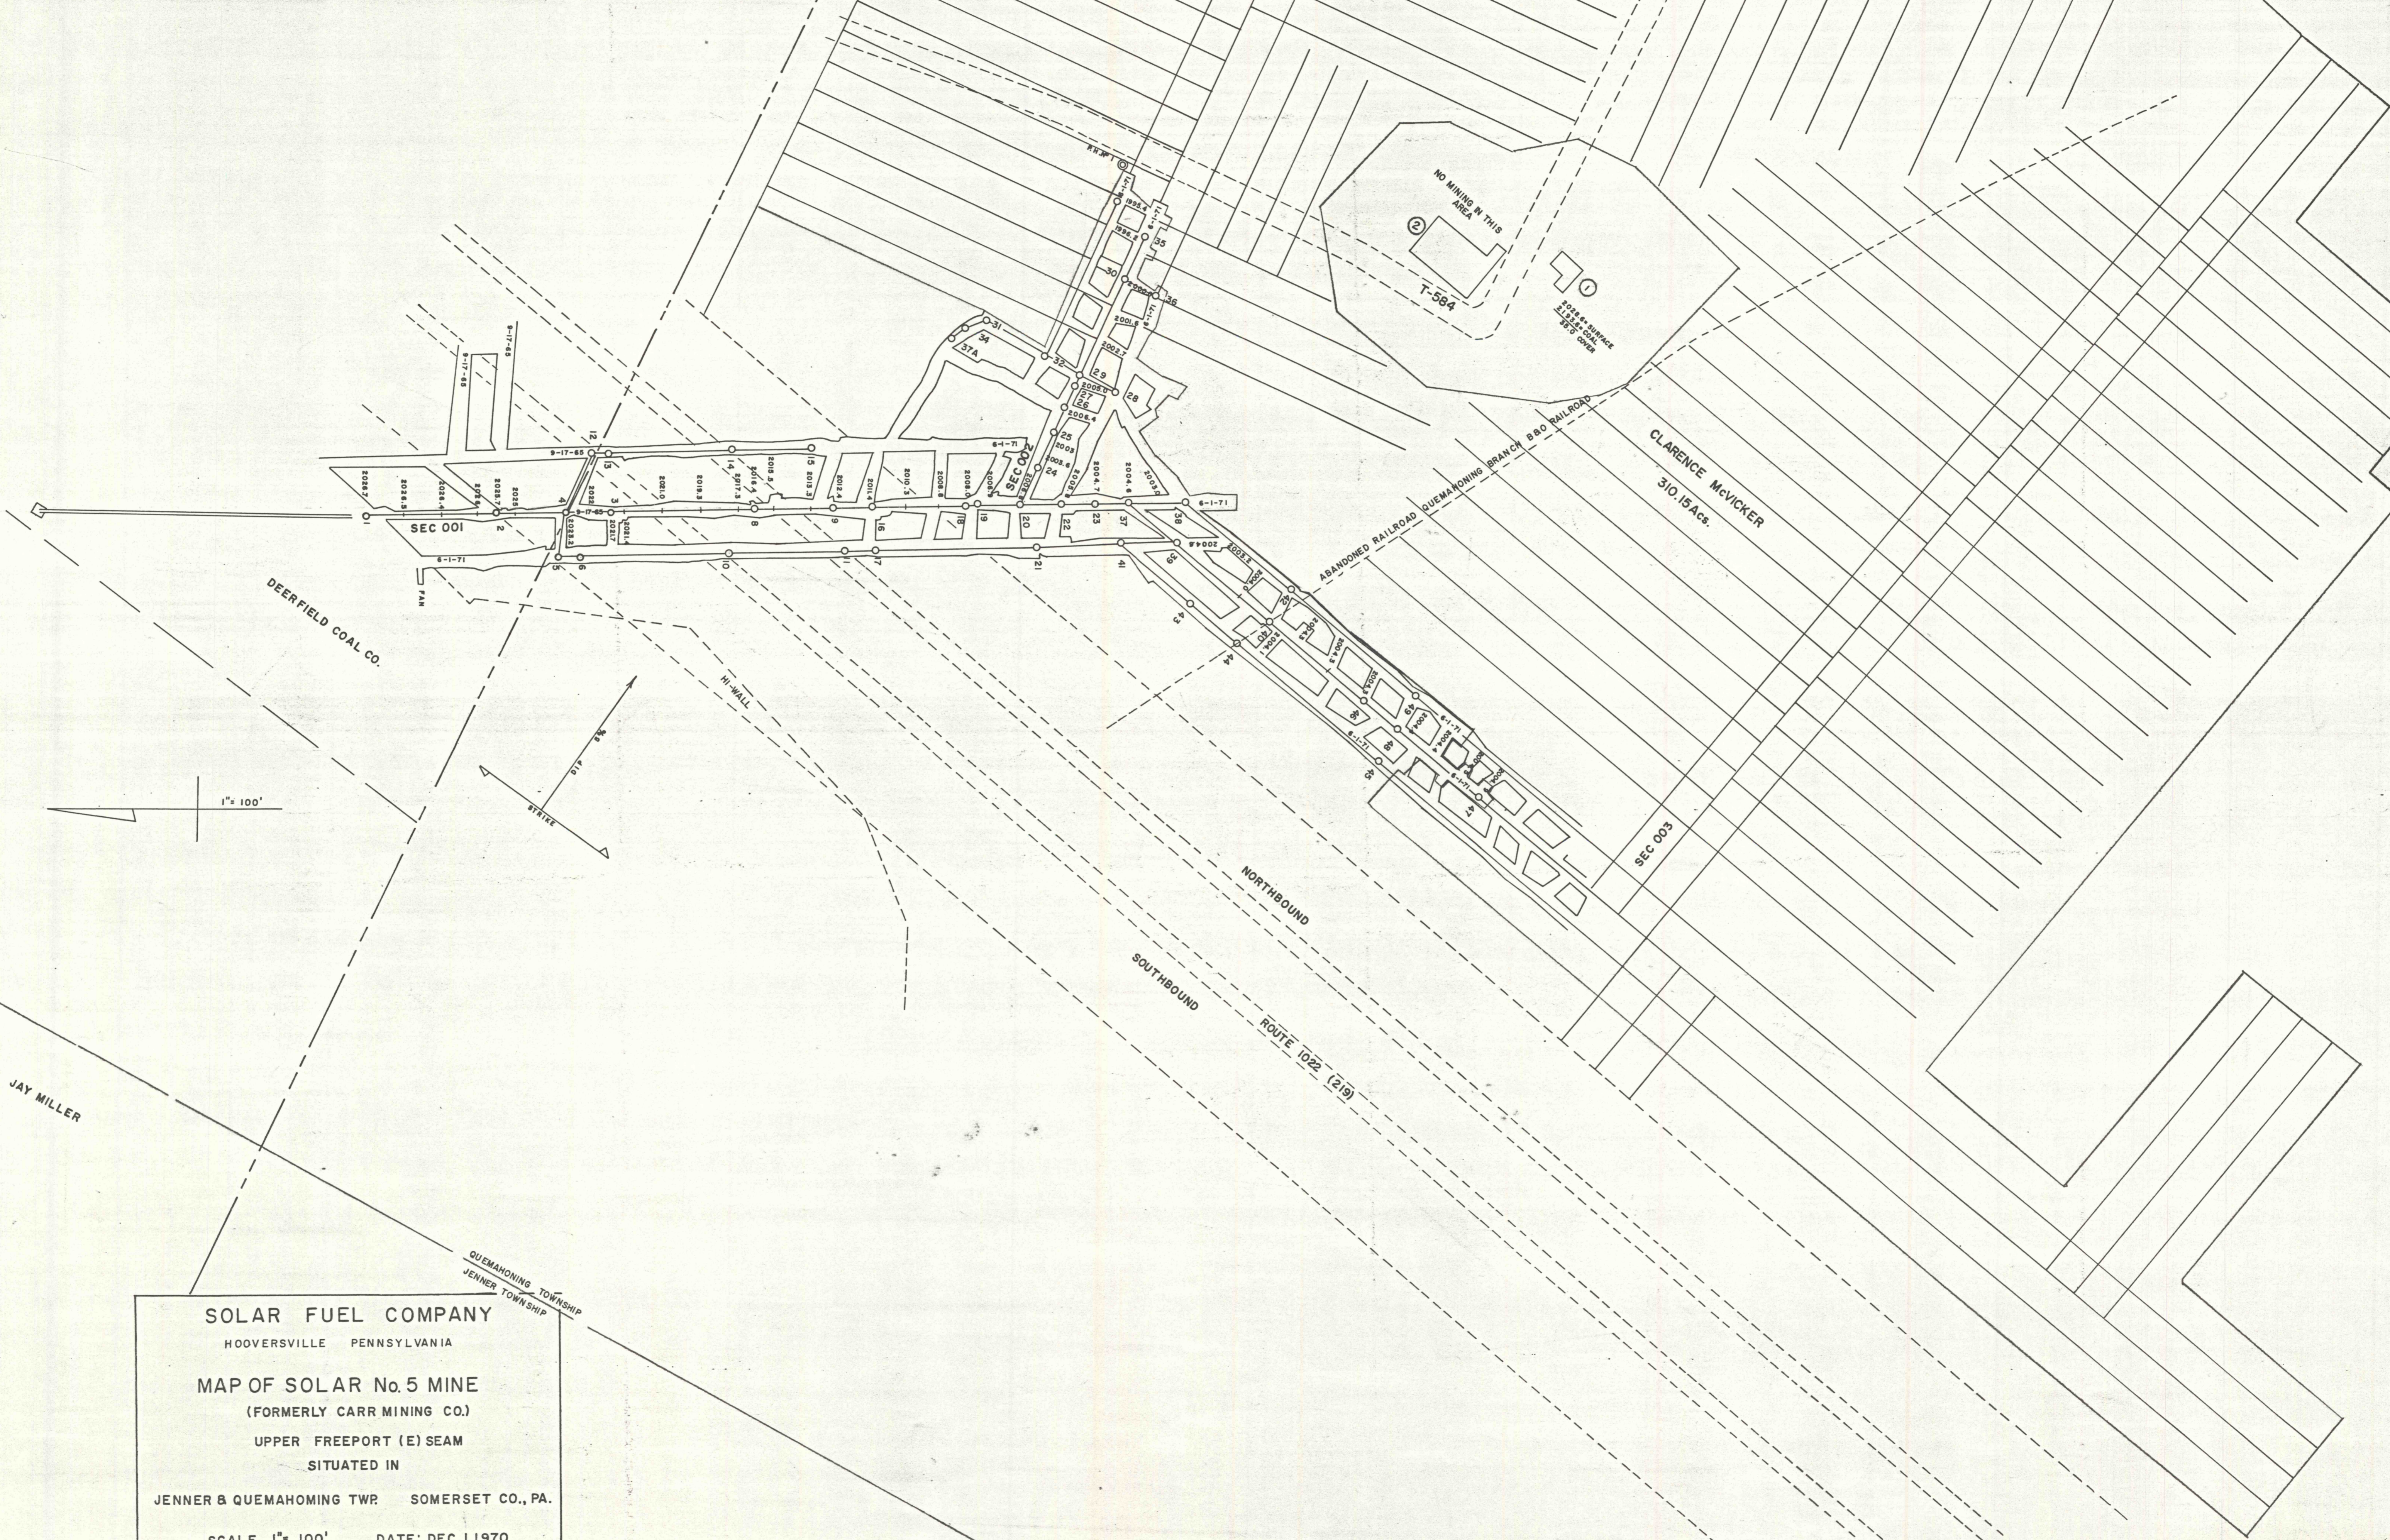

**SOLAR FUEL COMPANY**  
 HOOVERVILLE PENNSYLVANIA

**MAP OF SOLAR No. 5 MINE**  
 (FORMERLY CARR MINING CO.)  
 UPPER FREEPORT (E) SEAM  
 SITUATED IN  
 JENNER & QUEMAHOMING TWP. SOMERSET CO., PA.

SCALE 1" = 100'    DATE: DEC. 1, 1970  
 MINE NO. 36 026170