


SOLAR FUEL COMPANY
 SOLAR N° 5 (formerly CARR MINING COMPANY)
 JENNER & QUEMAHONING TWP.—SOMERSET CO. PA.
 Scale: 1"=100' Survey Date 6-1-71
 Sheet N° 1

LEGEND

- Contemplated Mining 6-1-71 to 12-1-71
- Support Area
- Protected Structures
- Mining Completed Area
- Lease Coal To Be Mined

ANNIE ZOLDY
 92.42 Ac.

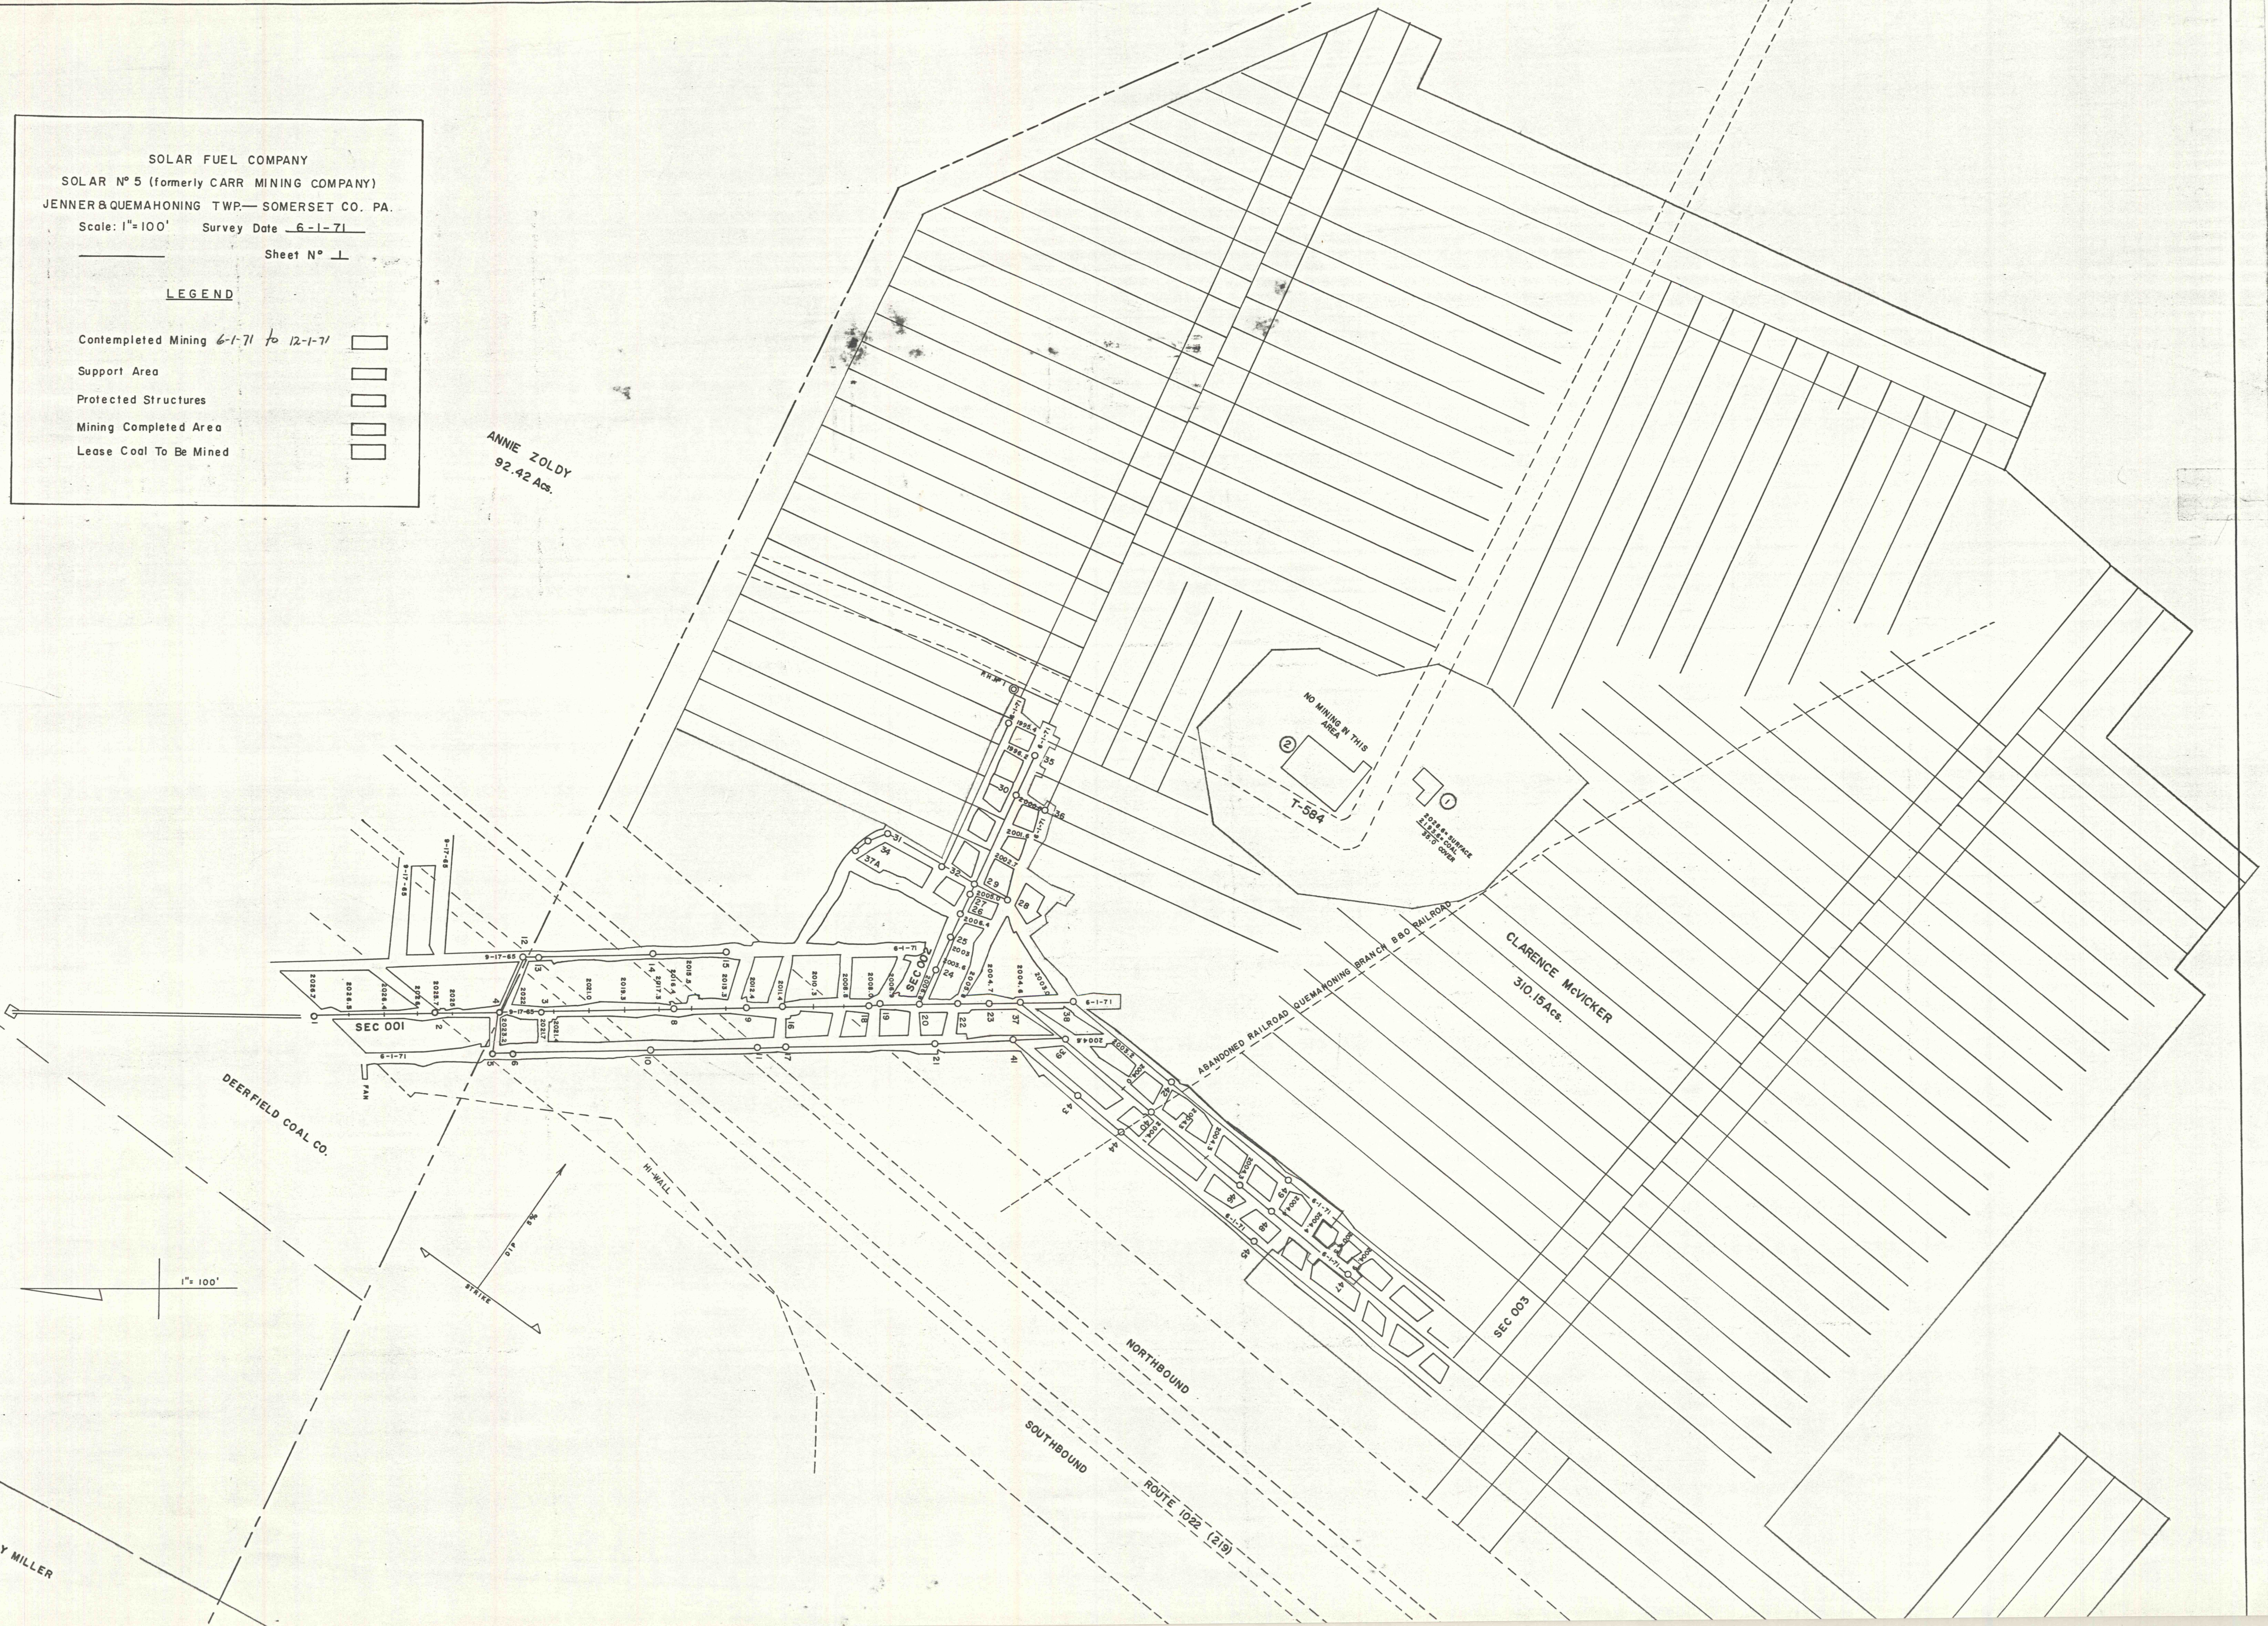

JAY MILLER