


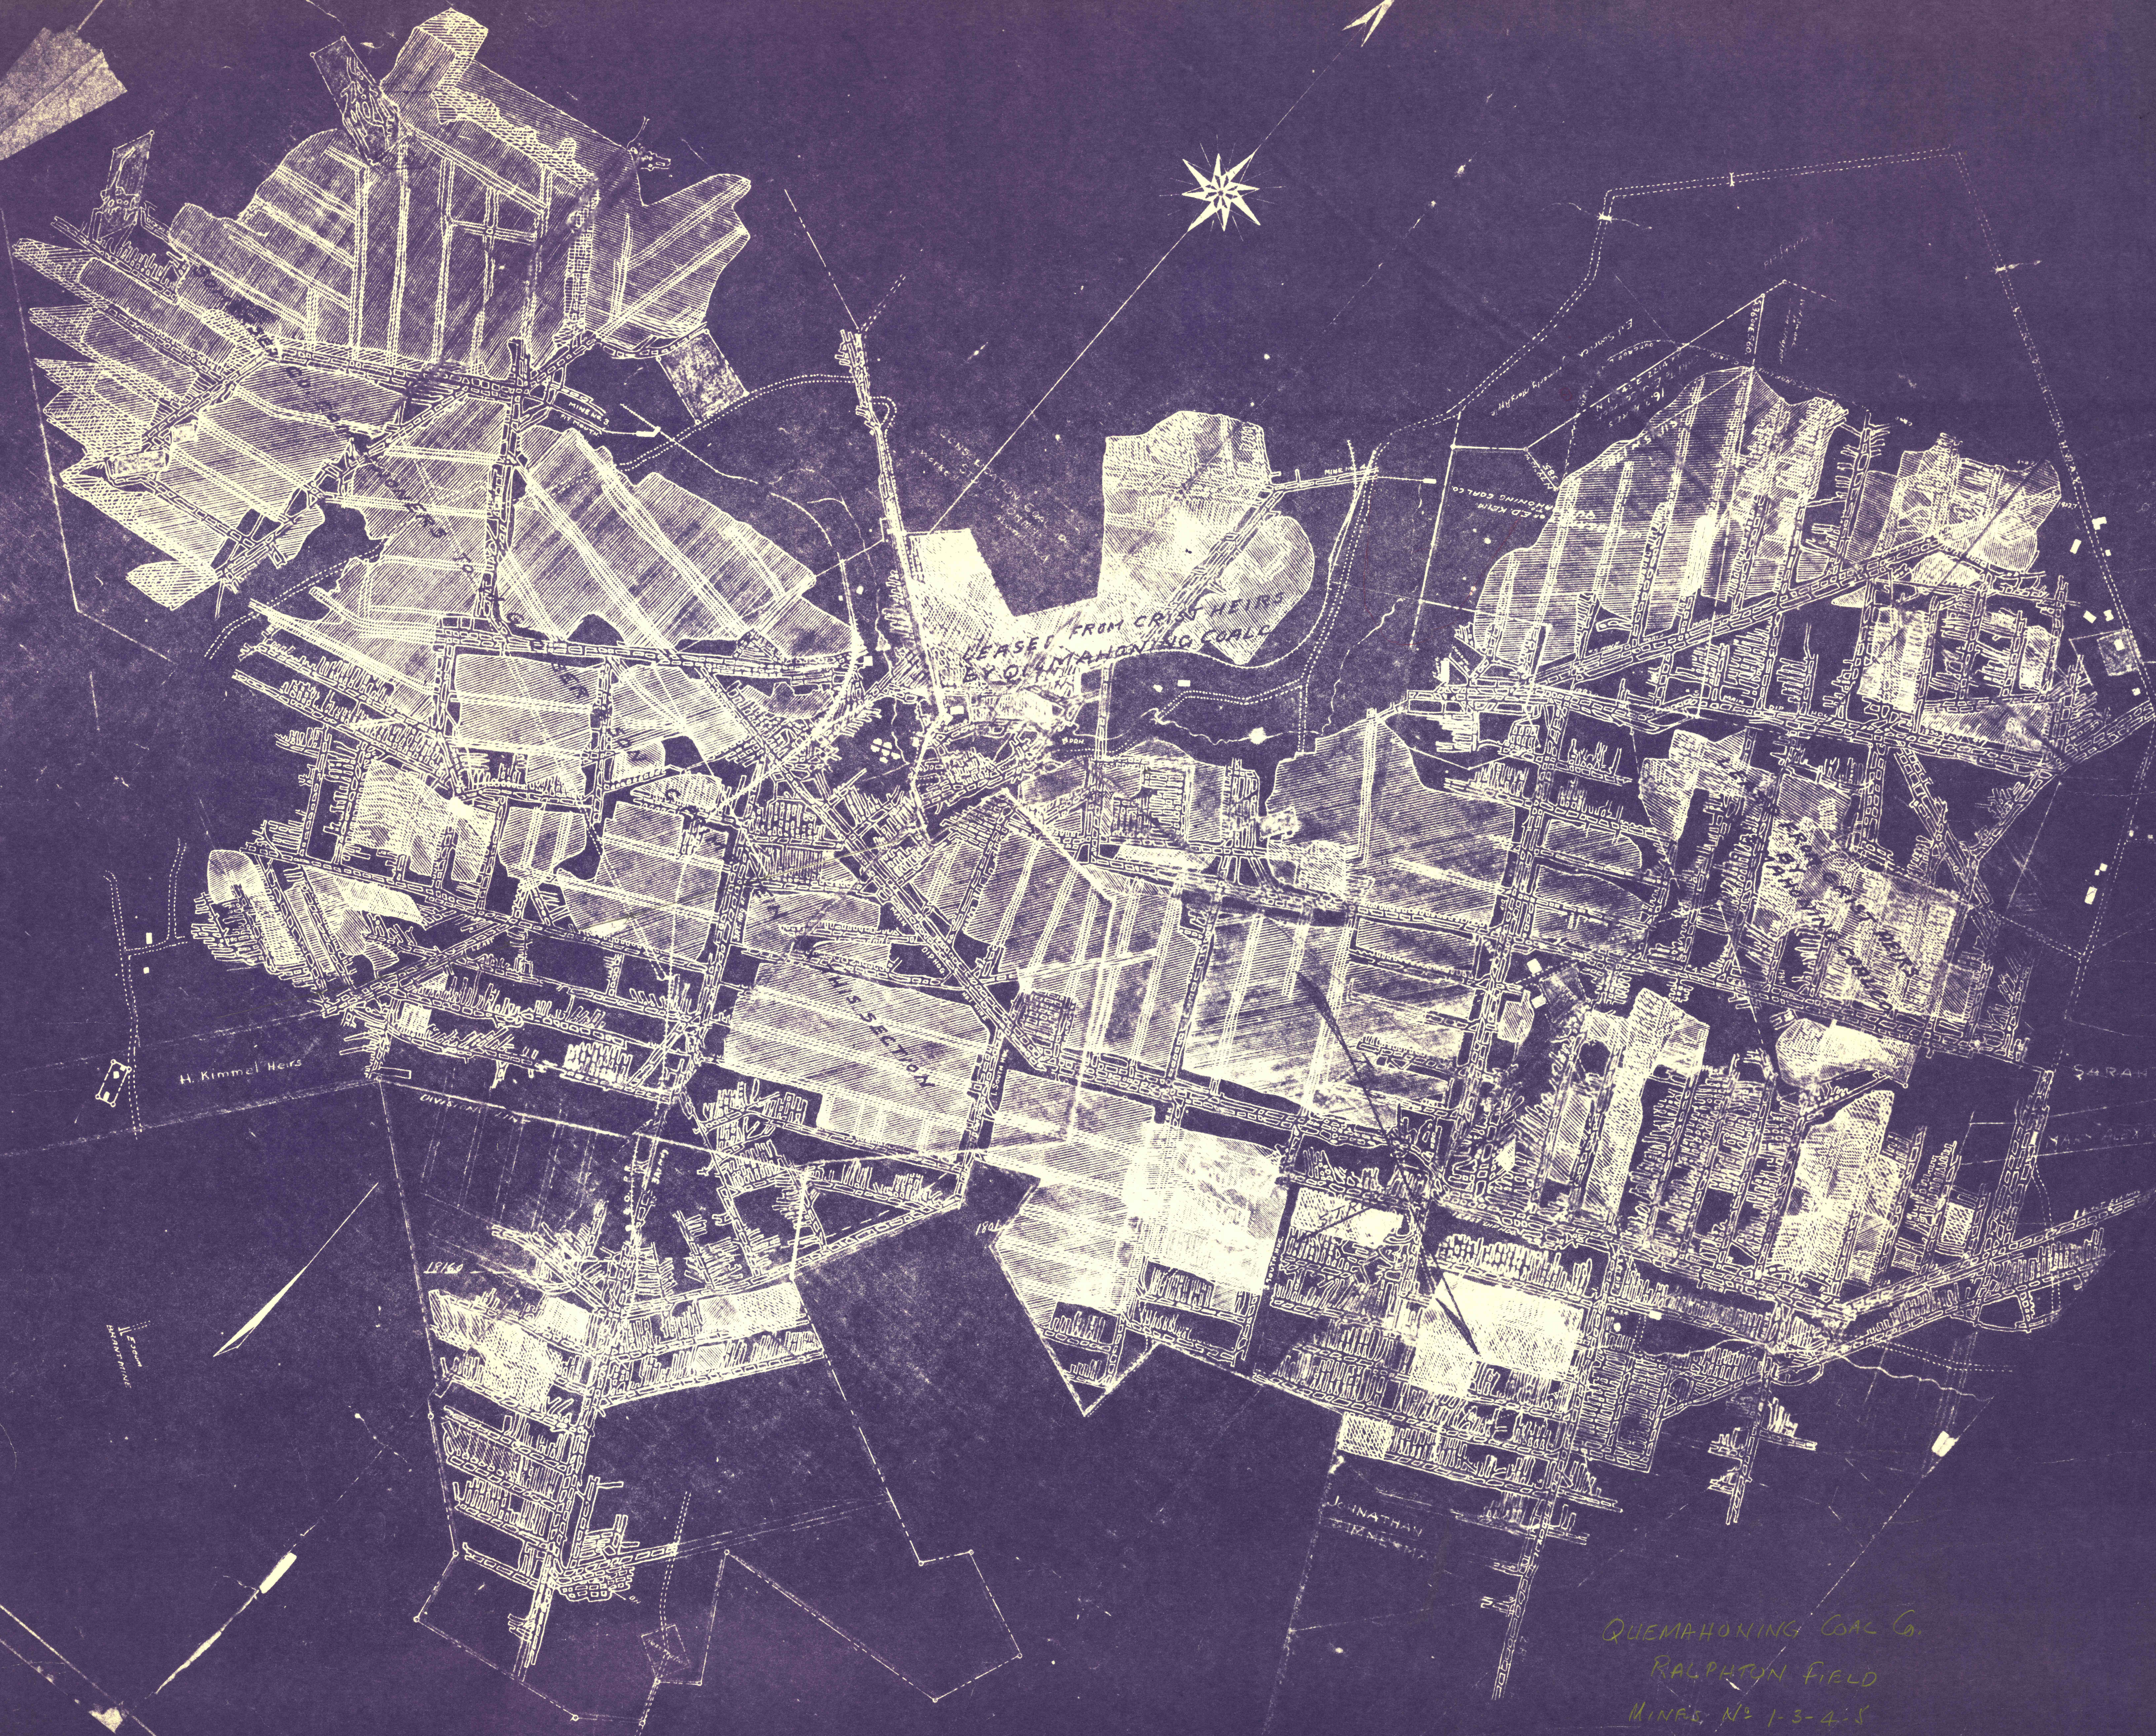

LEASED FROM CRIST HEIRS
BY QUEMAHONING COAL CO.

H. Kimmel Heirs

DAVID BOYMAN

SARAH HUMMEL

QUEMAHONING COAL CO.
MINES Nos 1-3-4-5
