


SOLAR FUEL COMPANY
 SOLAR No. 5 (formerly CARR MINING COMPANY)
 JENNER & QUEMAHONING TWP.— SOMERSET CO. PA.
 Scale: 1"=100' Survey Date 6-1-71
 Sheet No. 1

LEGEND
 Contemplated Mining 6-1-71 to 12-1-71
 Support Area
 Protected Structures
 Mining Completed Area
 Lease Coal To Be Mined

ANNIE ZOLDY
 92.42 Acs.

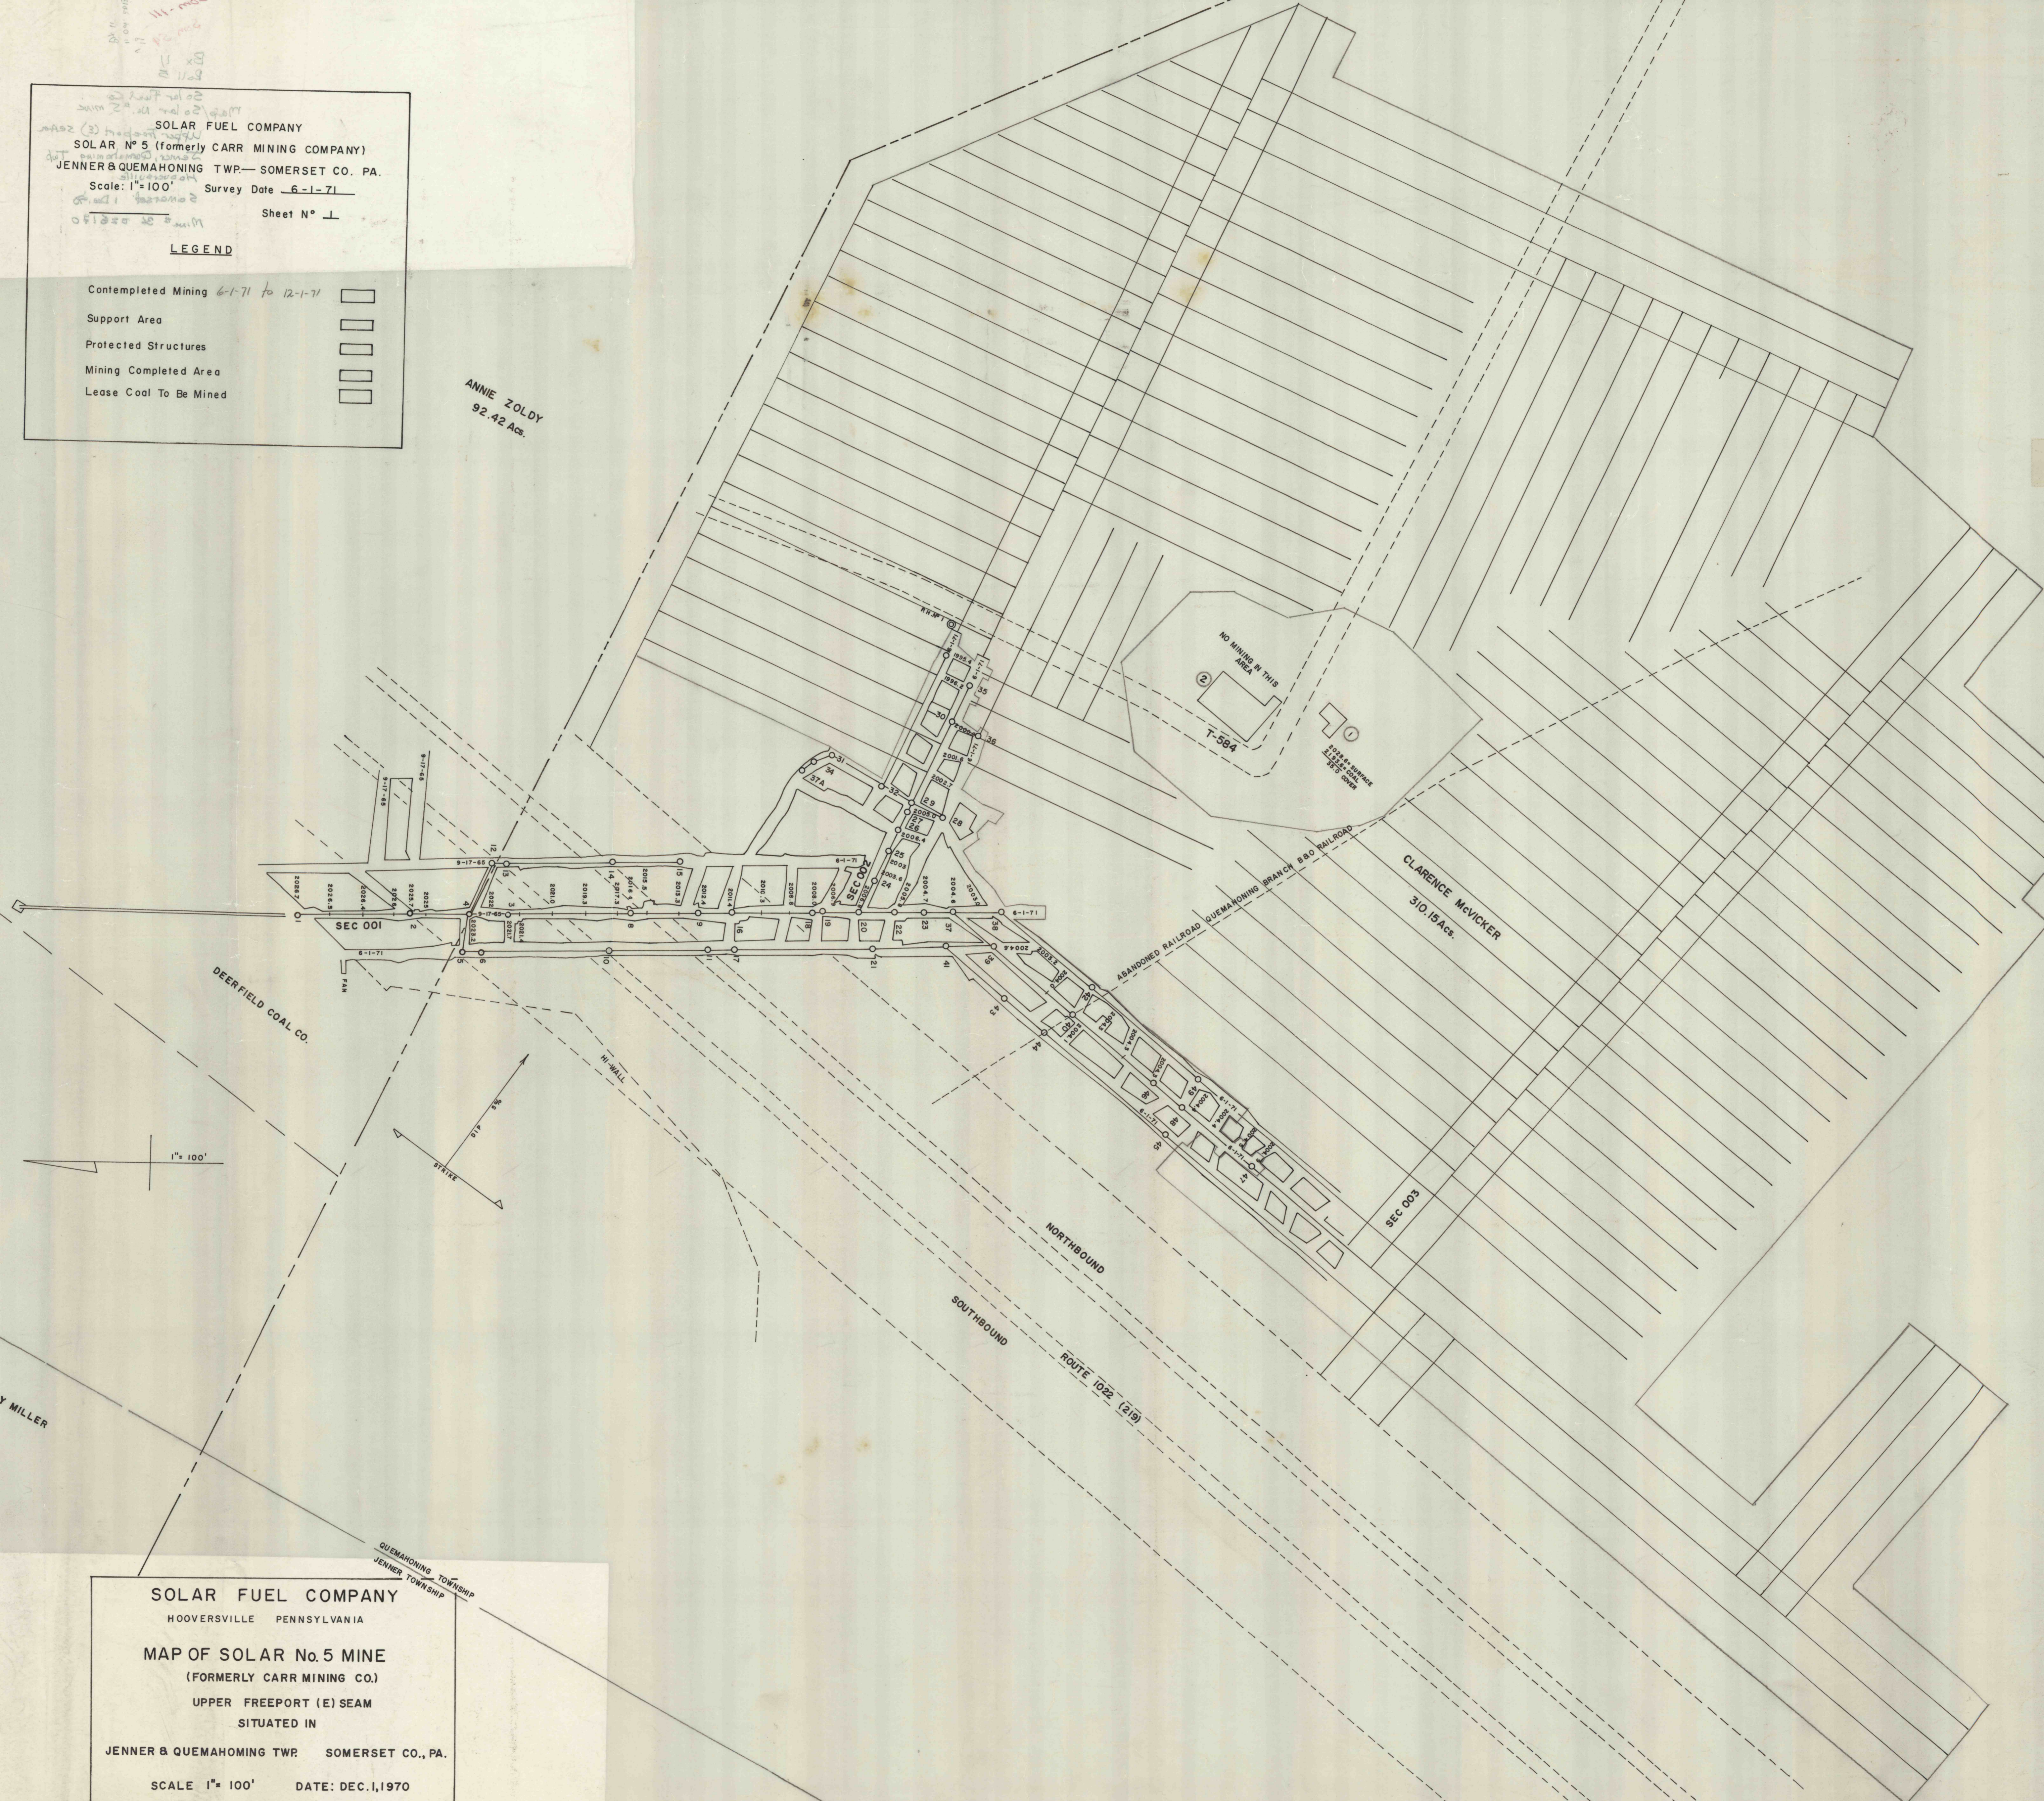

SOLAR FUEL COMPANY
 HOOVERVILLE PENNSYLVANIA
 MAP OF SOLAR No. 5 MINE
 (FORMERLY CARR MINING CO.)
 UPPER FREEPORT (E) SEAM
 SITUATED IN
 JENNER & QUEMAHONING TWP. SOMERSET CO., PA.
 SCALE 1"= 100' DATE: DEC. 1, 1970
 MINE NO. 36 026170

JAY MILLER

QUEMAHONING TOWNSHIP
 JENNER TOWNSHIP