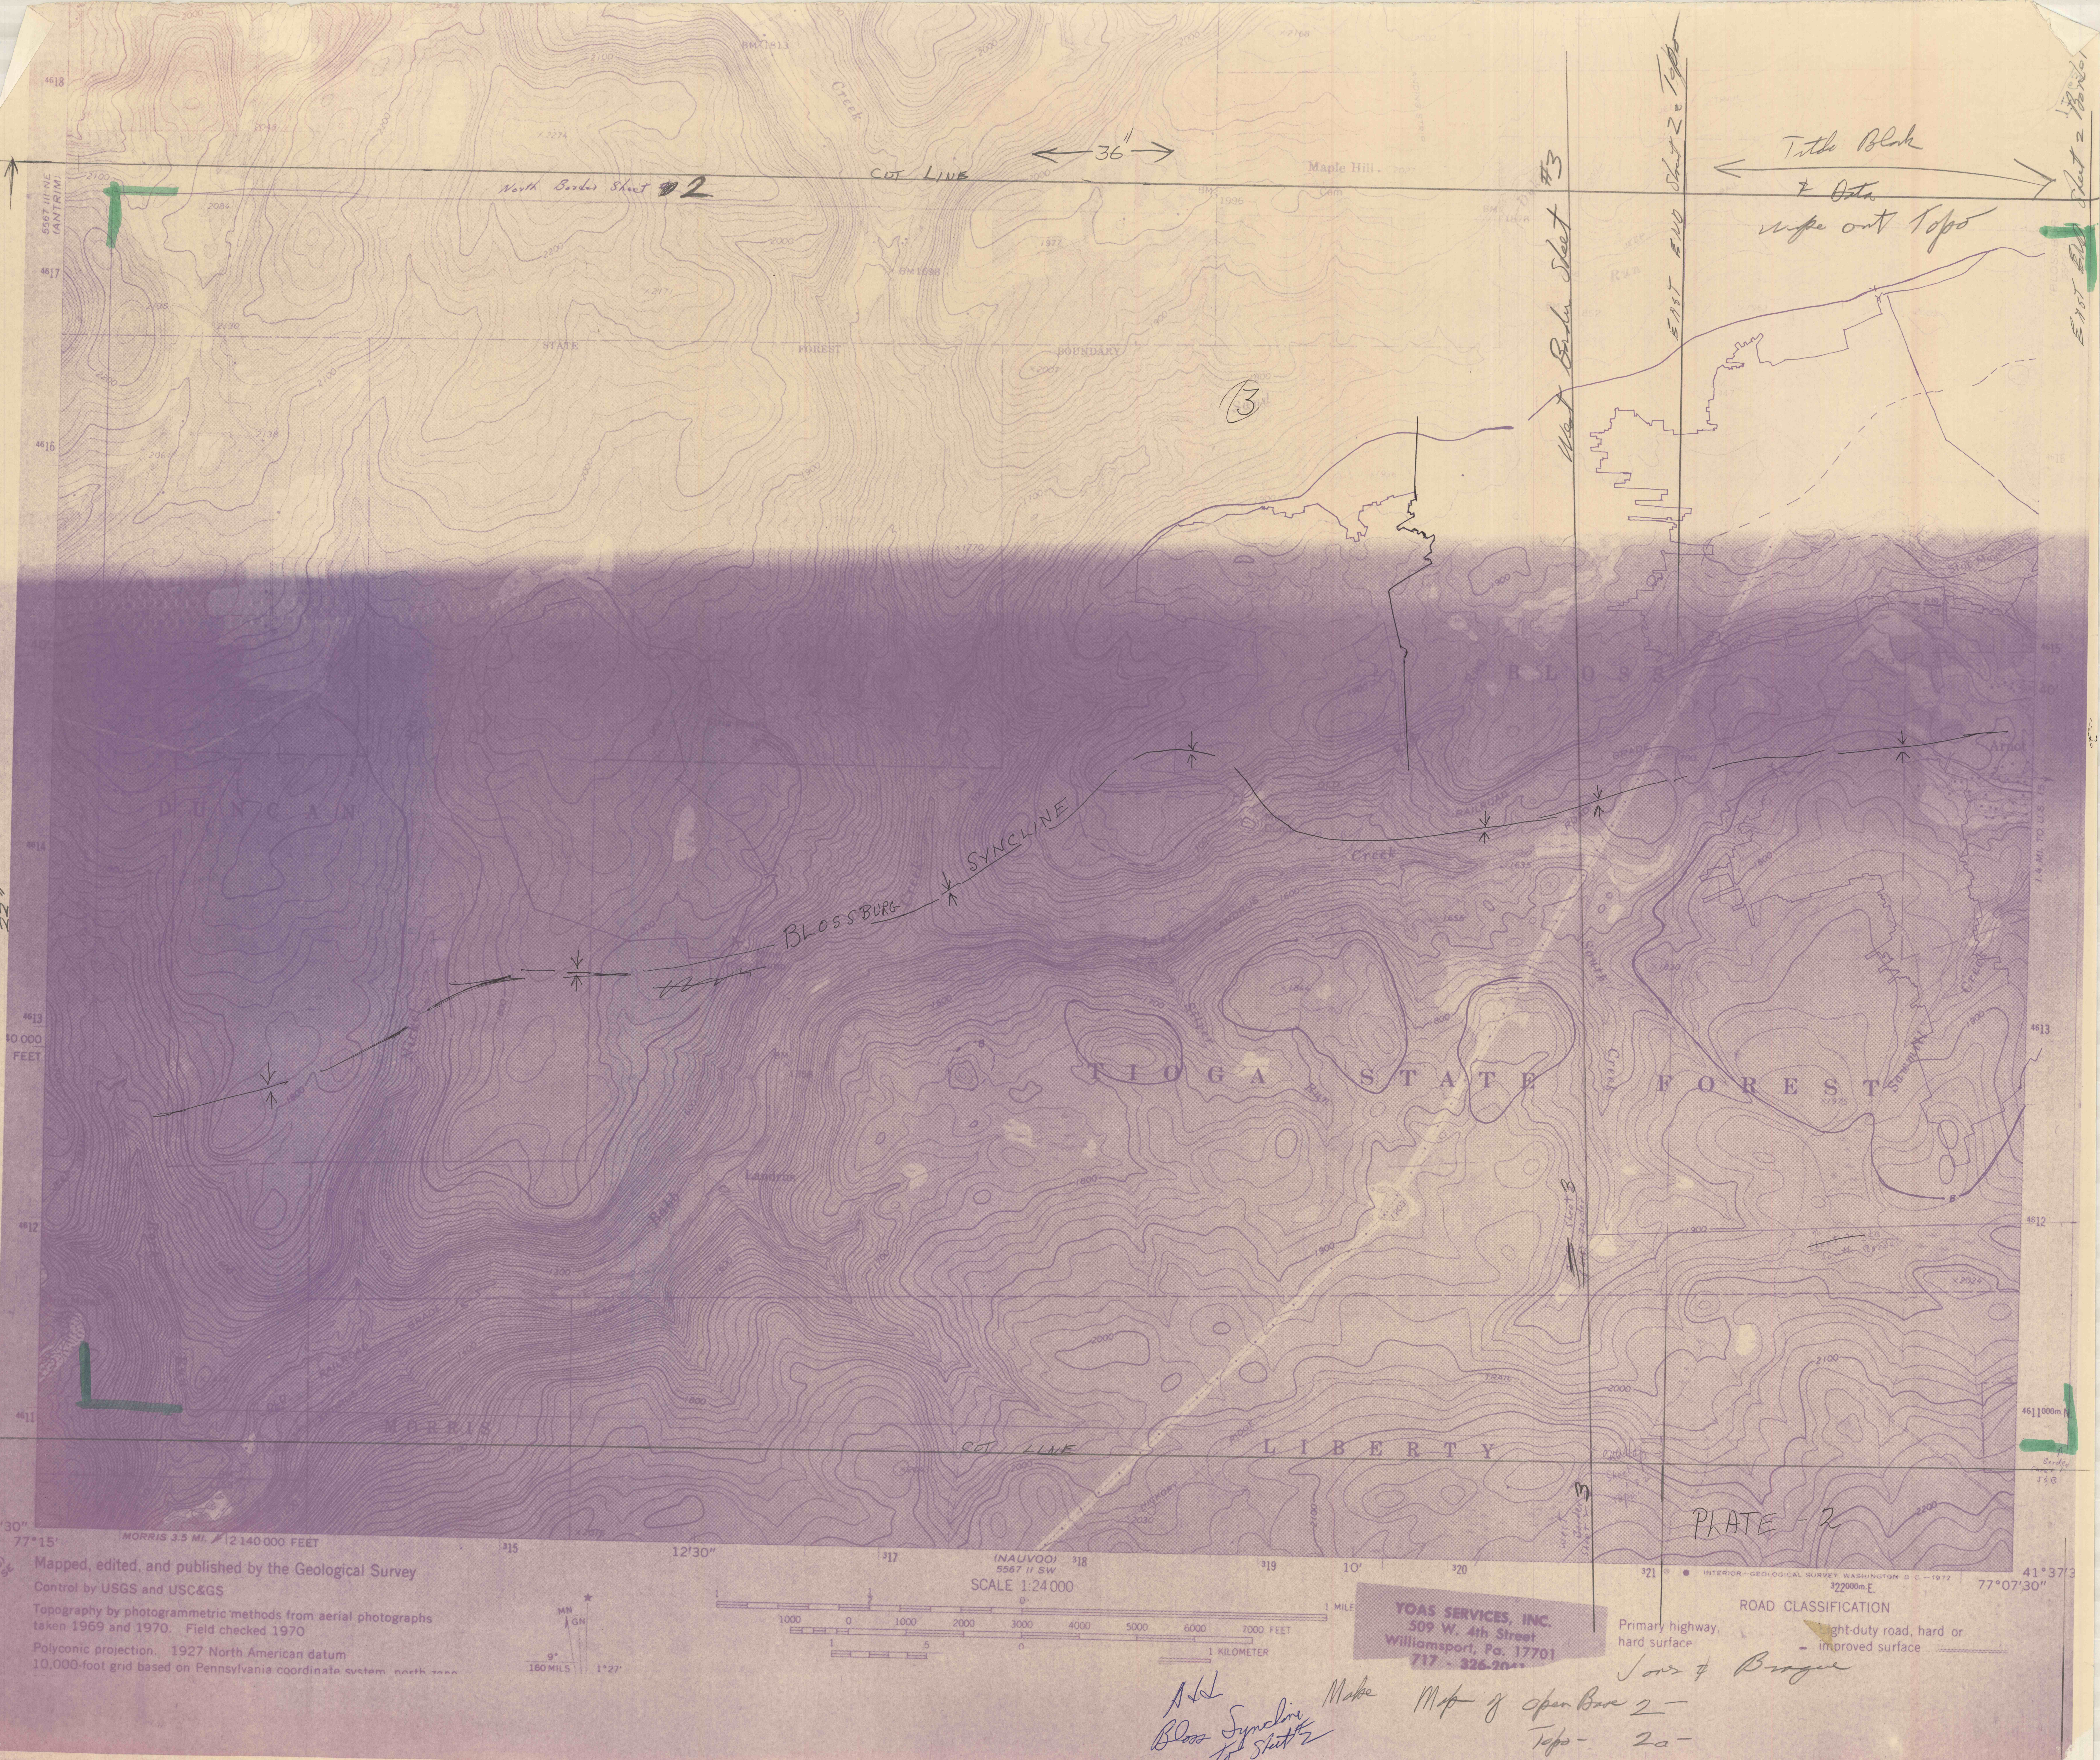

PLATE - 2
LIBERTY
MORRIS
TIOGA STATE FOREST
BLOSS
DUNCAN
BLOSSBURG SYNCLINE
CUT LINE
North Border Sheet #2
West Border Sheet #3
East End Sheet 2 & Topo
Title Block & Data
wipe out Topo
36"
Mapped, edited, and published by the Geological Survey
Control by USGS and USC&GS
Topography by photogrammetric methods from aerial photographs taken 1969 and 1970. Field checked 1970
Polyconic projection. 1927 North American datum
10,000-foot grid based on Pennsylvania coordinate system, north zone
SCALE 1:24 000
1 MILE
7000 FEET
1 KILOMETER
(NAUVOO)
5567 II SW
MORRIS 3.5 MI.
2 140 000 FEET
77°15'
12'30"
10'
77°07'30"
41°37'30"
322000m E.
4611000m N.
ROAD CLASSIFICATION
Primary highway, hard surface
Light-duty road, hard or improved surface
INTERIOR—GEOLOGICAL SURVEY, WASHINGTON, D. C.—1972
YOAS SERVICES, INC.
509 W. 4th Street
Williamsport, Pa. 17701
717 - 326-2041
Add Bloss Syncline to Sheet #2
Make Map of Open Base 2 —
Topo — 20 —
Jones of Bragues
5567 III NE
(ANTRIM)
1.4 MI. TO U.S. 15
Maple Hill