


Bear Creek Coal  
Area I thickness  
177 acres 18" - 187,110 tons  
Area II thickness 18" - 62,480 tons  
Area III 35 ac. 12"

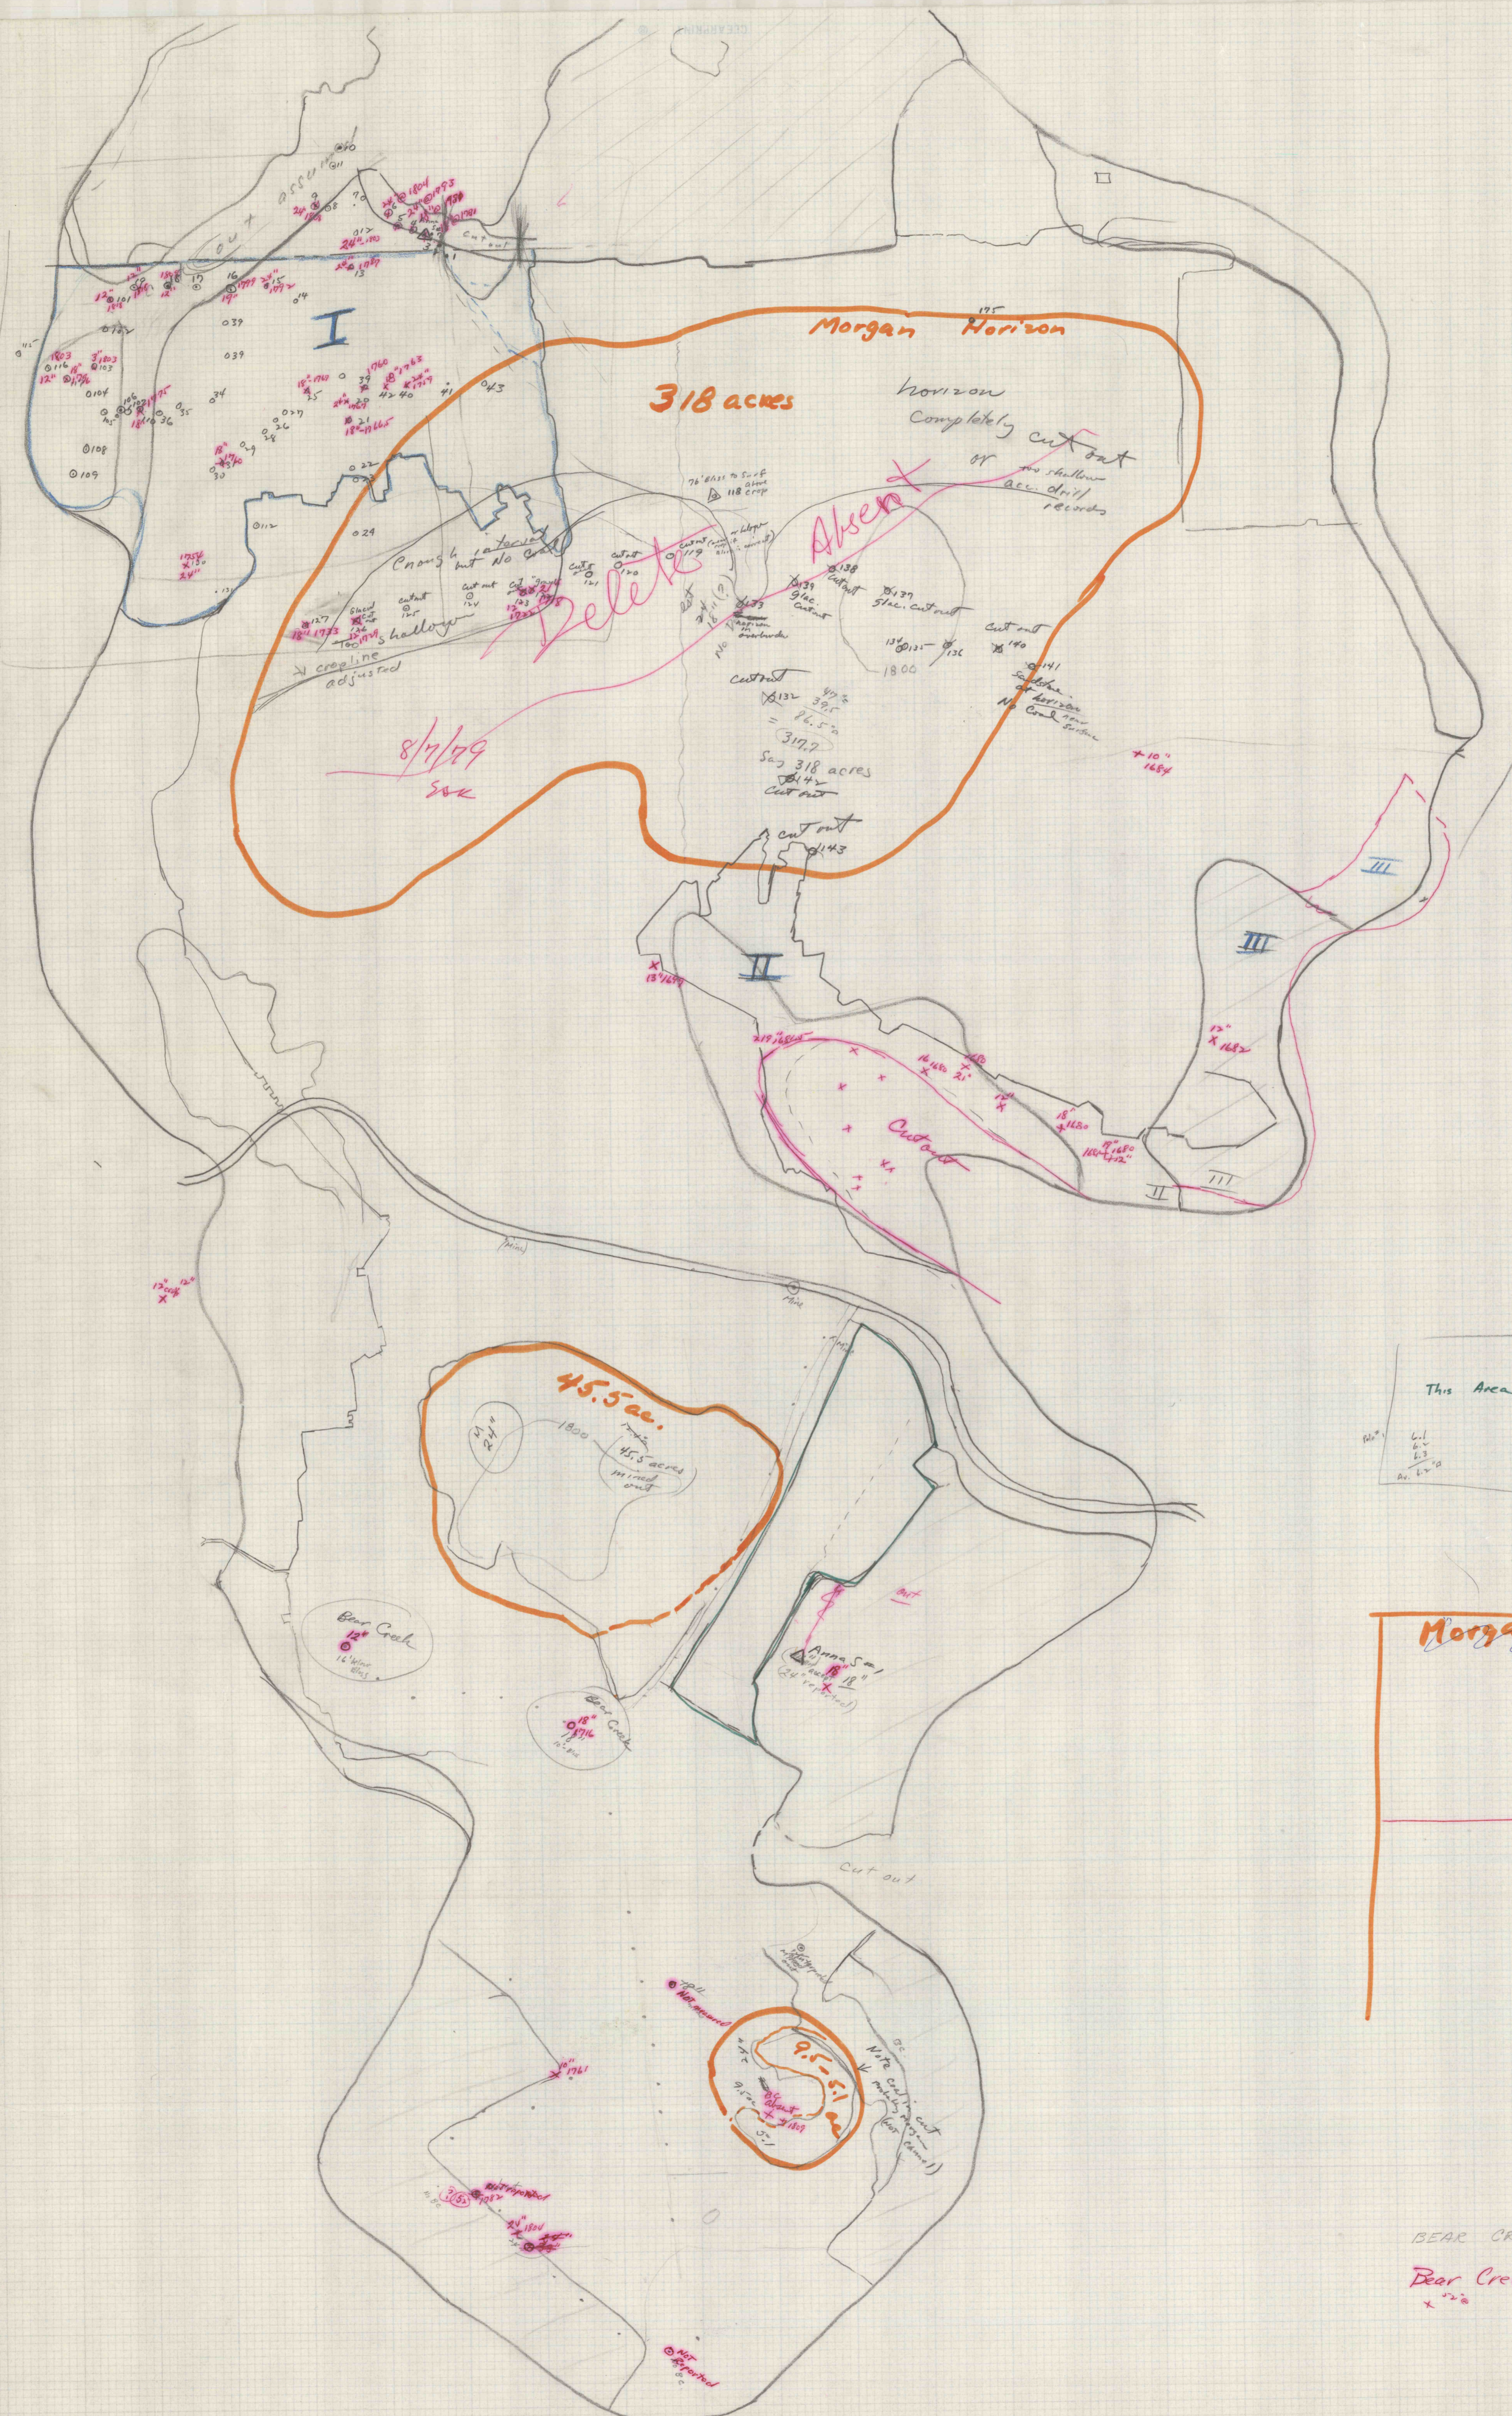

Block 2  
This Area consider as BLOSS + Bear Creek  
42" x 2" 18"  
22.7 Acres 25,790 tons 55,160 tons  
9/22/79 SAC

**Morgan - Acres - 373**  
Stripped - Cut out 50.6 x 18" 163,944 tons  
Southern 4.4 ac. 14,262 tons  
Northern area -  
No records -  
Crude est @ 18" x 318 ac = 991,740 Tons

BEAR CREEK COAL  
Bear Creek thicknesses  
x 18"