





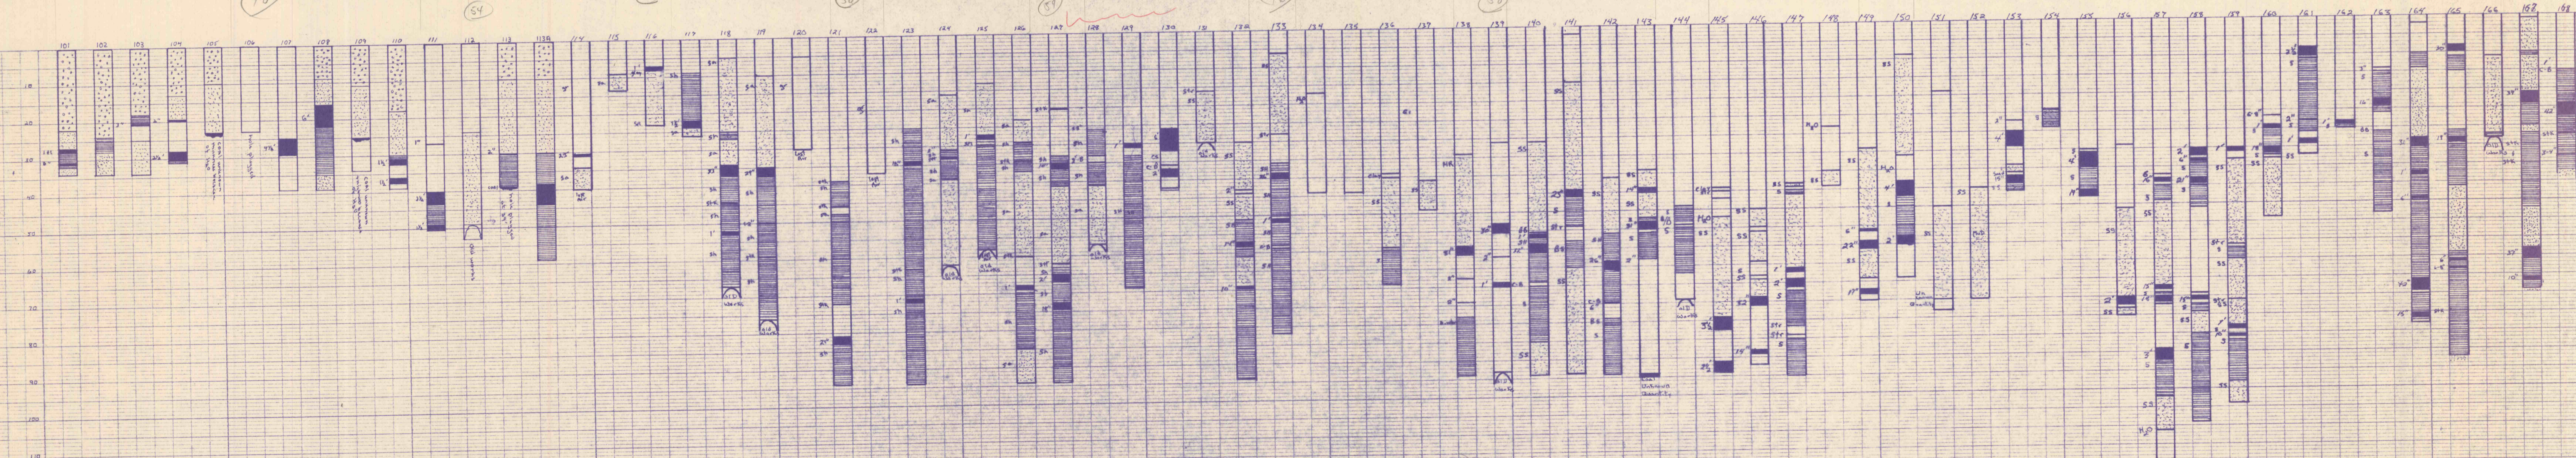

NPSEG COAL EVALUATION
 S & S Coal Company
 Anna S Complex
 Test Hole Profiles
 Vertical Scale 1" = 30 feet
 Prepared July-August 1974
 under the direction of

Byron R. [Signature]