


Jones Mine

Morris Run.

Dec. 31st 1866.
Scale: 200 ft to an inch.

No. 1

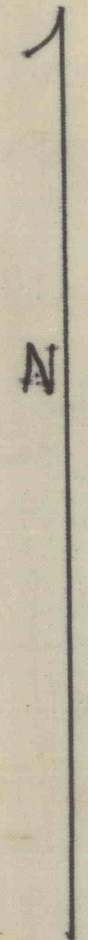

furnace where coal was burned for ventilation

WARRANT LINE N. 8° E.

Handwritten signatures and notes at the bottom left corner.