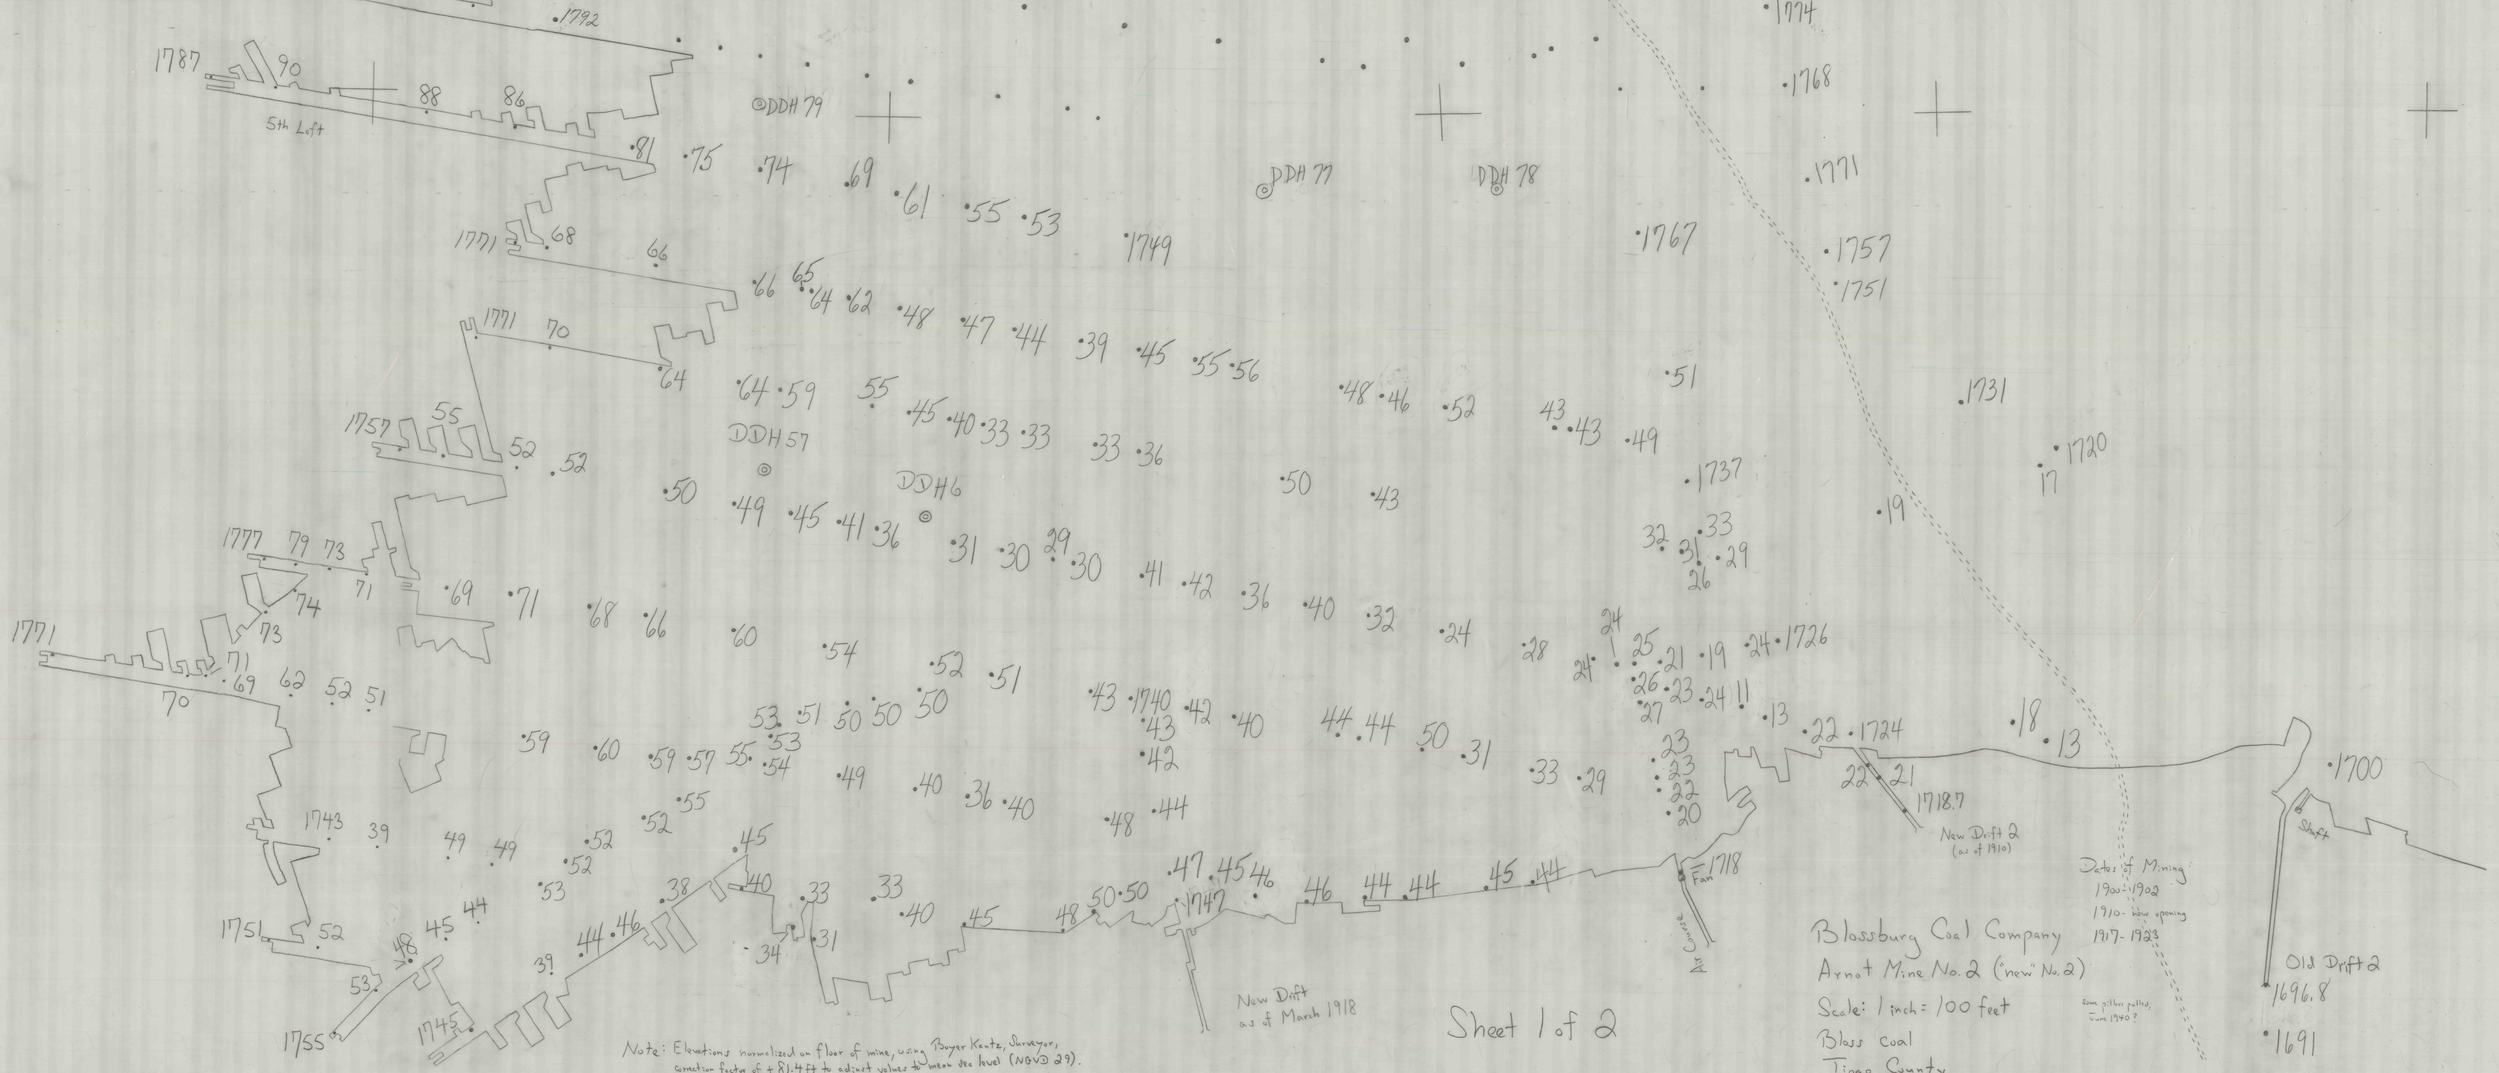
5th Left
DDH 79
DDH 77
DDH 78
DDH 57
DDH 6
New Drift 2
(as of 1910)
Dates of Mining
1900-1902
1910- New opening
1917-1923
Fan
Shaft
Old Drift 2
New Drift
as of March 1918
Blossburg Coal Company
Arnot Mine No. 2 ("new" No. 2)
Scale: 1 inch = 100 feet
Bloss coal
Tioga County
Sheet 1 of 2
Note: Elevations normalized on floor of mine, using Boyer Kautz, Surveyor, correction factor of +81.4 ft to adjust values to mean sea level (NGVD 29).