


BLOSSBURG COAL COMPANY
INSURANCE MAP
ARNOT #68

ARNOT, - TOGA COUNTY, - PENN.
Peabody Coal Co., Eng Dept., Chicago, Ill.

Scale: - 1"=200' Sept. 21, 1922.

REVISED JUNE 15-1927
REVISED JUNE 7-1929
REVISED JUNE 27-1931

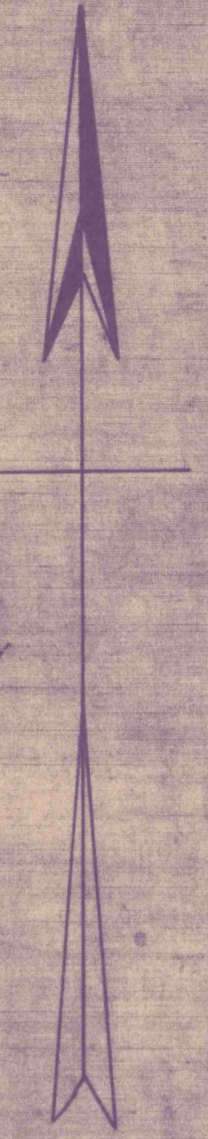

HOSE REEL HOUSE	M-39	} DESTROYED BY FIRE JULY 8-1930
POST OFFICE	M-45	
STORE	M-46	
OFFICE	M-52	
ICE HOUSE	M-40	

NEW TOWN

SHANTY TOWN

KLONDYKE

SLAB TOWN

COVE TOWN

CASTLE GARDEN

← No 2 MINE BUILDINGS →

→ No 5 MINE BUILDINGS →

TO MAPLE HILL
TO WELLSBORO

TO No 5 DRIFT

TO BLOSSBURG

TOGA DIV. ERIE R.R.

TOGA DIV. ERIE R.R.

← No 2 MINE BUILDINGS →

- FAN HOUSE M-60
- MINE FOREMANS OFF. M-55
- SAND HO. & CAP. Ho. M-56
- SUPPLY Ho. M-60A

→ No 5 MINE BUILDINGS →

- MULE SHED M-23
- STONE DUMPER SHANTY M-24



6-5-8

SLAUGHTER HOUSE M-40

S-D-6