

BLOSSBURG COAL Co.  
53 ft

B.H. No. 5

GOLDEN'S DRIFT

B.H. No. 4

LINDIE DRIFT

GOLDEN BROS.

MONUMENT

B.H. No. 3


B.H. No. 1

B.H. No. 2

WATER CO.



SCALE 1" = 500'

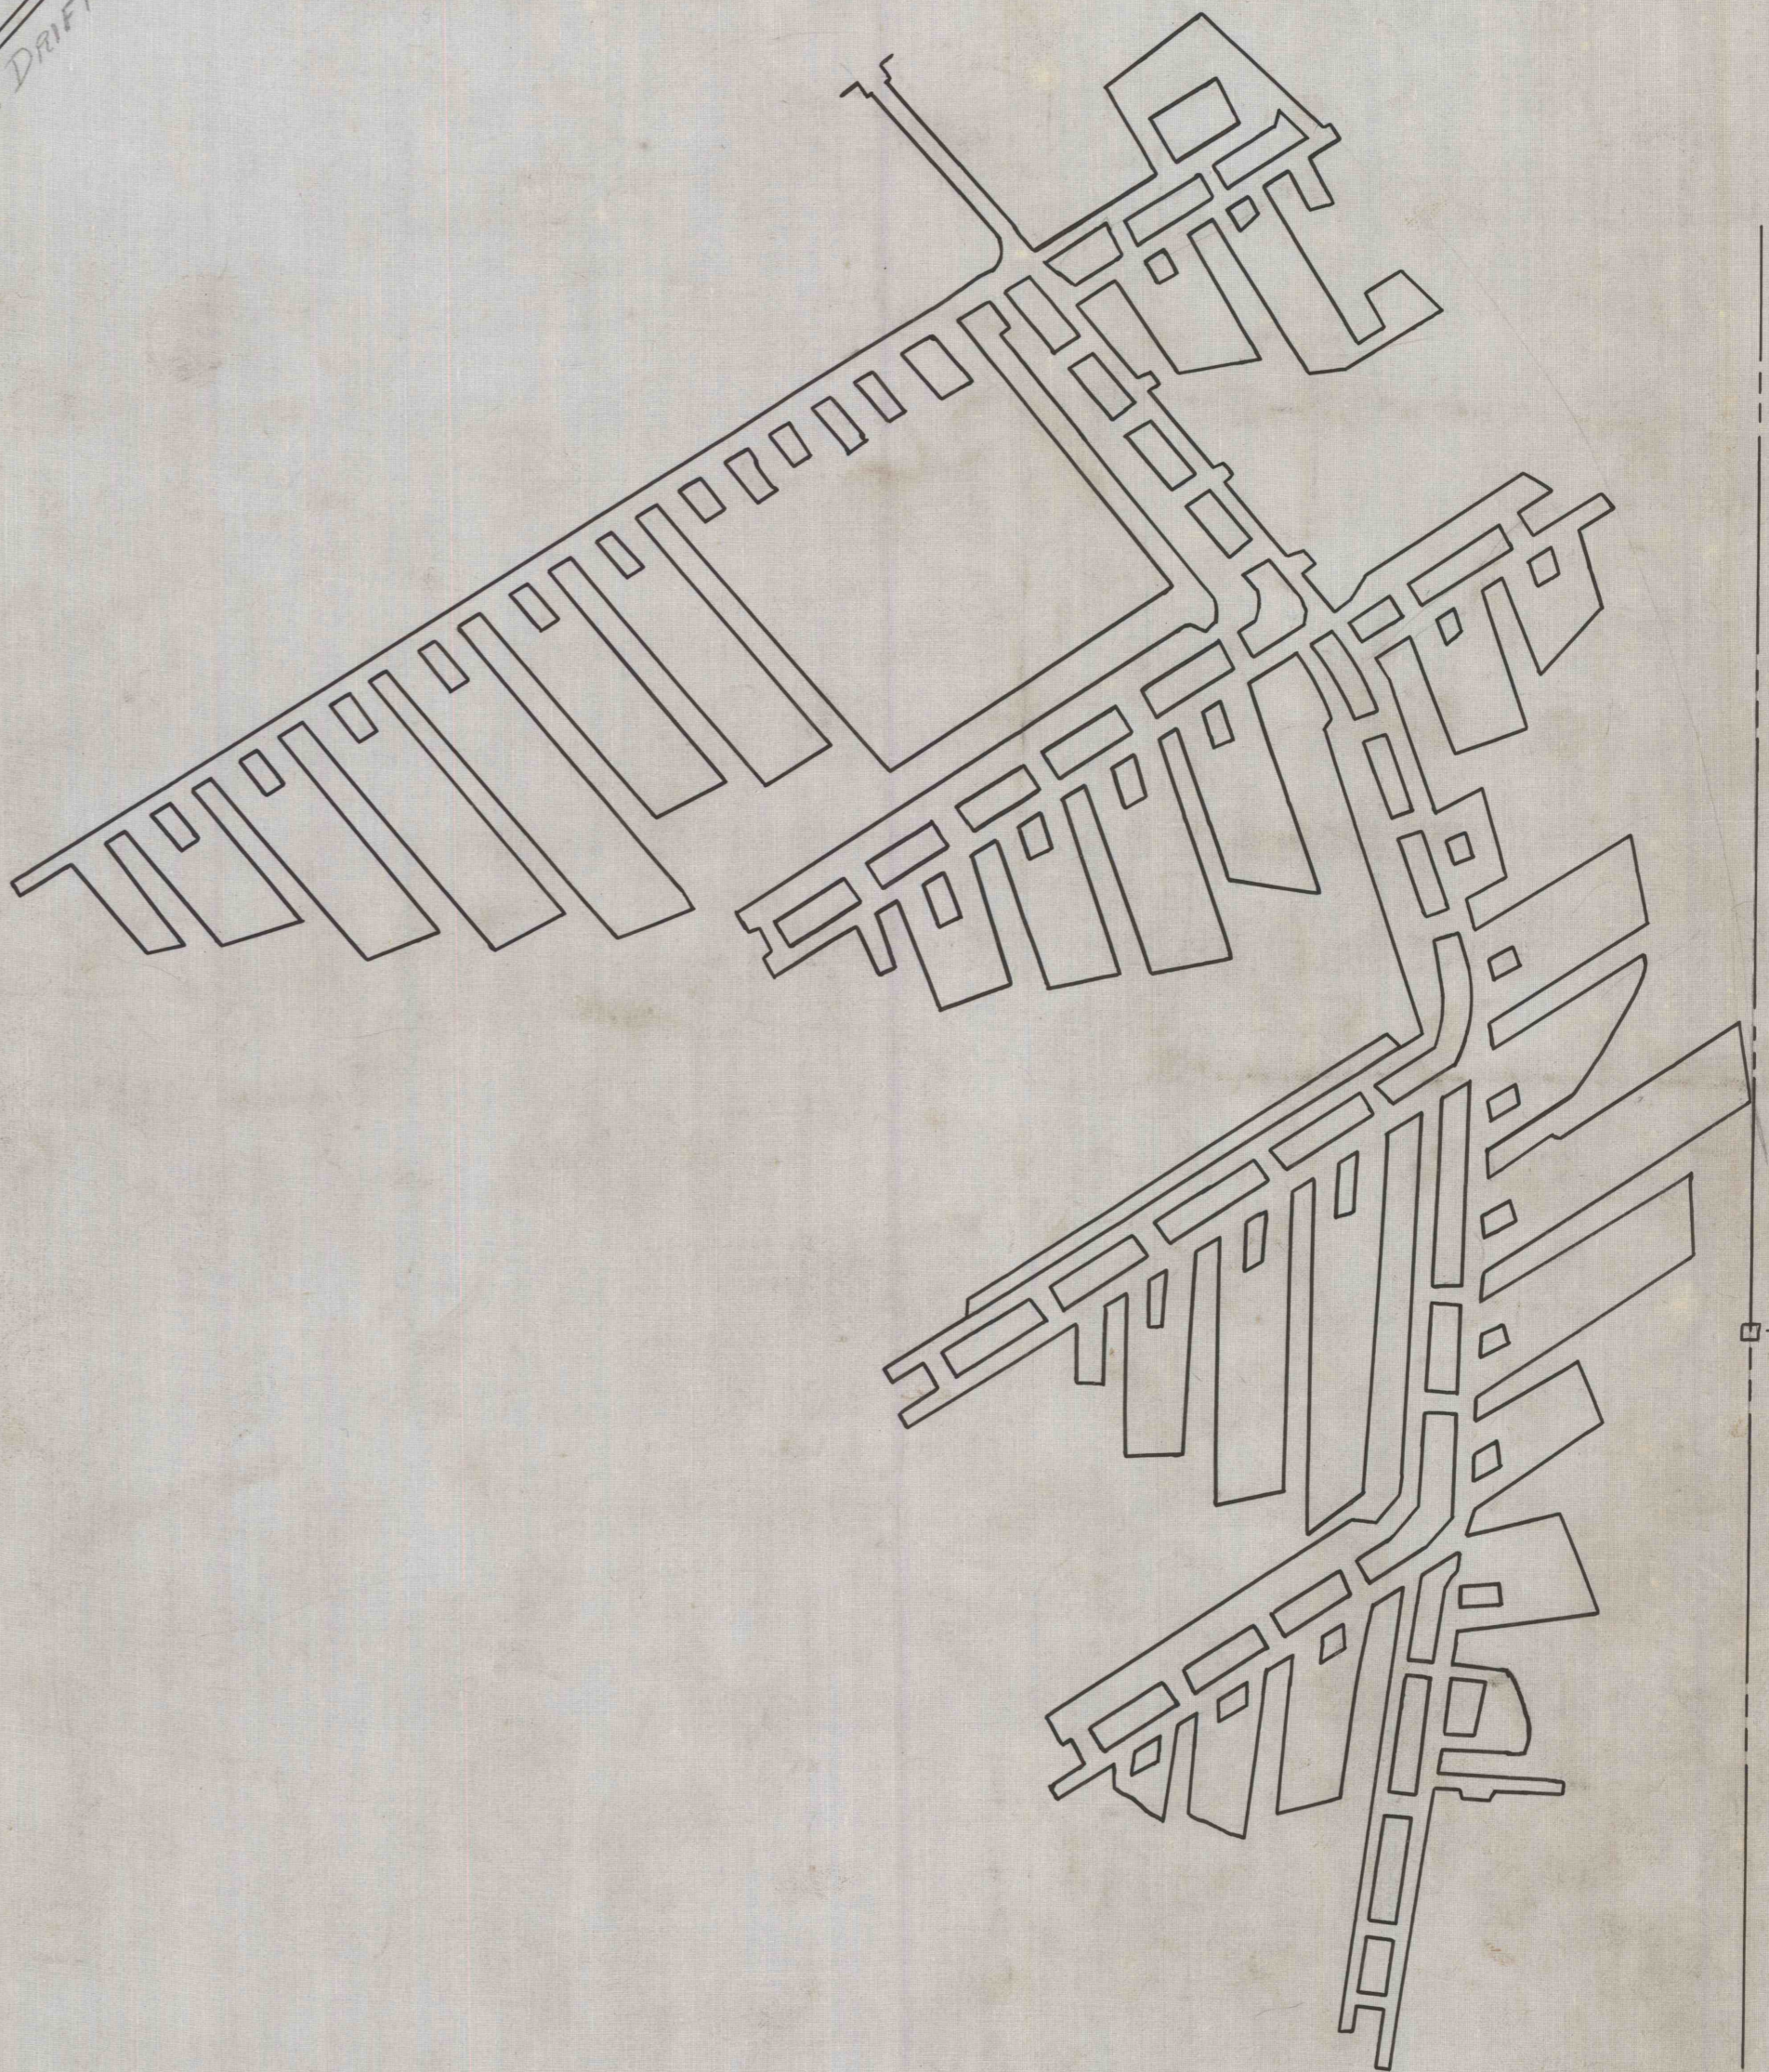

GOLDEN BROS.

WATER CO.

LOT No. 6  
207 ft

LOT No. 5  
207 ft

LOT No. 4  
207 ft

LOT No. 3  
207 ft

LOT No. 2  
207 ft

LOT No. 1  
207 ft

8400'

8400'

1005

LOT No. 1






### BLOSS VEIN COAL Co.

MEREDITH MINE

SCALE 1" = 100'

COPIED FROM  
PRINT  
FURNISHED BY  
E. H. GREEN,  
WELLS BORO, PA.