


400 FT

400 FT

400 FT

400 FT

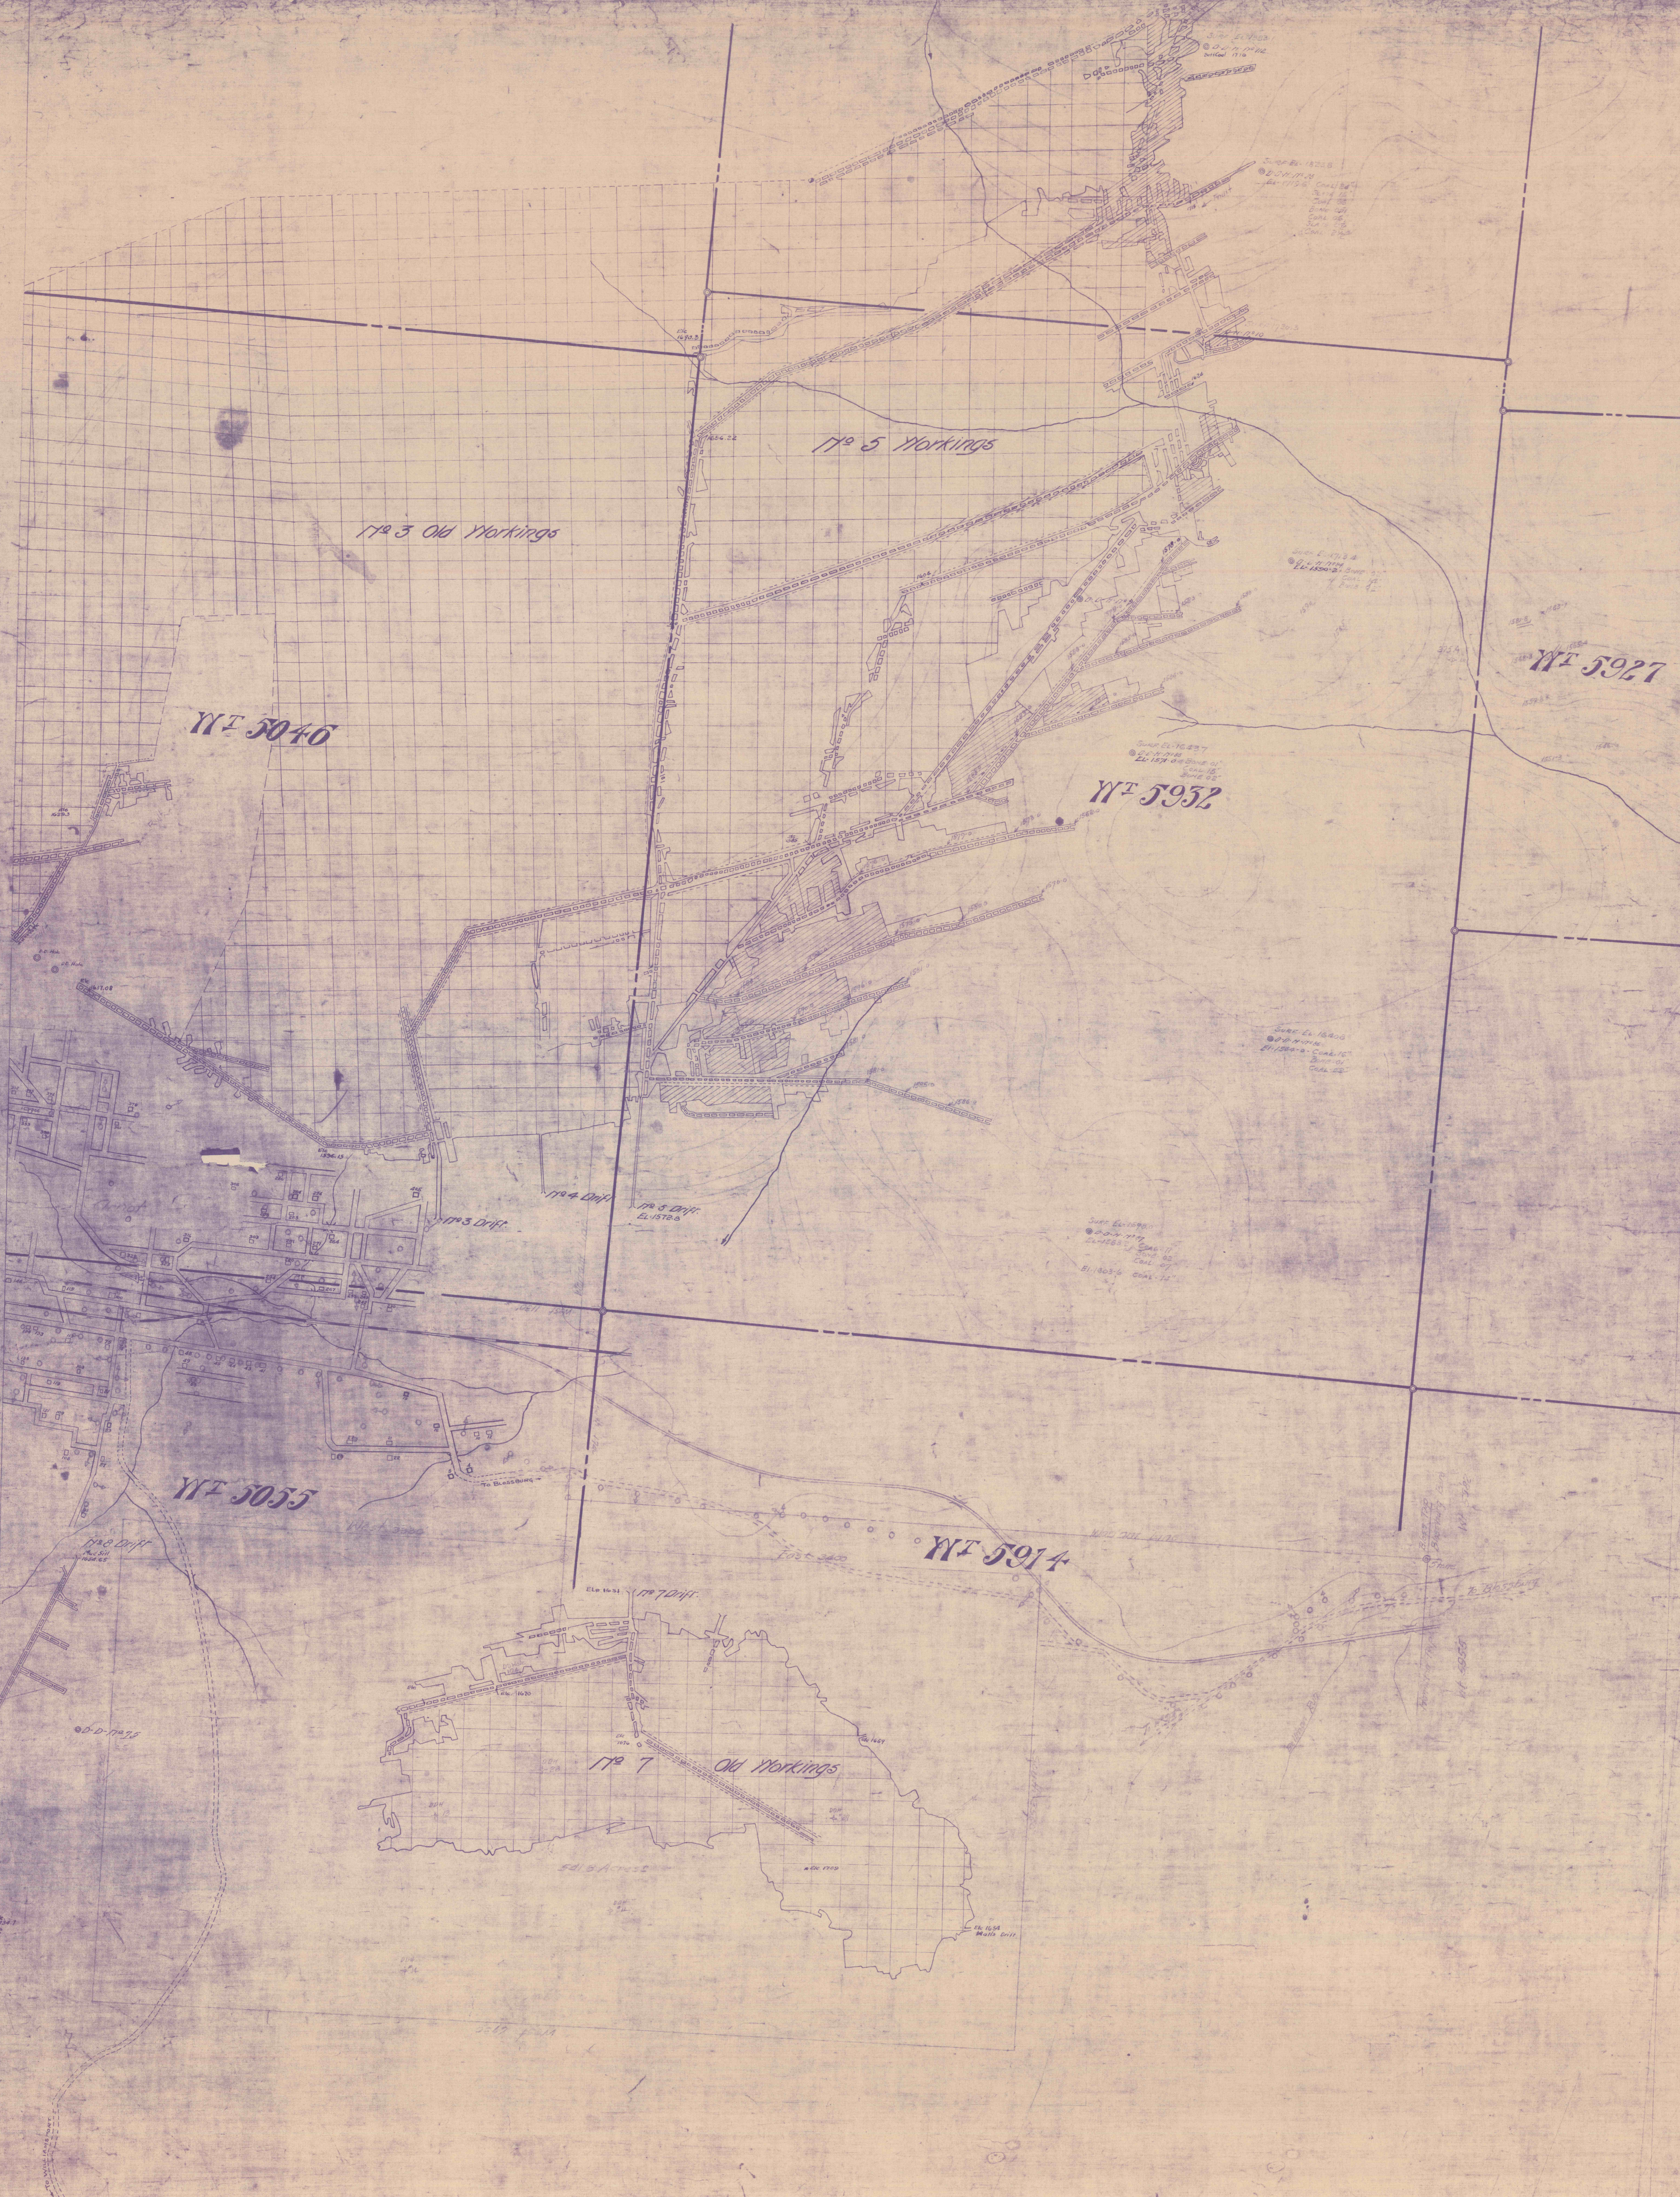


179 5 Workings

179 3 Old Workings

WT 5927

WT 5932

WT 5055

WT 5914

179 7 Old Workings