


L. Harrison's Shaft  
Surface - 1820  
Bot. Coal - 1820  
1817-18

STONE MOUNTAIN

ROAD  
10+55 YKT. LINE

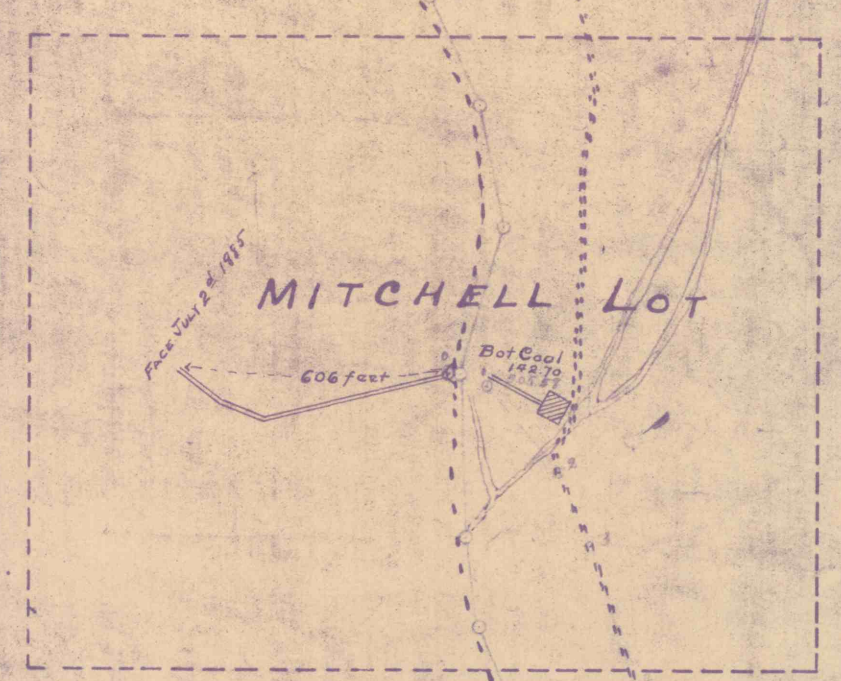

MITCHELL LOT

ANNA'S MINE

**4224**

68<sup>0</sup> Acres of Coal  
Less 28 " in Mitchell Lot

B.C.C. DDH #3  
Surface - 421.67  
Bot. Coal - 420.22

B.C.C. DDH #4  
Surface - 436.17  
Bot. Coal - 420.22

B.C.C. DDH #2 (Not in Bache's)  
Surface - 422.83  
Bot. Coal - 430.70

B.C.C. DDH #7  
Surface - 583.69  
Bot. Coal -

(This location abandoned)  
B.C.C. DDH #7  
Surface - 566.15  
Bot. Coal -

B.C.C. DDH #1  
Surface - 530.00  
Bot. Coal - 536.11

E.S. 77.12  
D.O. 16.00  
6.12 Stmt of Coal  
M.H. 52.34  
52.79 Bot. Coal Stmt  
277+29 - W.C.L. line

S 85 1/2 E 439.24  
411.84

E.S. 42.51  
D.O. 0.02  
B.C. 43.29

E.S. 37.39  
D.O. 1.11 Bot. Coal 40.53  
Shof. #11 (old)

Surface - 531.17  
Bot. Coal -

27.4

65.87 rods

75+35 - W.C.L. line

212 Acres

Bache's Mine

Basswood Run

Road to Bache's Mine

B.C.C. DDH #6  
Surface - 433.71  
Bot. Coal - 535.71

E.S. 11.11  
D.O. 19.50  
35.68 Bot. Coal Stmt

B.C.C. DDH #5  
Surface - 444.31  
Bot. Coal - 557.81

Lo Jurel Swamp

**4345**

157 Acres

Bot. Coal 150.0  
T.C. 41.9

Bot. Coal 103.9  
T. Coal 2.9

Bore Hole  
D.O. 11.1  
D.O. 43.0  
Bot. Coal 10.3

E.S. 23.30  
D.O. 27.50  
B.C. 20.770

3 1/2' Coal  
1 1/2' Sifts  
10% Coal  
10% Stone  
6% Coal  
3'0"


PAINT RUN

WARRANT LINE

SOUTH FORK

27.4

N 85 1/2 W 441.6  
414.2

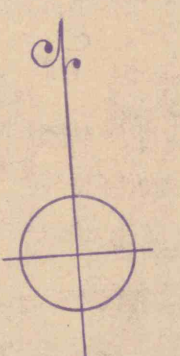

Scale - 1" = 400'

SKETCH  
OF  
BLOSSBURG COAL CO'S.  
EXPLORATIONS  
ON  
WARRANTS 4224 & 4345  
MAY & JUNE 1900  
SCALE: 1" = 400'  
1/2" = 100'