


L. Harrison's Shaft
FS 18820 Do. 28
Bot. Coal 14520
Feet 40

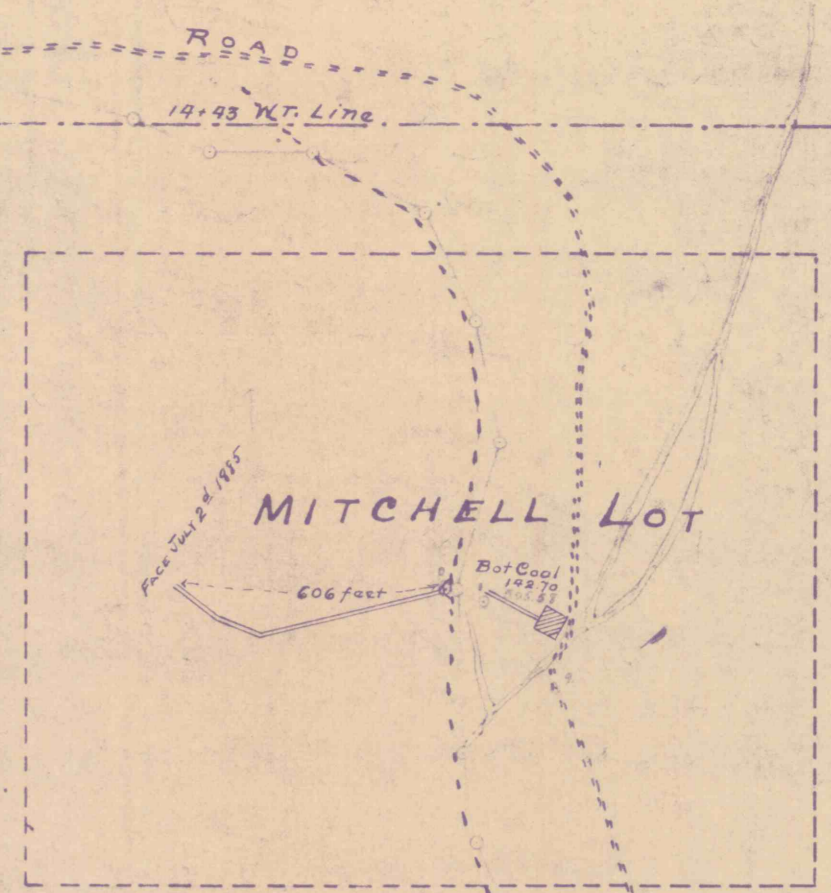

4224


68⁰⁰ Acres of Coal
Less 28 " in Mitchell Lot

212 Acres

4345

157 Acres

SKETCH
OF
BLOSSBURG COAL CO.'S
EXPLORATIONS
ON
WARRANTS 4224 & 4345
MAY & JUNE 1900
SCALE: 1" = 400'

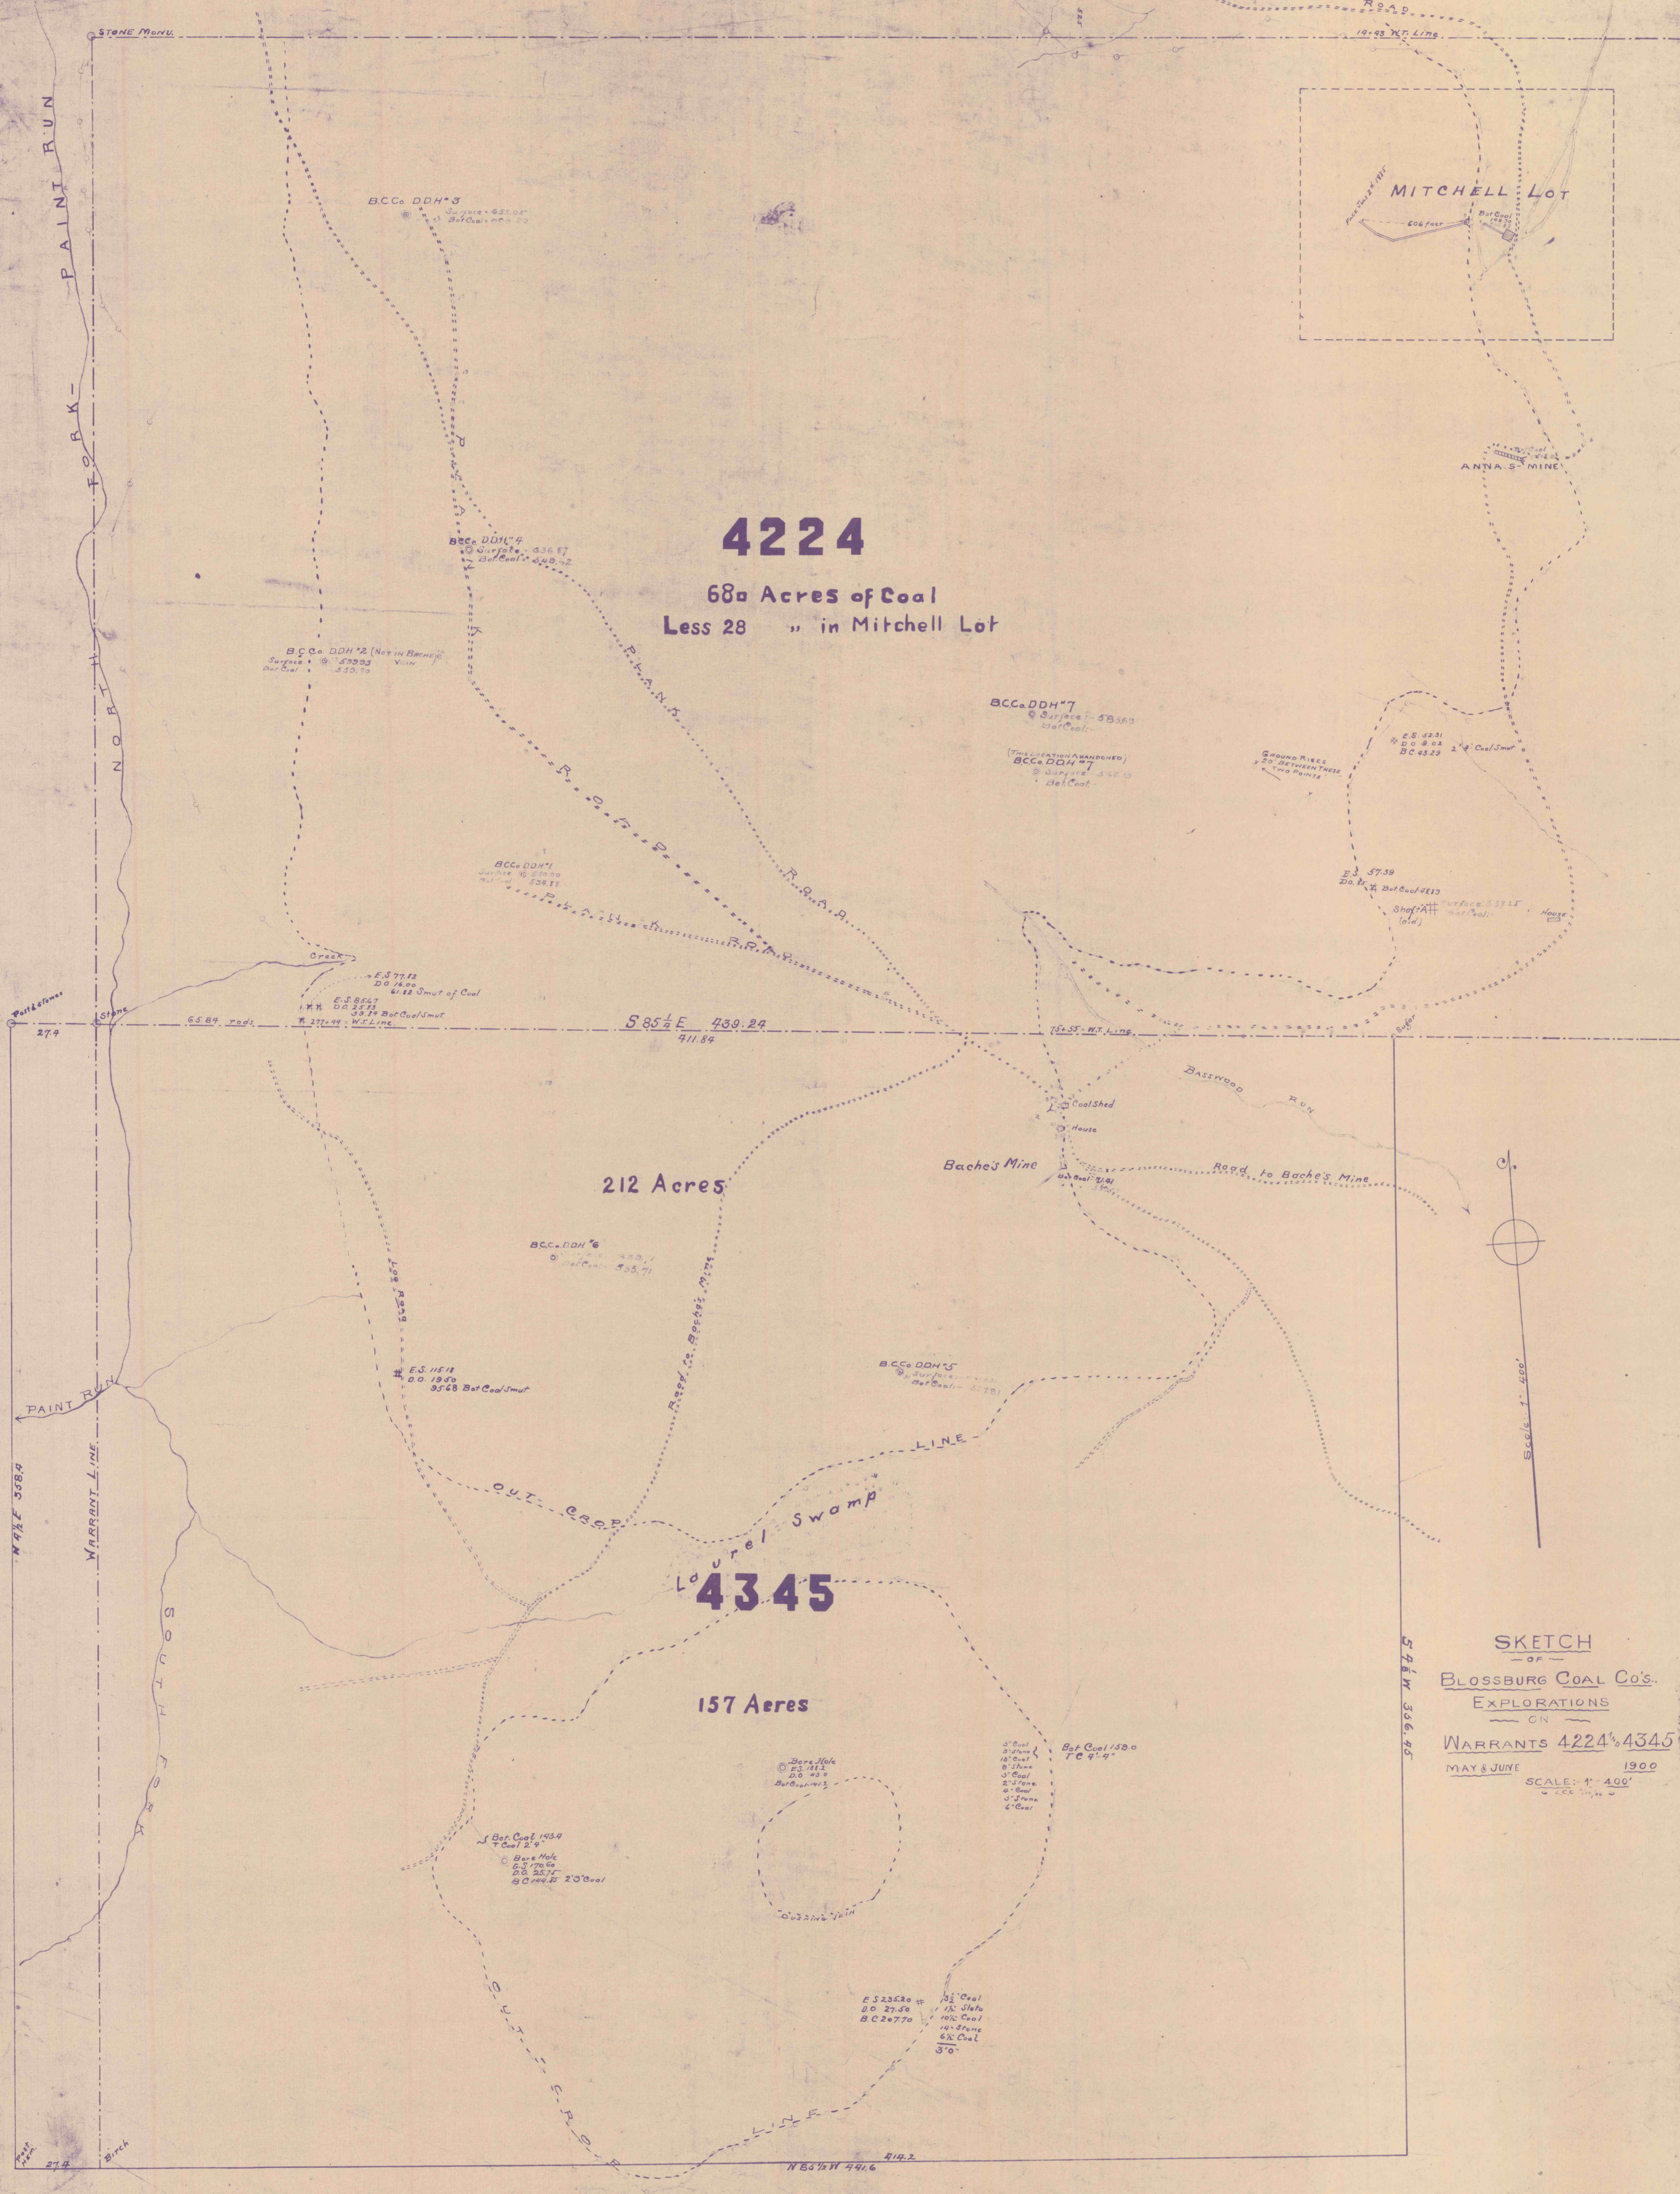

STONE MANU.
PAINT RUN
FORK
NORTH FORK
SOUTH FORK
WARRANT LINE
W. 1/2 W. 36.45

BCCo. DDH #3
Surface 621.04
Bot. Coal 600.22

BCCo. DDH #4
Surface 436.67
Bot. Coal 420.42

BCCo. DDH #2 (Not in Bache's)
Surface 599.93
Bot. Coal 559.70

BCCo. DDH #1
Surface 620.00
Bot. Coal 598.11

BCCo. DDH #7
Surface 523.60
Bot. Coal -

(THIS LOCATION ABANDONED)
BCCo. DDH #7
Surface 526.13
Bot. Coal -

E.S. 5231
D.O. 9.02
B.C. 4329
2' of Coal/Smut

E.S. 57.59
D.O. 2.11
B.C. Coal/4833

E.S. 77.12
D.O. 16.00
Bot. Coal/Smut
E.S. 82.27
D.O. 22.14
33.74 Bot. Coal/Smut
277.97 - W. Line.

S 85 1/2 E 439.24
411.89

Coal Shed
House

Bache's Mine

Road to Bache's Mine

BCCo. DDH #6
Surface 433.71
Bot. Coal 353.71

E.S. 115.14
D.O. 19.50
95.68 Bot. Coal/Smut

BCCo. DDH #5
Surface 627.00
Bot. Coal 627.01

Bot. Coal 150.0
70 4 7'

Bot. Coal 143.9
Coal 2.9
Bore Hole
D.O. 43.0
Bot. Coal 143.9

E.S. 235.80 #
D.O. 27.50
B.C. 207.70
3 1/2' Coal
1 1/2' Stone
14' Stone
6 1/2' Coal
3' 0"

N 85 1/2 W 441.6
414.2