


MAGNETIC

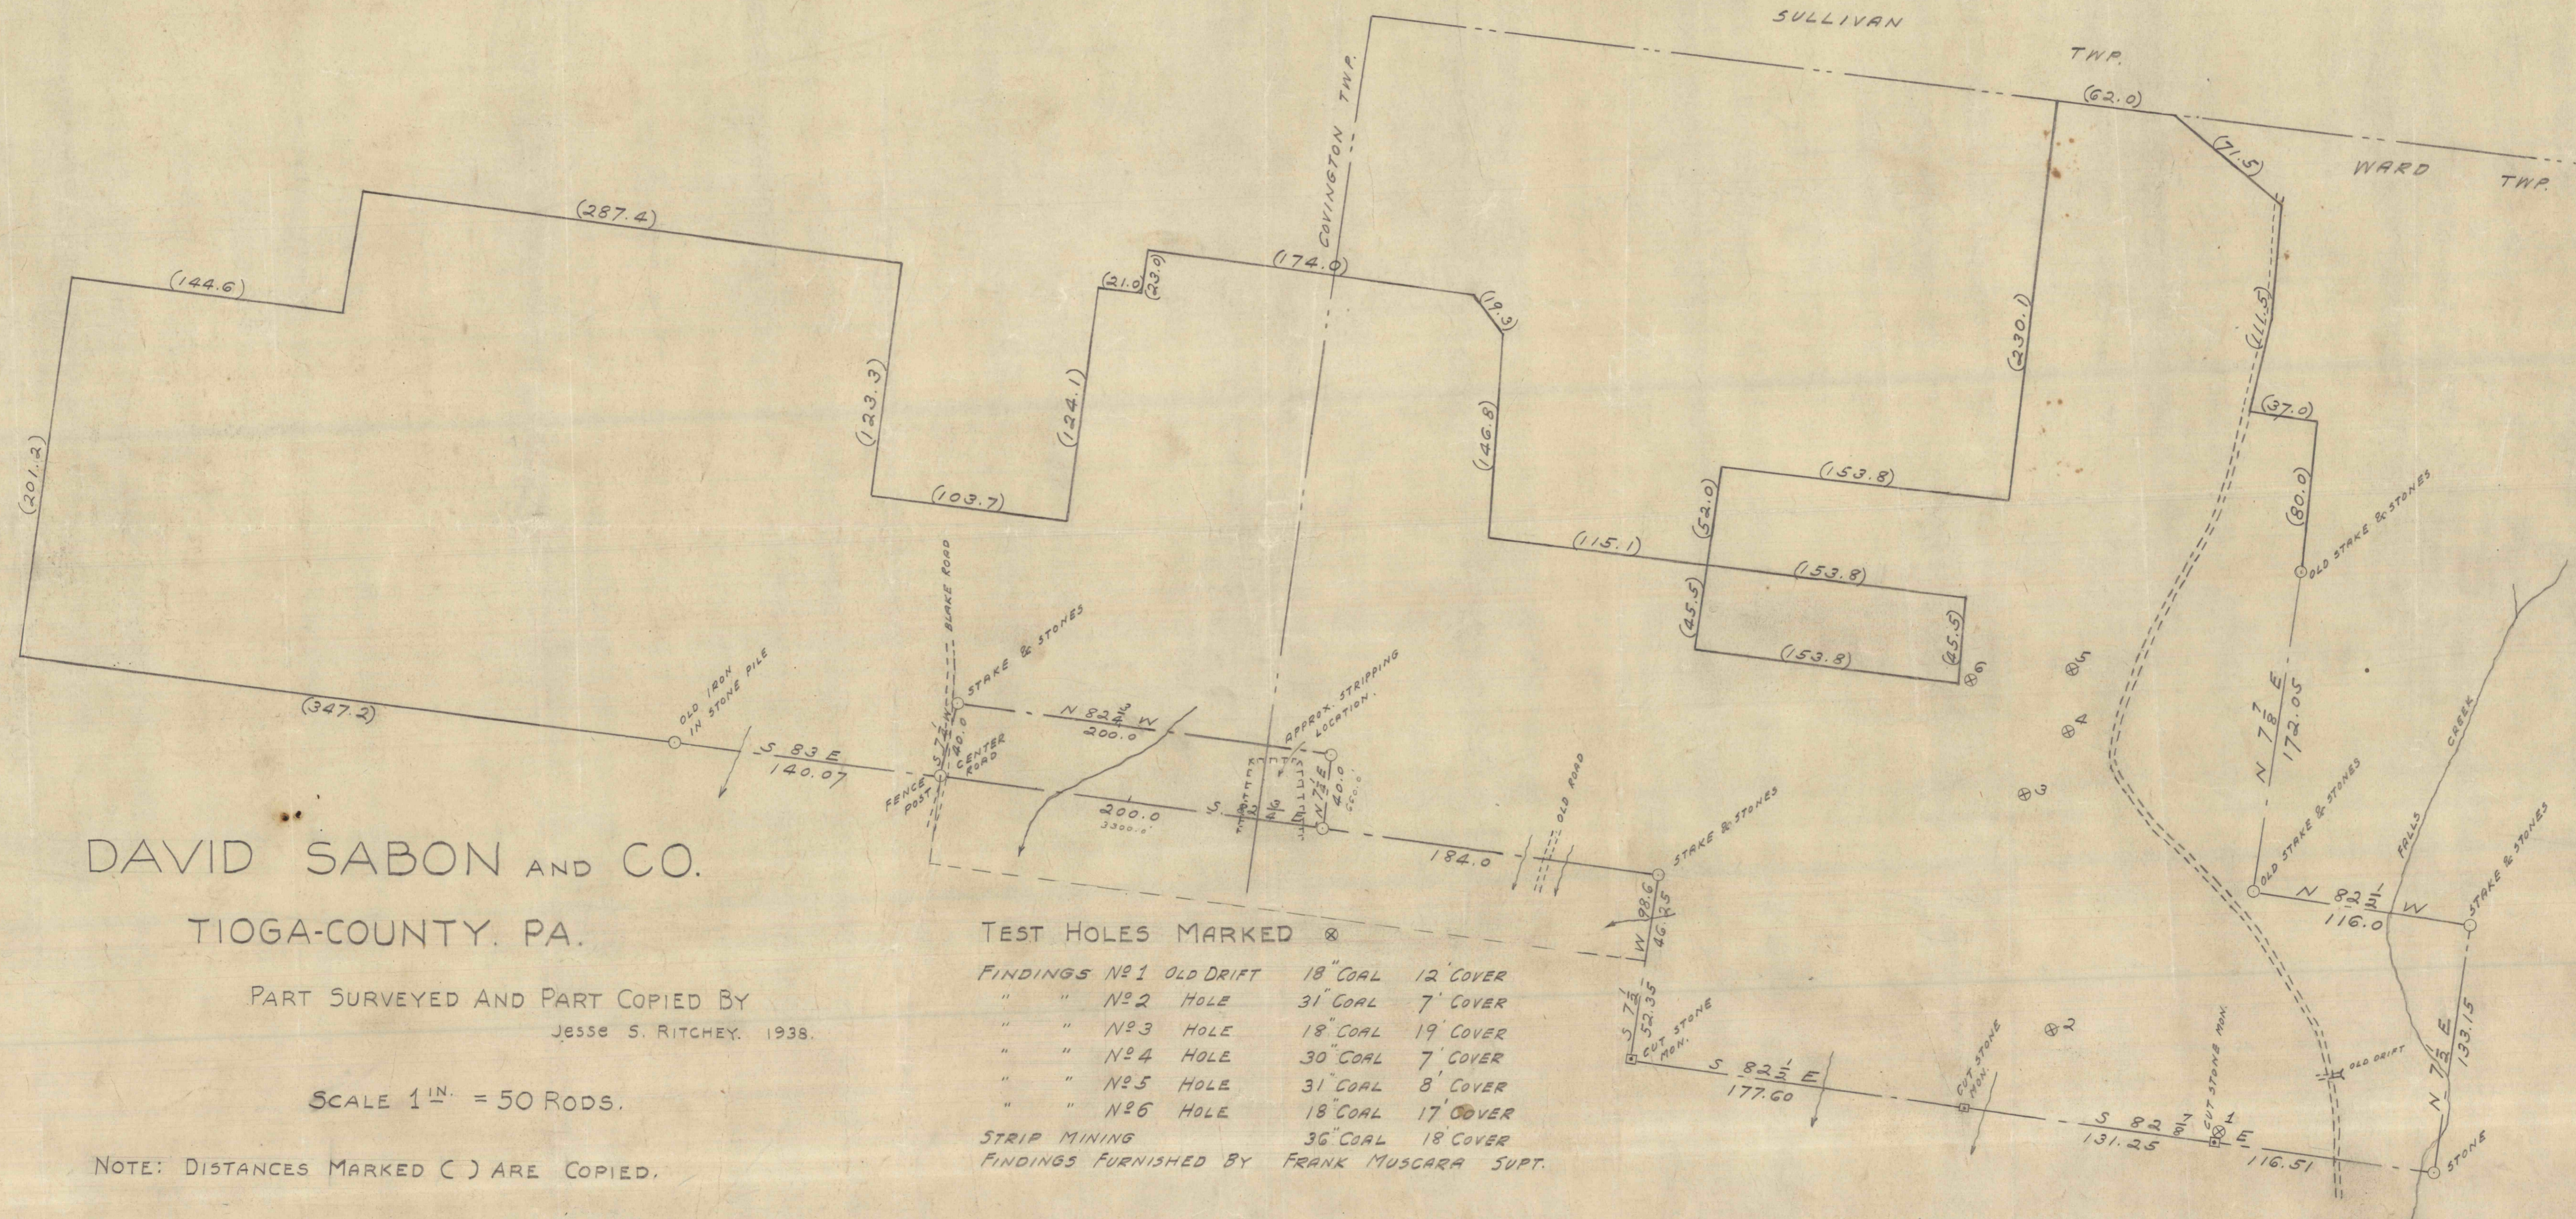

DAVID SABON AND CO.
 TIOGA-COUNTY, PA.

PART SURVEYED AND PART COPIED BY
 Jesse S. RITCHEY, 1938.

SCALE 1" = 50 RODS.

NOTE: DISTANCES MARKED () ARE COPIED.

TEST HOLES MARKED ⊗

FINDINGS NO 1	OLD DRIFT	18" COAL	12' COVER
" "	NO 2 HOLE	31" COAL	7' COVER
" "	NO 3 HOLE	18" COAL	19' COVER
" "	NO 4 HOLE	30" COAL	7' COVER
" "	NO 5 HOLE	31" COAL	8' COVER
" "	NO 6 HOLE	18" COAL	17' COVER
STRIP MINING		36" COAL	18' COVER

FINDINGS FURNISHED BY FRANK MUSCARA SUPT.