

E 5500

E 5000

E 4500

E 4000

E 3500

N 1500


N 1000

N 500

N 000  
5 000

5 5000

5 1000

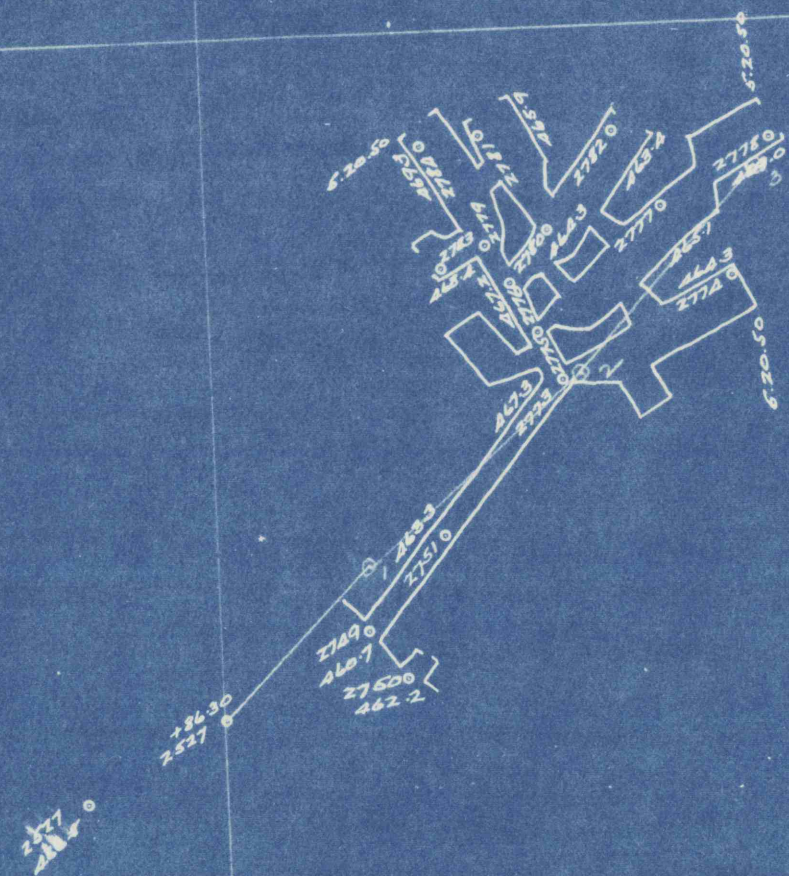

BOINSKI MINE  
WARD TOWNSHIP  
SCALE 1"=100'

SEYMOUR VEIN  
TIOGA COUNTY  
POSTED - MAY 20 1950.