





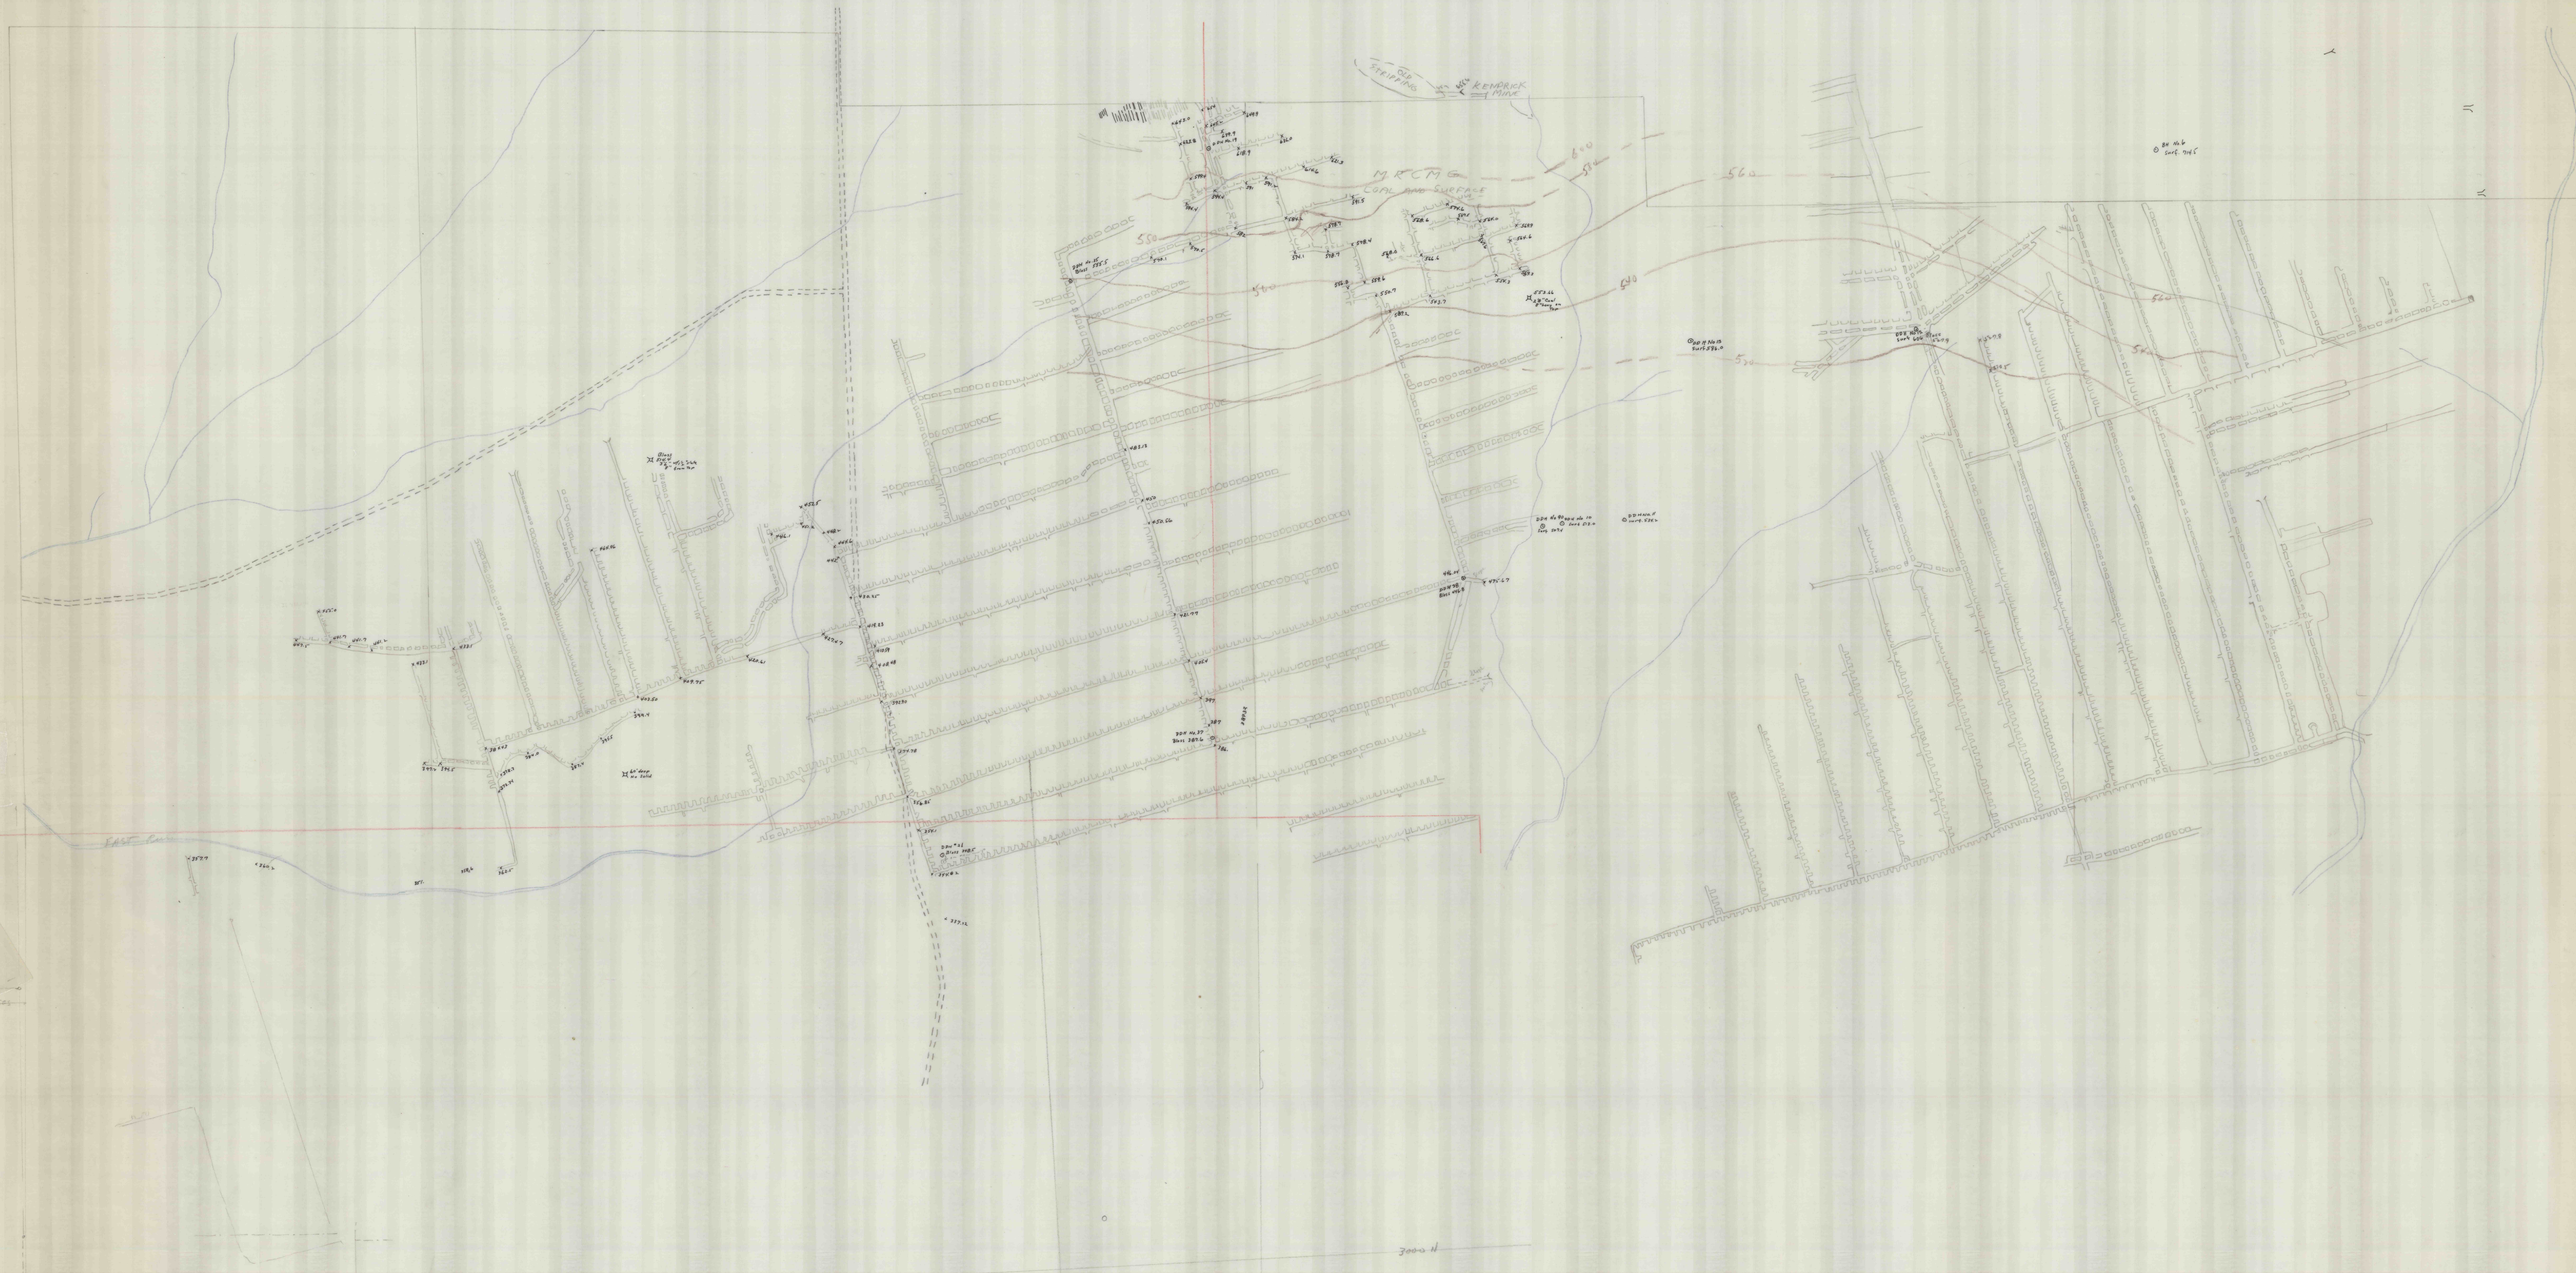

M.T.

MRCM
