

11 { B.H. +132'
SANDSTONE ROOF
BONE 15"
COAL 29 1/2"
BLACK SLATE 3 1/2"
FIRE CLAY

10 { B.H. +100'
BONE 9"
COAL 31"
BONE 6"
BLACK SLATE 3 1/2"
FIRE CLAY

12 { SANDSTONE ROOF
BONE 12"
COAL 7 1/2"
SLATE 2"
COAL 24"
BONE 3"
BLACK SLATE 3"
FIRE CLAY


9 { SANDSTONE ROOF
BONE 6"
COAL 32"
BONE 3"
BLACK SLATE 12"
FIRE CLAY

8 { 5011 + 59'
SANDSTONE ROOF
SPACE 43"
BONE 2"
BLACK SLATE 6"

7 { ON ROLL
BONE 8"
COAL 3"
SLATE 3"
COAL 17"
BONE + FIRE CLAY 14"
BLACK SLATE 7"

6 { BONE 7"
COAL 3"
SLATE 3"
COAL 26 1/2"
BLACK SLATE 10"
FIRE CLAY

5 { BONE 8"
COAL 37"
BLACK SLATE 9"
FIRE CLAY 15"

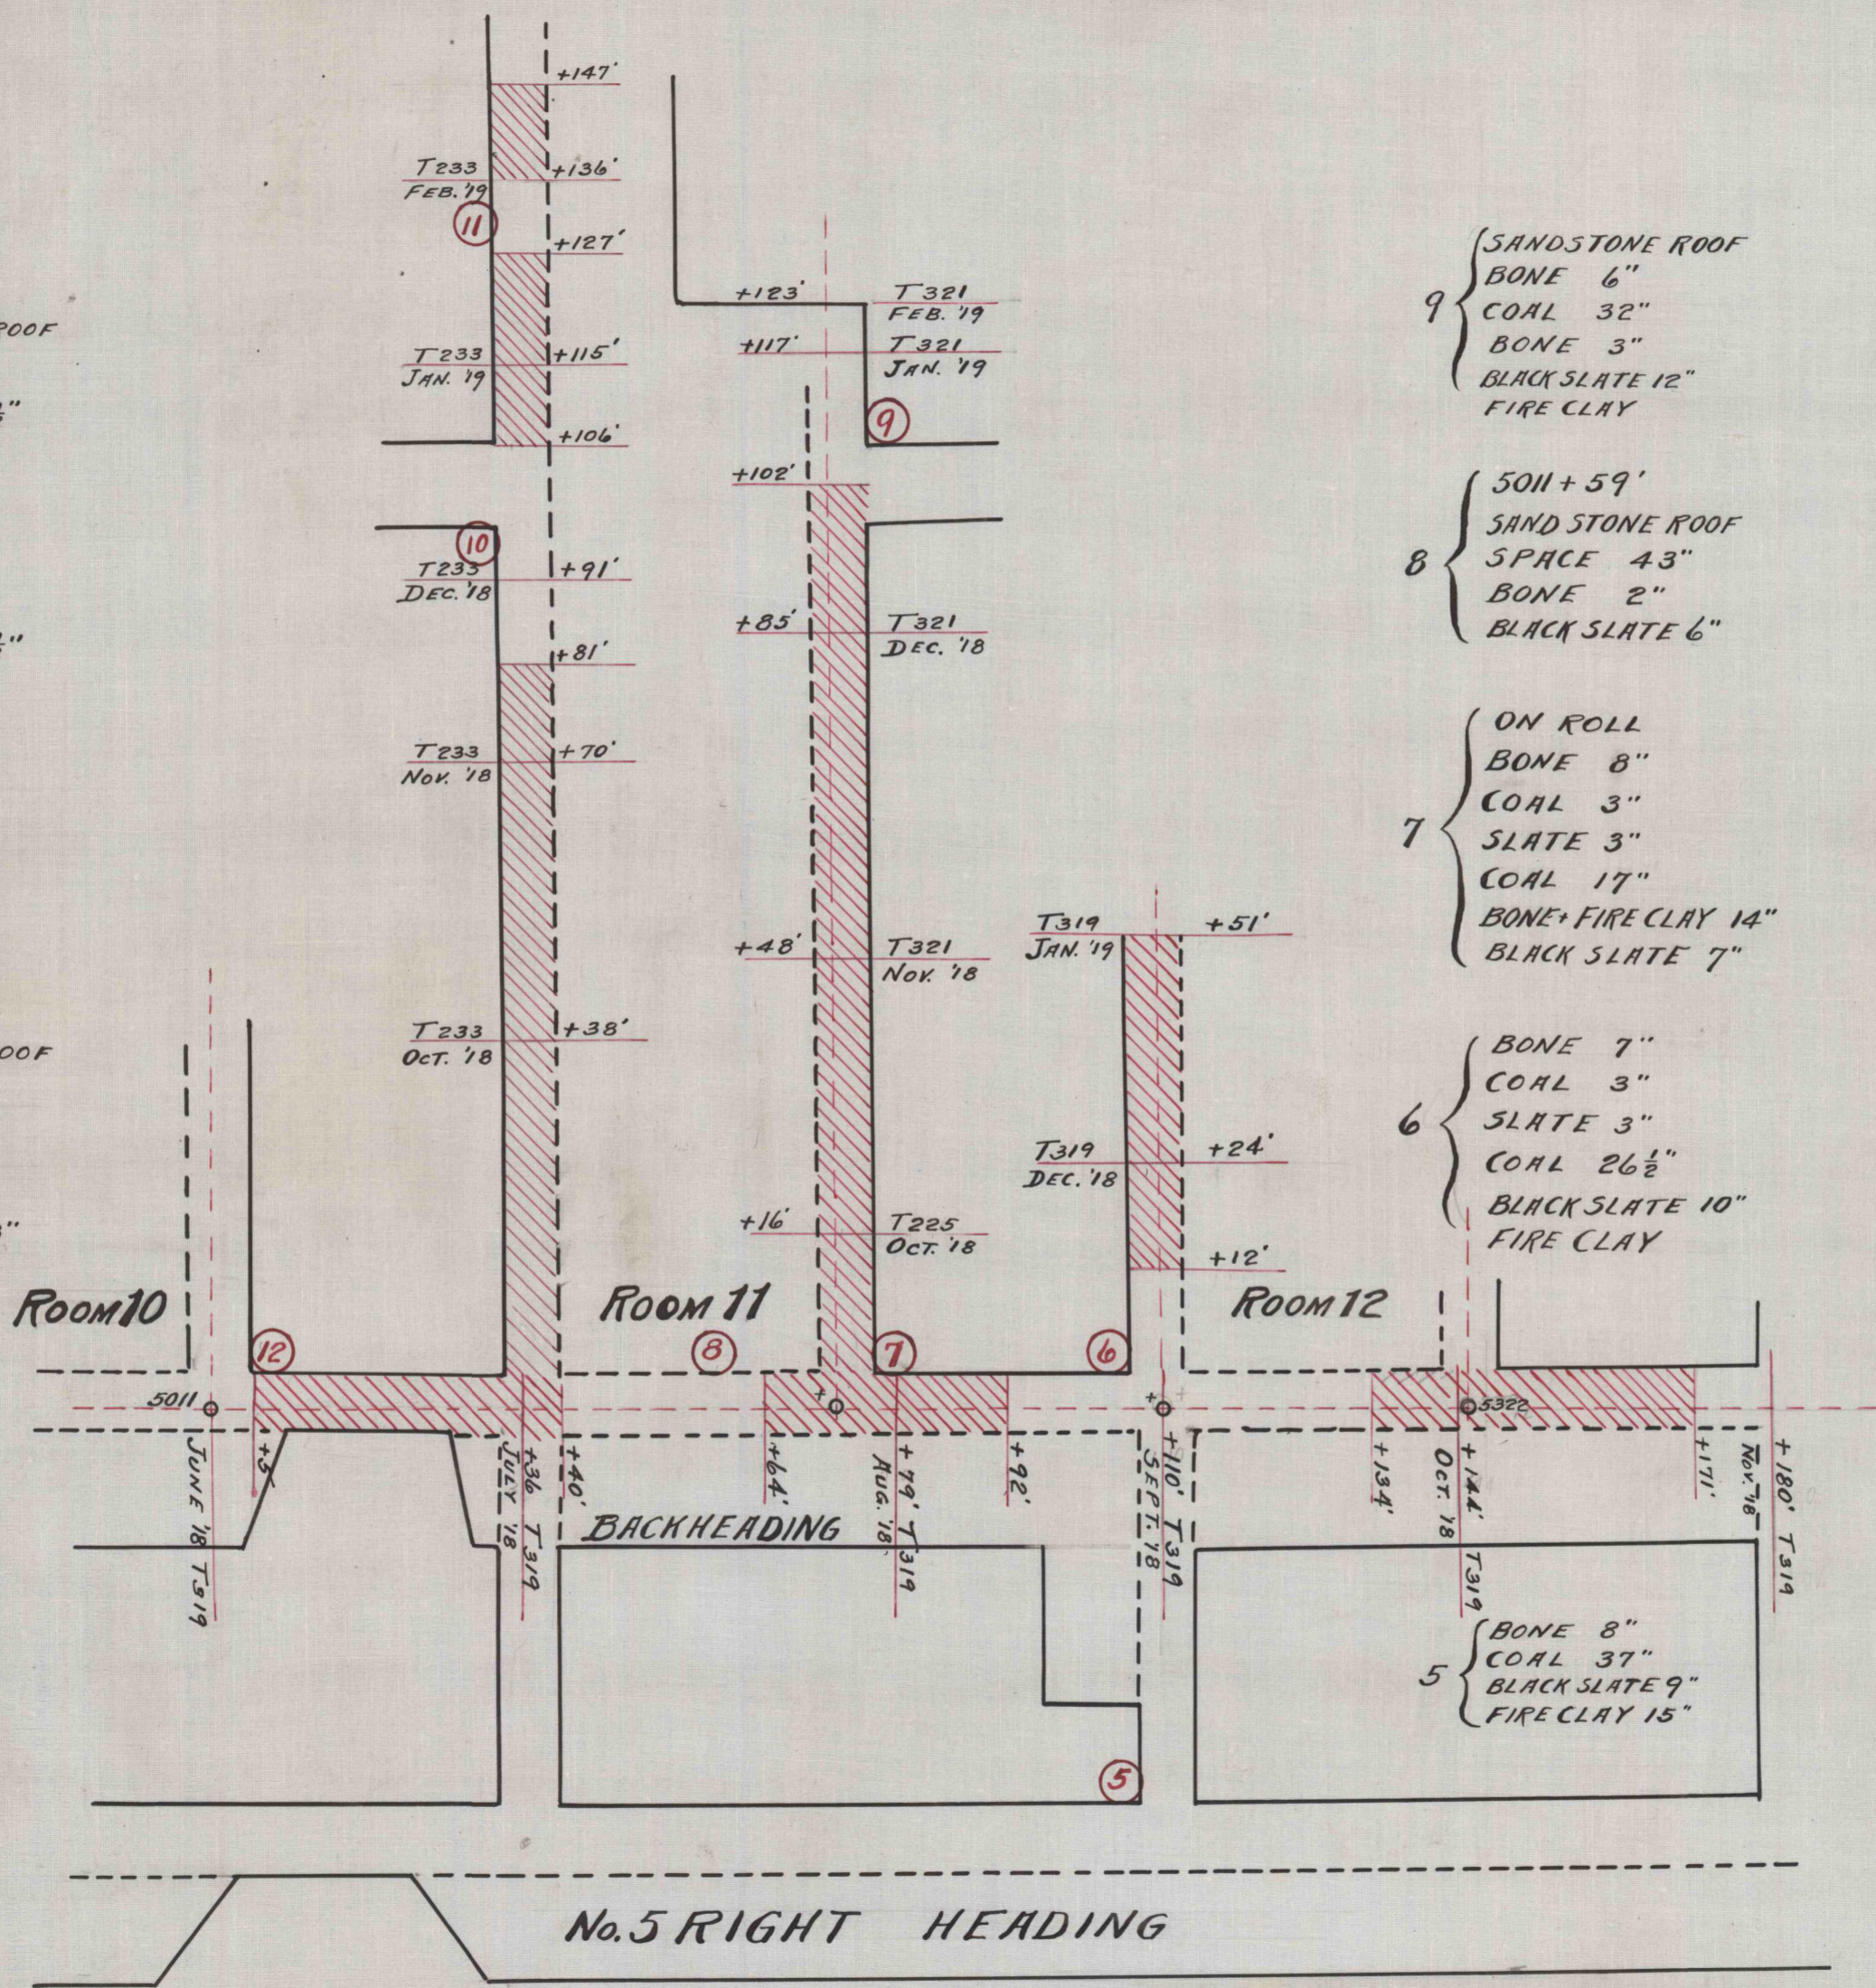

DETAILS
ARTHUR DIEHR CASE
SHOWING
ROLLS & YARDAGE
WITH
VEIN SECTIONS
SCALE: -1"=20' AUG. 1919

RIB —, GOB —, ROLL [hatched], YARDG [solid black]
TICKET 225 ALBERT PRICE
" 233 JOHN PRICE
" 319 WALTER STRONG
" 321 ARTHUR DIEHR