


RECORD OF D.D.H. No. 81
ON REDMITZKI LOT
SURFACE
ELEV. 404.8

42'-0" WASH
ELEV. 380.0
SEYMOUR SHOULD
HAVE BEEN HERE

SCOTT JENKINS
WAS BILLED FOR THE FOLLOWING


D.D.H. No. 79
FROM ELEVATION 383.5
TO " 295.0
TOTAL 88.5 feet

D.D.H. No. 81
FROM ELEVATION 380.0
TO " 303.0
TOTAL 77.0 feet

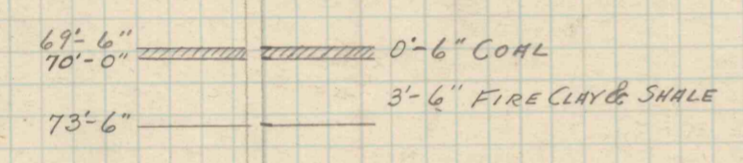


27'-6" HARD SAND ROCK

A SHEET LIKE THIS WAS
SENT TO SCOTT JENKINS

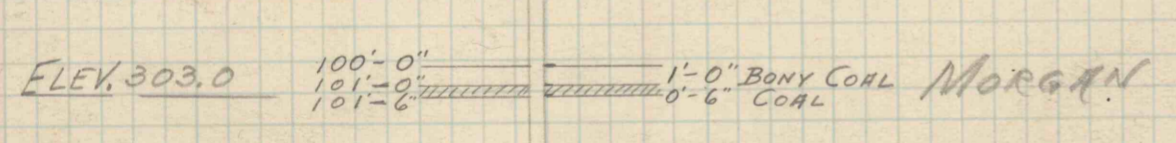

13'-0" DARK SAND SHALE

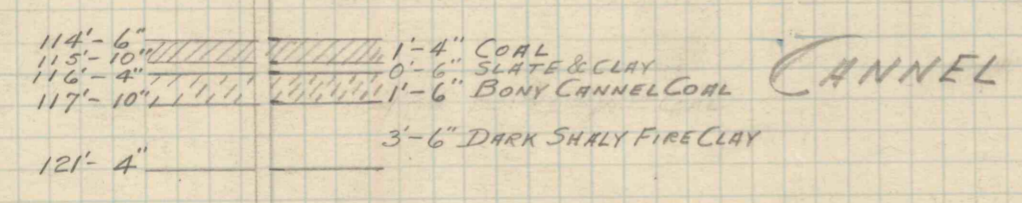

CANNEL

32'-8" SOFT DARK SHALE

FILE WITH
D-16



BLOSS