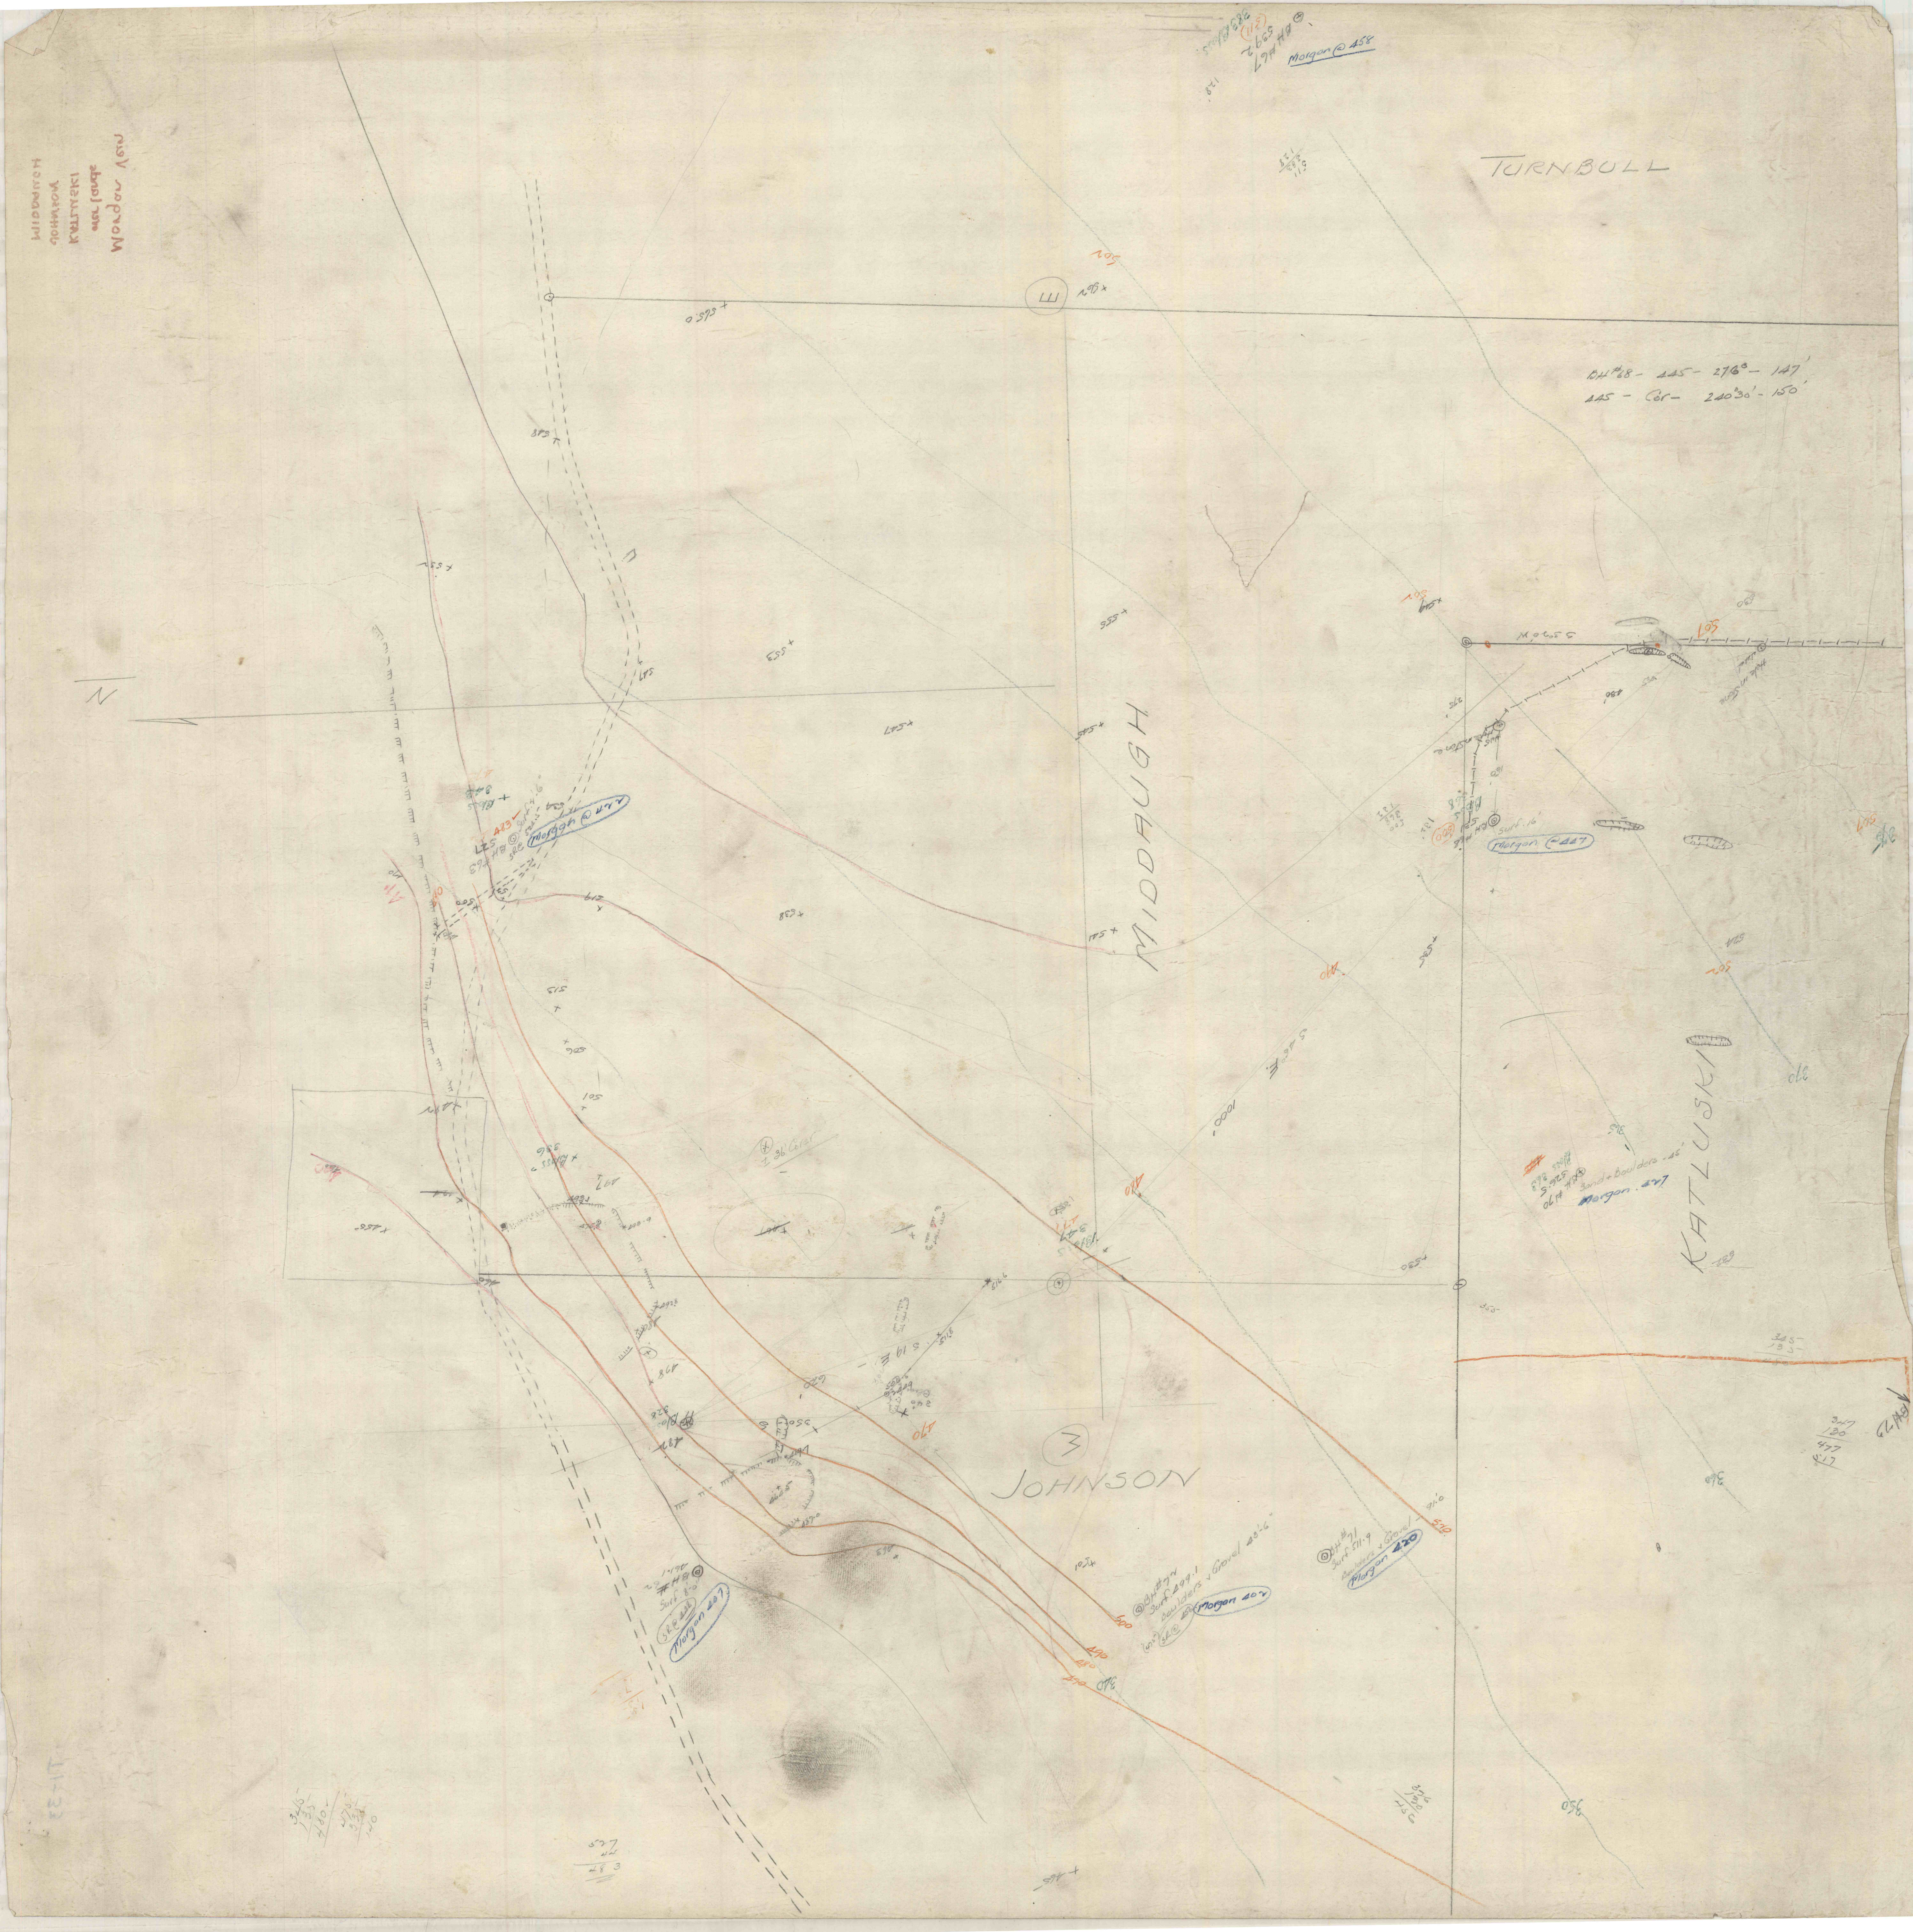
TURNBULL
MIDDAUGH
JOHNSON
KATLUSKI
Morgon @ 458
BH#68 - 445 - 276° - 147'
445 - Cor - 240°30' - 150'
Surf. 16'
Morgon @ 427
Sand + Boulders - 45'
Morgon 427
Hole in Stone
S 40° E
1000'
S 19 E
Surf. 8.0'
Morgon 407
BH#70 Surf. 499.1 Boulders v Gravel 43'-6"
Morgon 407
BH#71 Surf. 511.9 Boulders v Gravel - 91.0
Morgon 420
470
480
490
500
510