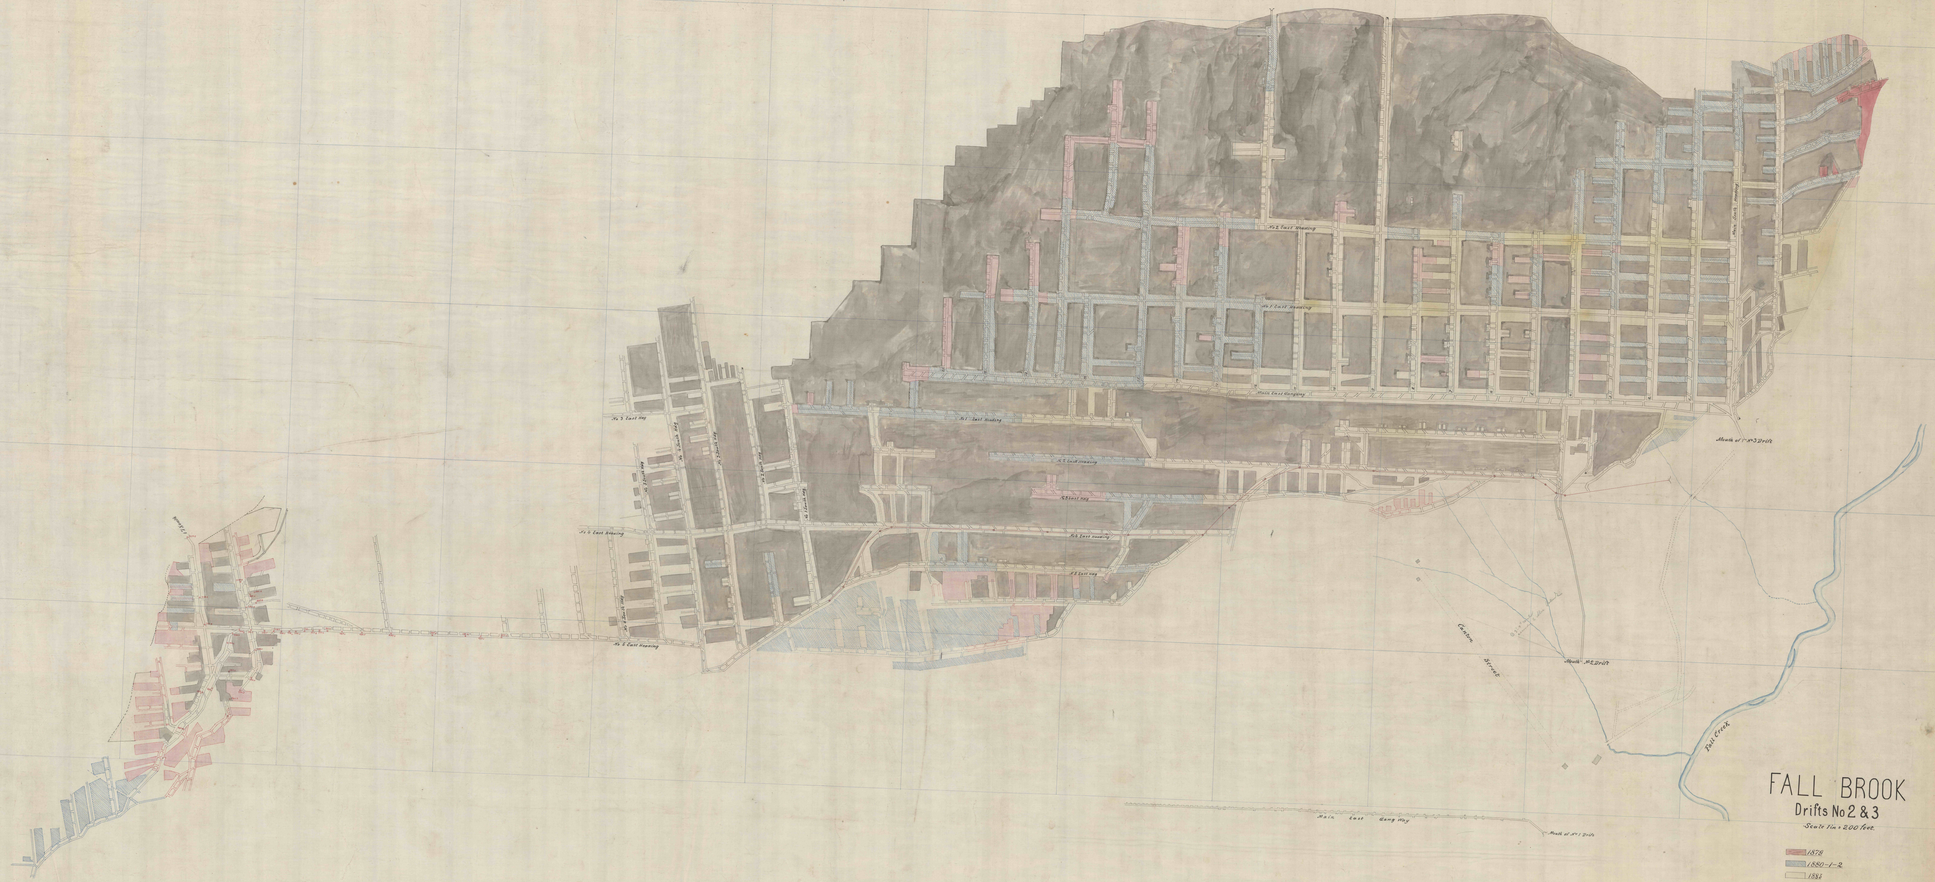

FALL BROOK

Drifts No 2 & 3

Scale 1in = 200 feet

1878

1882-1-2

1884