

450
218
162
5
72
54 126
32 192
54 252
72 324
54 378
72 450


Jan 1 1879

Fall Brook, Pa

No 3 Shaft

Jan 1 1879

dia 9 feet 6 inch

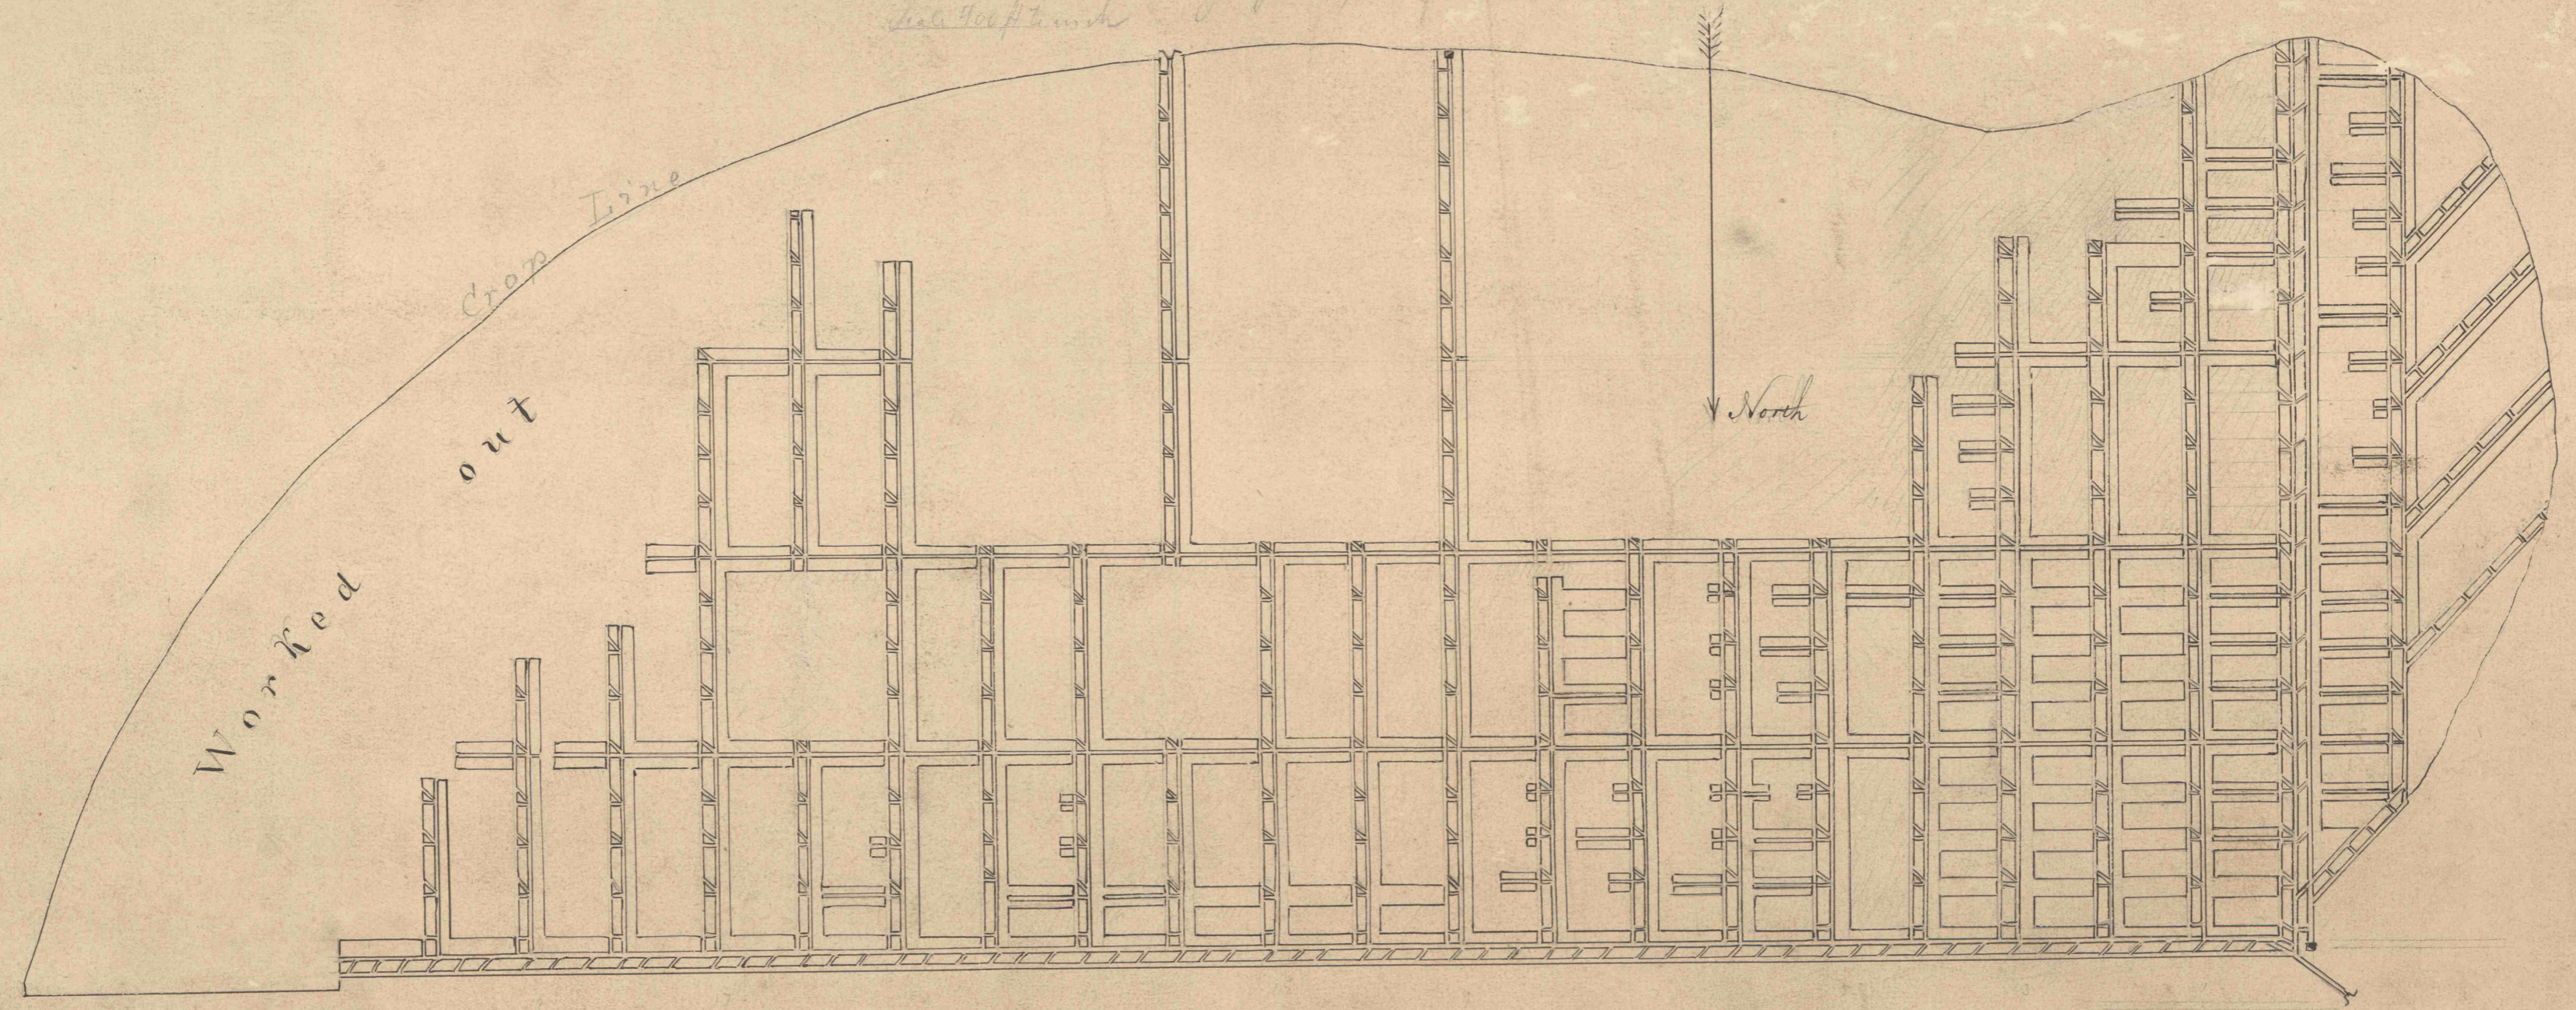

Worked out

out

Crop Line

North