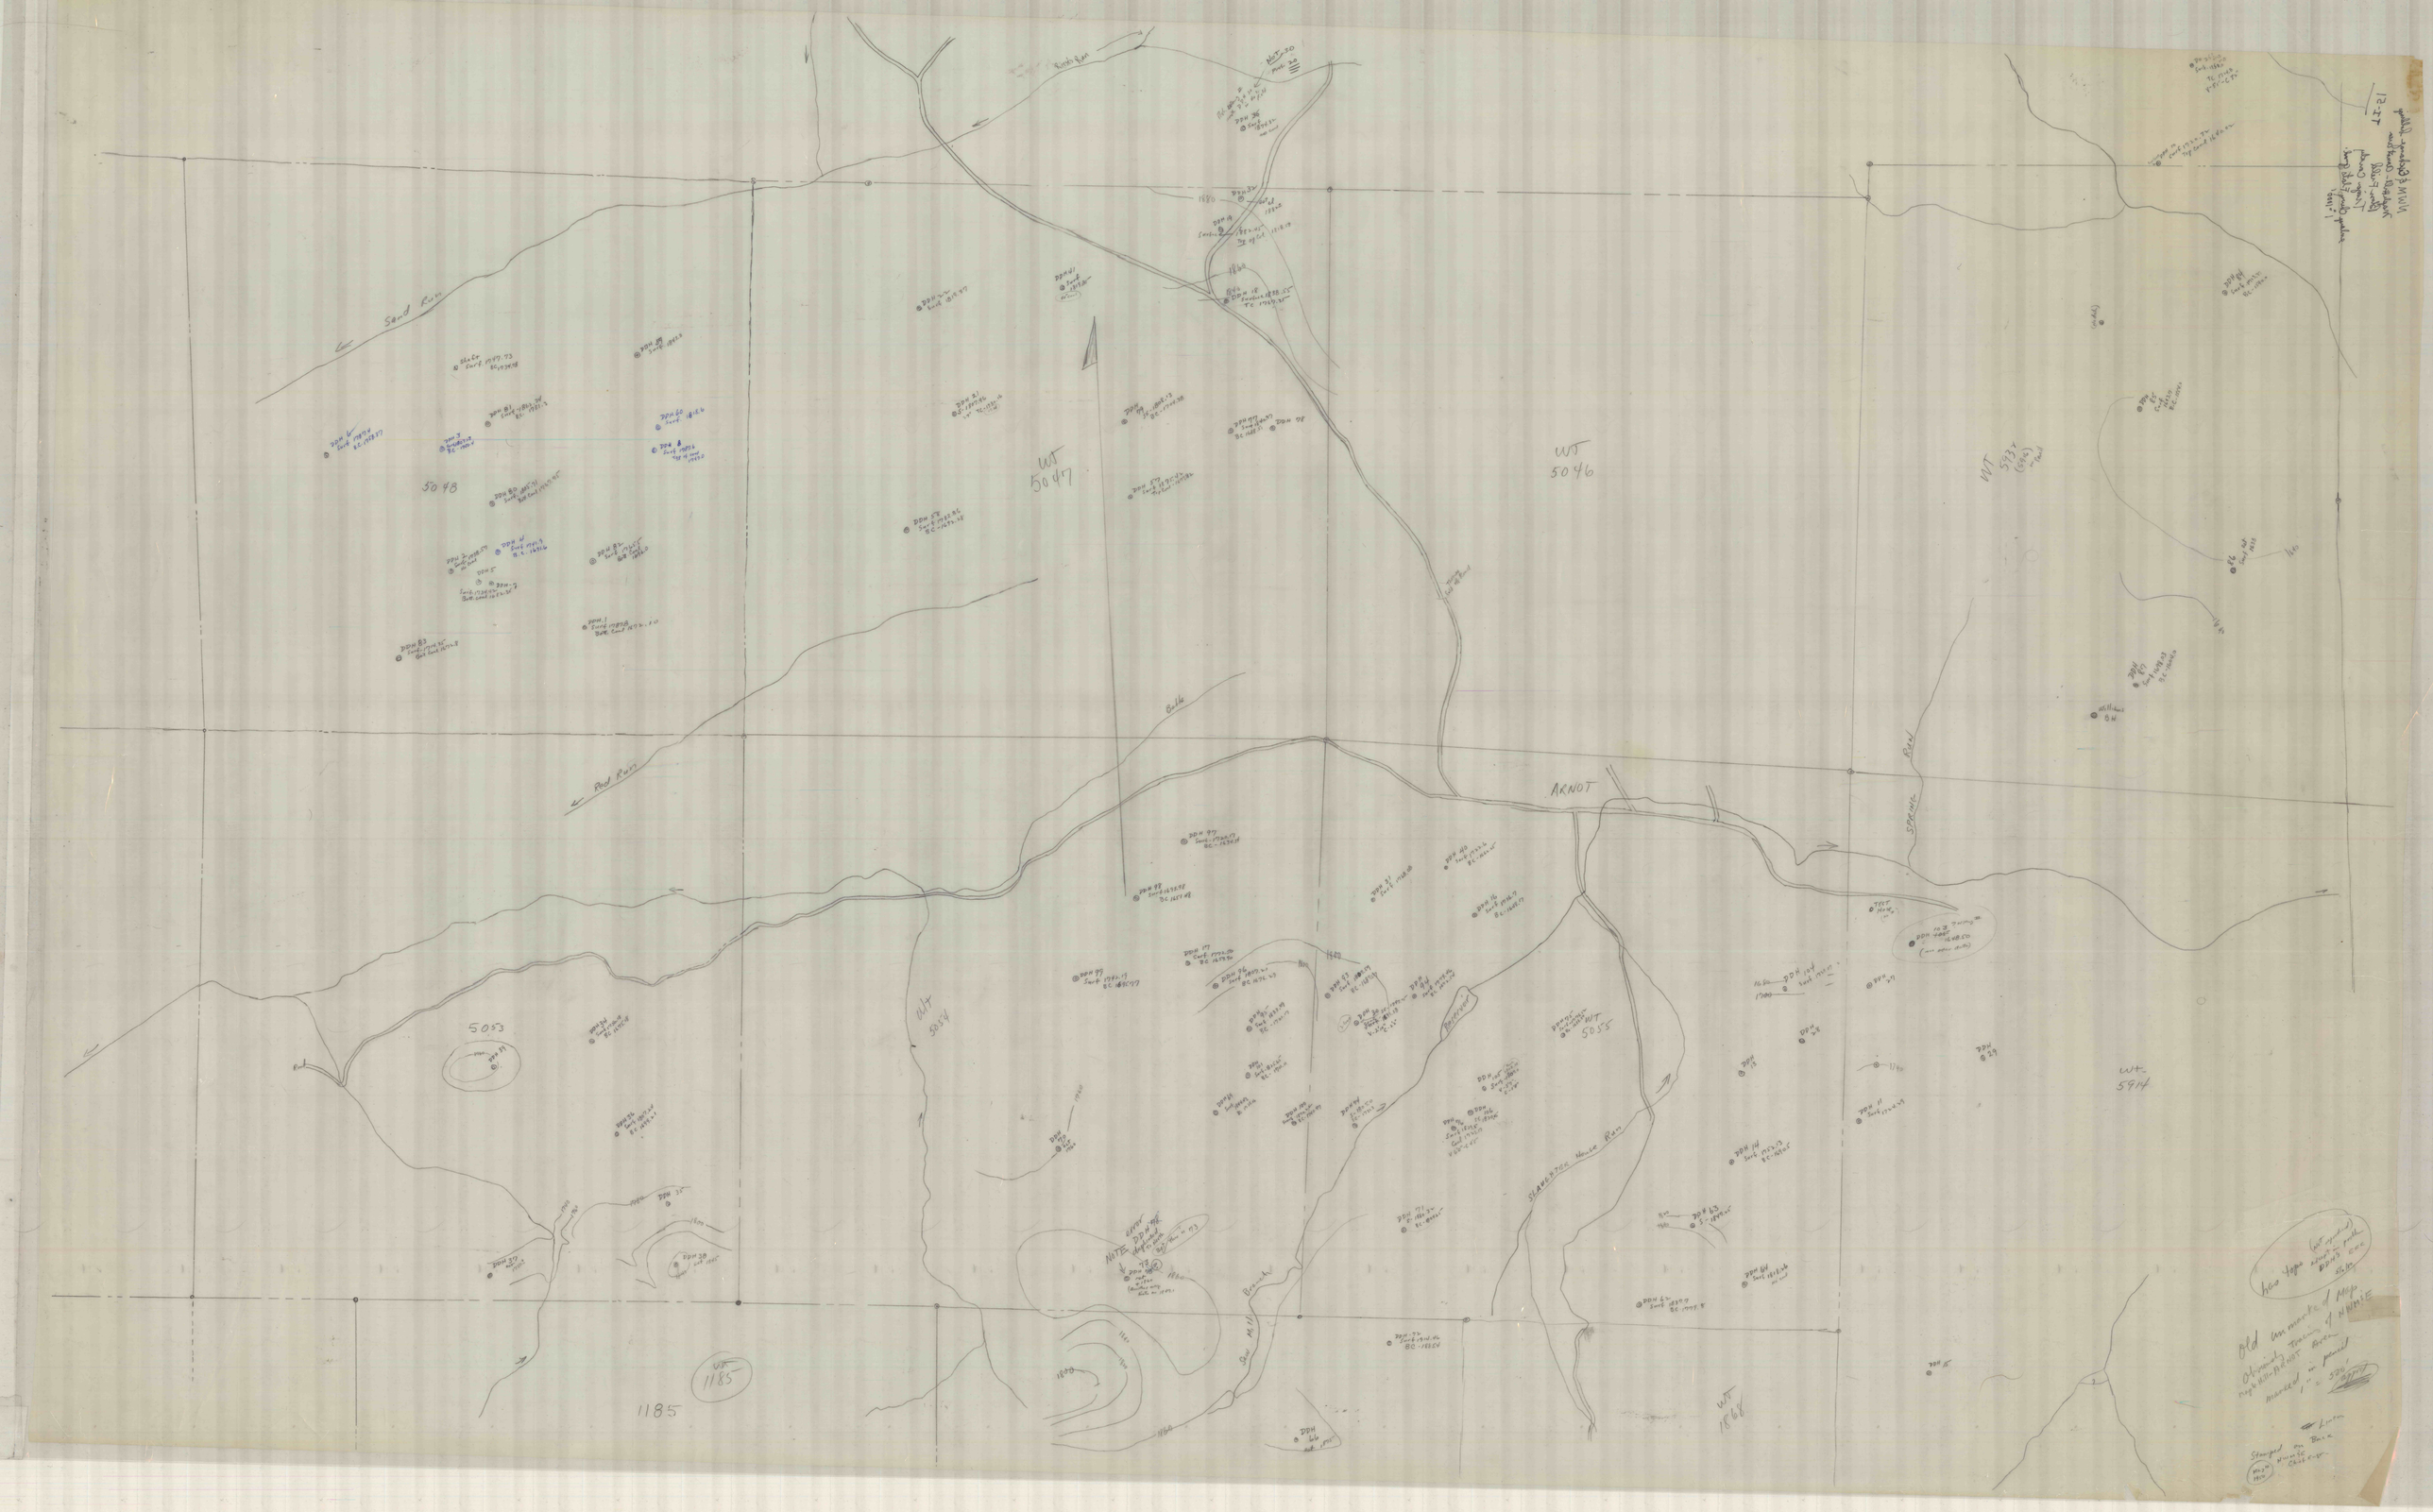

Sand Run
Red Run
5048
WT 5047
WT 5046
WT 5037
ARNOT
SPRING
5053
WT 5054
WT 5055
WT 5914
SLAUGHTER House Run
Reservoir
Saw Mill Branch
WT 1185
1185
WT 1868