


NOTATION
 DO NOT USE
 Surface elevations listed
 are in error
 but cannot establish
 them - note the
 other calculations

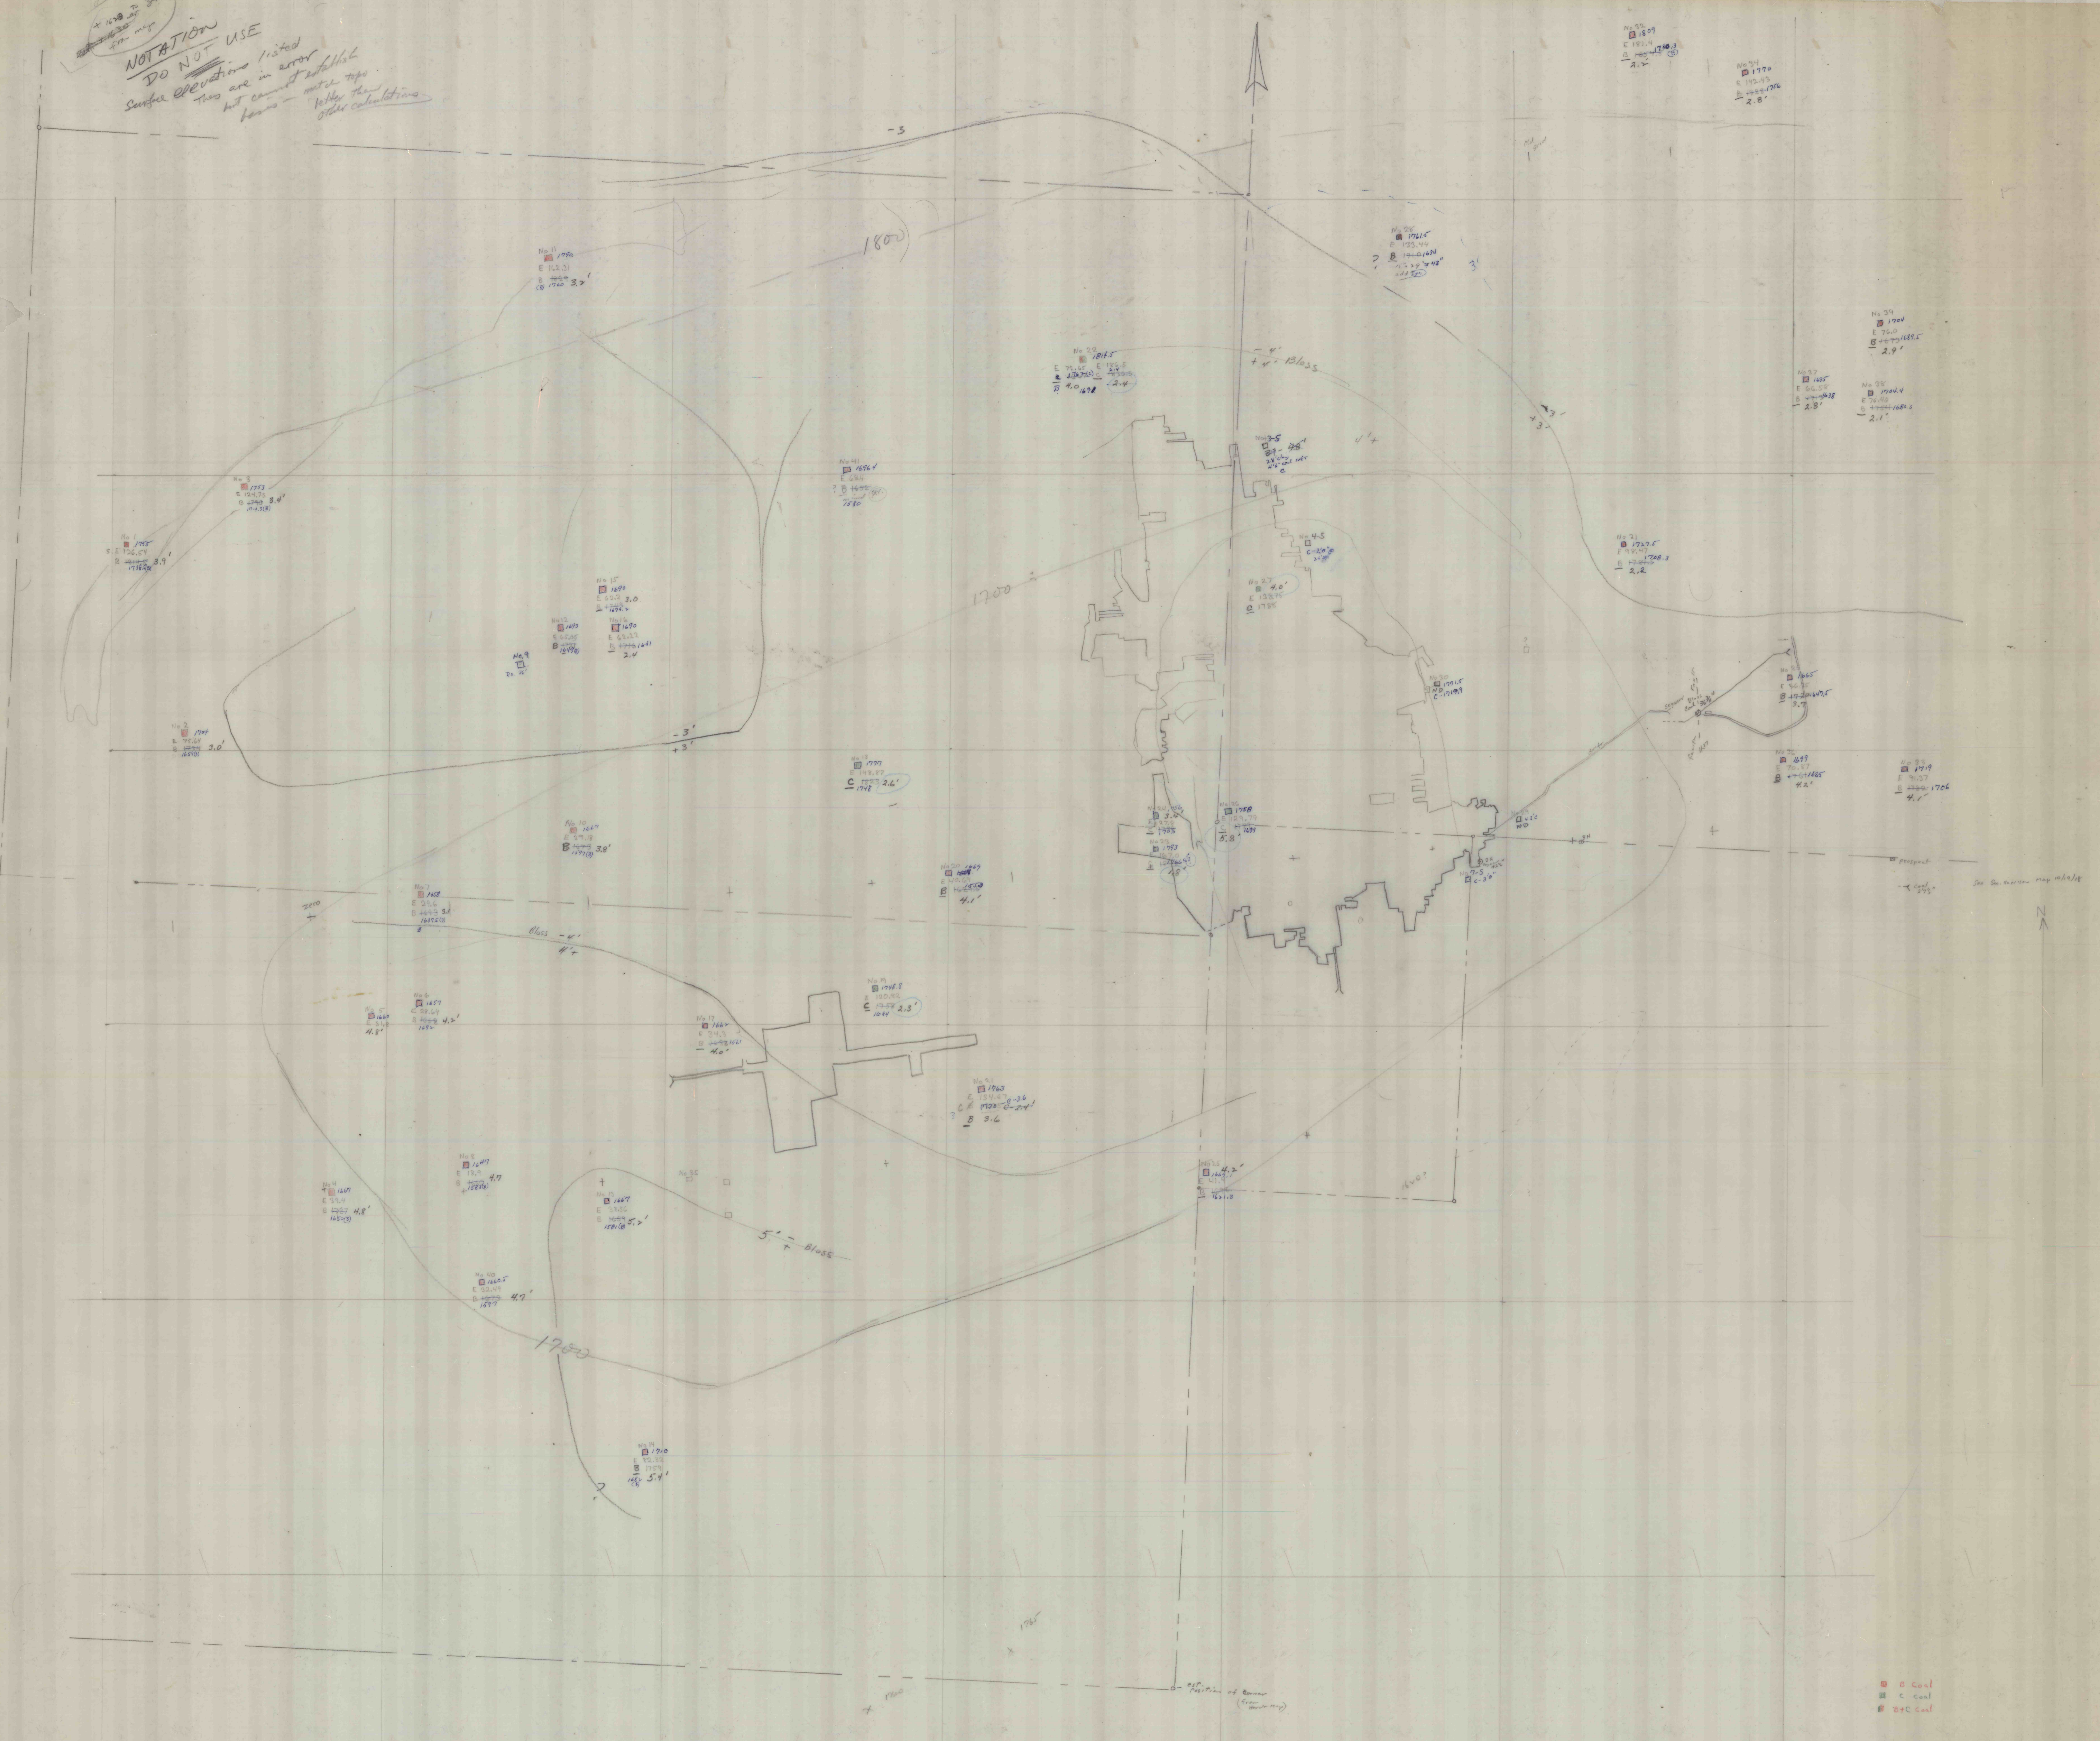

■ coal
 ■ c. coal
 ■ o.c. coal

Anticline $\approx 1/2$
 Interval C-B 160-170'

added data on
 forms by EG
 added data on
 forms by EG
 added data on
 forms by EG