



COAL SEAMS		
MAP LETTER	STANDARD COAL NAME	LOCAL NAME
E	UPPER FREEPORT	ROCK
D	LOWER FREEPORT	SEYMOUR
<i>C</i>	UPPER KITTANNING* (C PRIME)	MORGAN
C	MIDDLE KITTANNING*	CUSHING, "MORGAN"
B	LOWER KITTANNING	BLOSS (UPPER OR MAIN BED) BEAR CREEK (LOWER SPLIT BED)

*NOTE: MIDDLE AND UPPER KITTANNING MAPPED TOGETHER THROUGHOUT THIS AREA.

RATTLER MINE AREA
 ORIGINAL RESERVES 1,710,720 TONS
 REMAINING RESOURCES 78,240 TONS
 STRIPPABLE RESERVES NOT DETERMINED

ANNA-S COMPLEX
 ALL COALS
 ORIGINAL RESERVES 10,765,692 TONS
 REMAINING RESOURCES ~~2,732,513~~ TONS
 STRIPPABLE RESERVES 1,002,240 TONS

ANTRIM AREA
 ORIGINAL RESERVES 22,015,124 TONS
 REMAINING RESOURCES 8,017,094 TONS
 STRIPPABLE RESERVES ~~3,910,214~~ TONS
 (A) PROVED 2,889,187
 INFERRED ~~2,021,027~~
 4,910,214
Total does not agree.

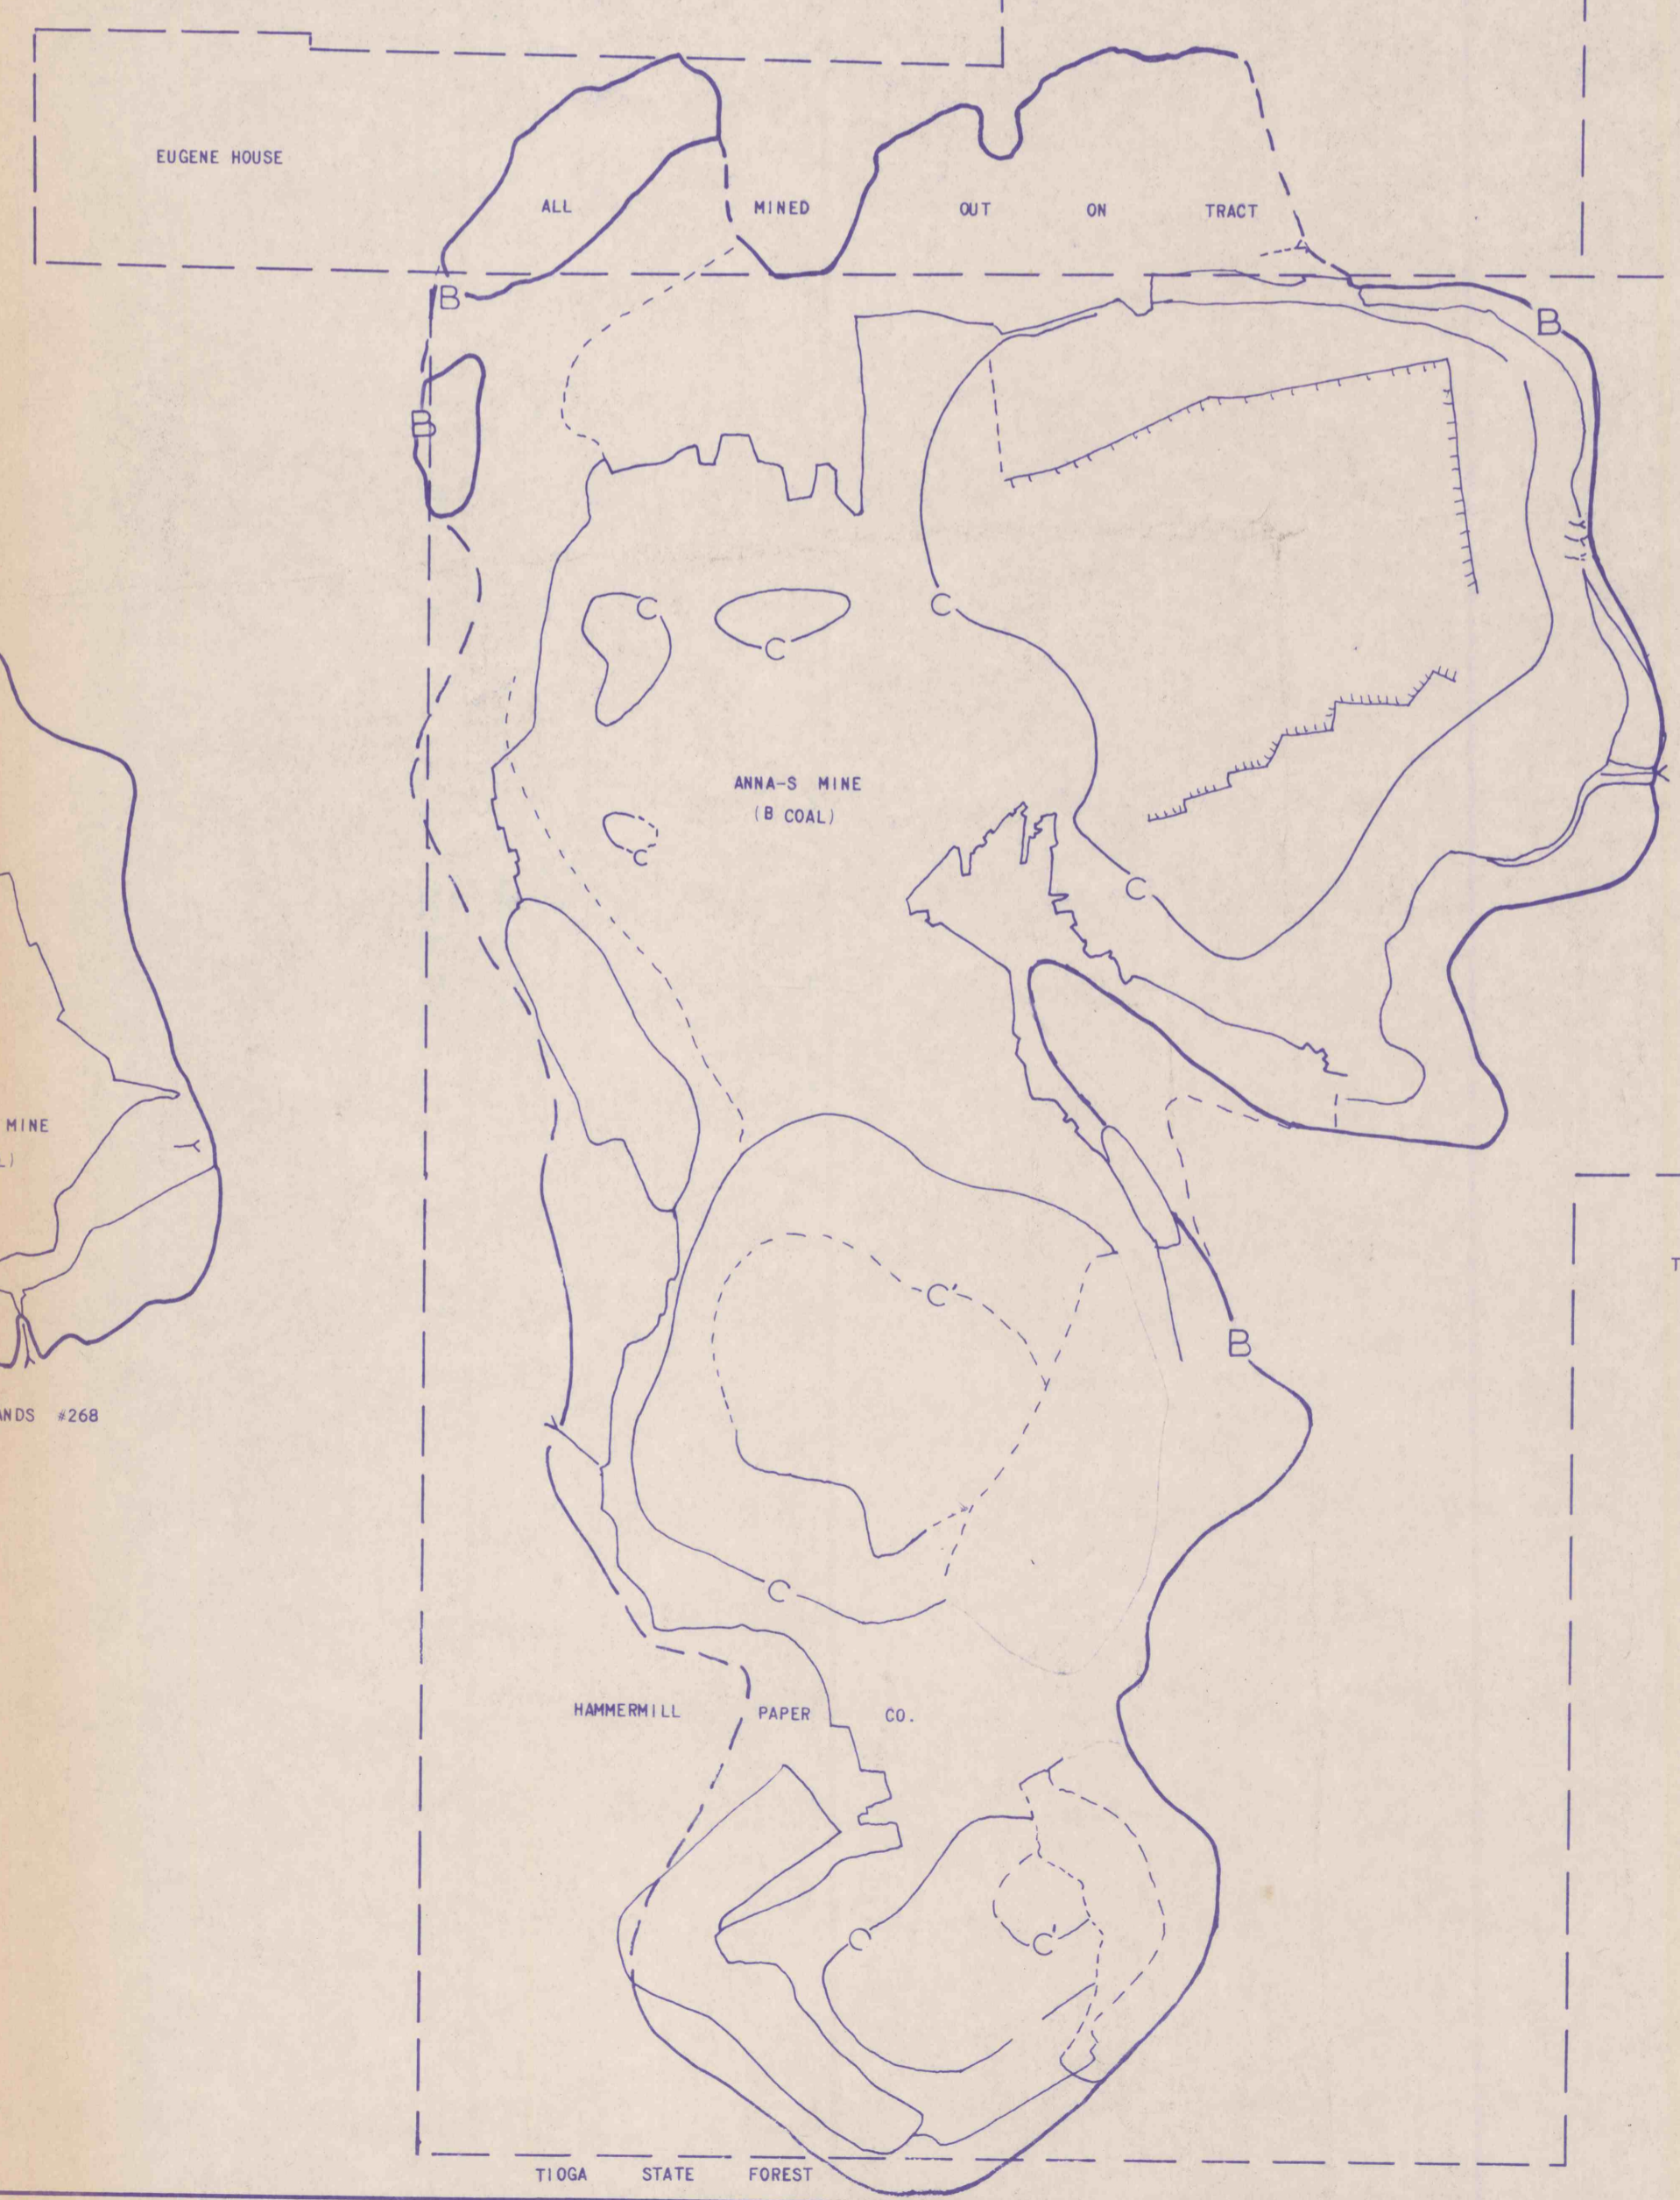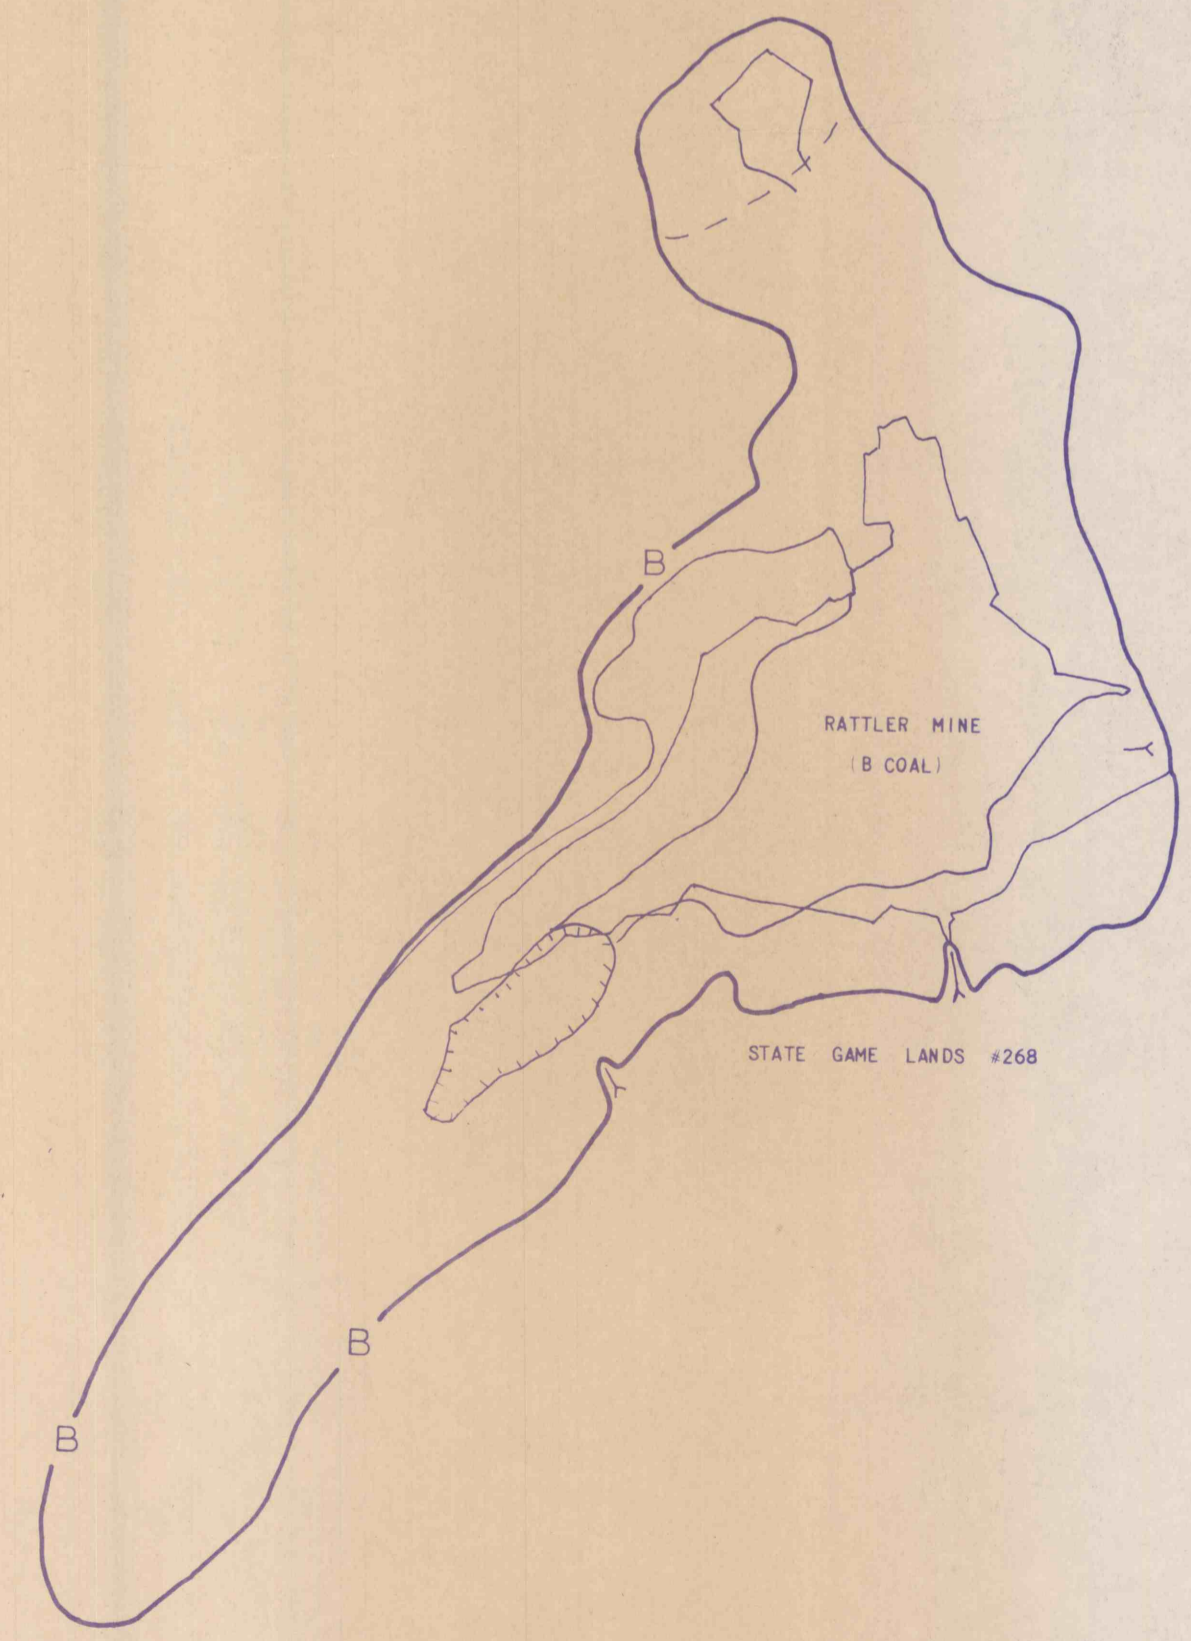

COAL PROPERTIES AND RESERVES
 BLOSSBURG COAL BASIN
 PREPARED FOR
 NEW YORK STATE GAS AND ELECTRIC CORP.
 ANTRIM MINING CO. AREA
 DUNCAN AND MORRIS TOWNSHIPS, TIOGA COUNTY, PA.
 SCALE 1" = 1000 FEET
 PREPARED FEBRUARY 1982 BY
 EDWIN F. KOPPE - GEOLOGIST
 AND BOYER KANTZ, R.S.