

0 30' 20"
0 15' 10"
0 00' 00"

Cherry Flk Q
Blattburg Quad

WARRANT 5937
(5916 L. 1911)

5046

WARRANT 5046

WARRANT 5047

WARRANT 5053

WARRANT 5054

WARRANT 5055

WARRANT 1185


Warrant 1185

WARRANT 5914

OLD Unmarked Map
Obviously Tracing of NWMIE
Maple Hill - Rent from
Original marked 1850
in pencil
Stamped in blue
NWMIE Civil Engineer
May 10, 1950

Placement of line
ditto not
sharp

OLD UNMARKED map

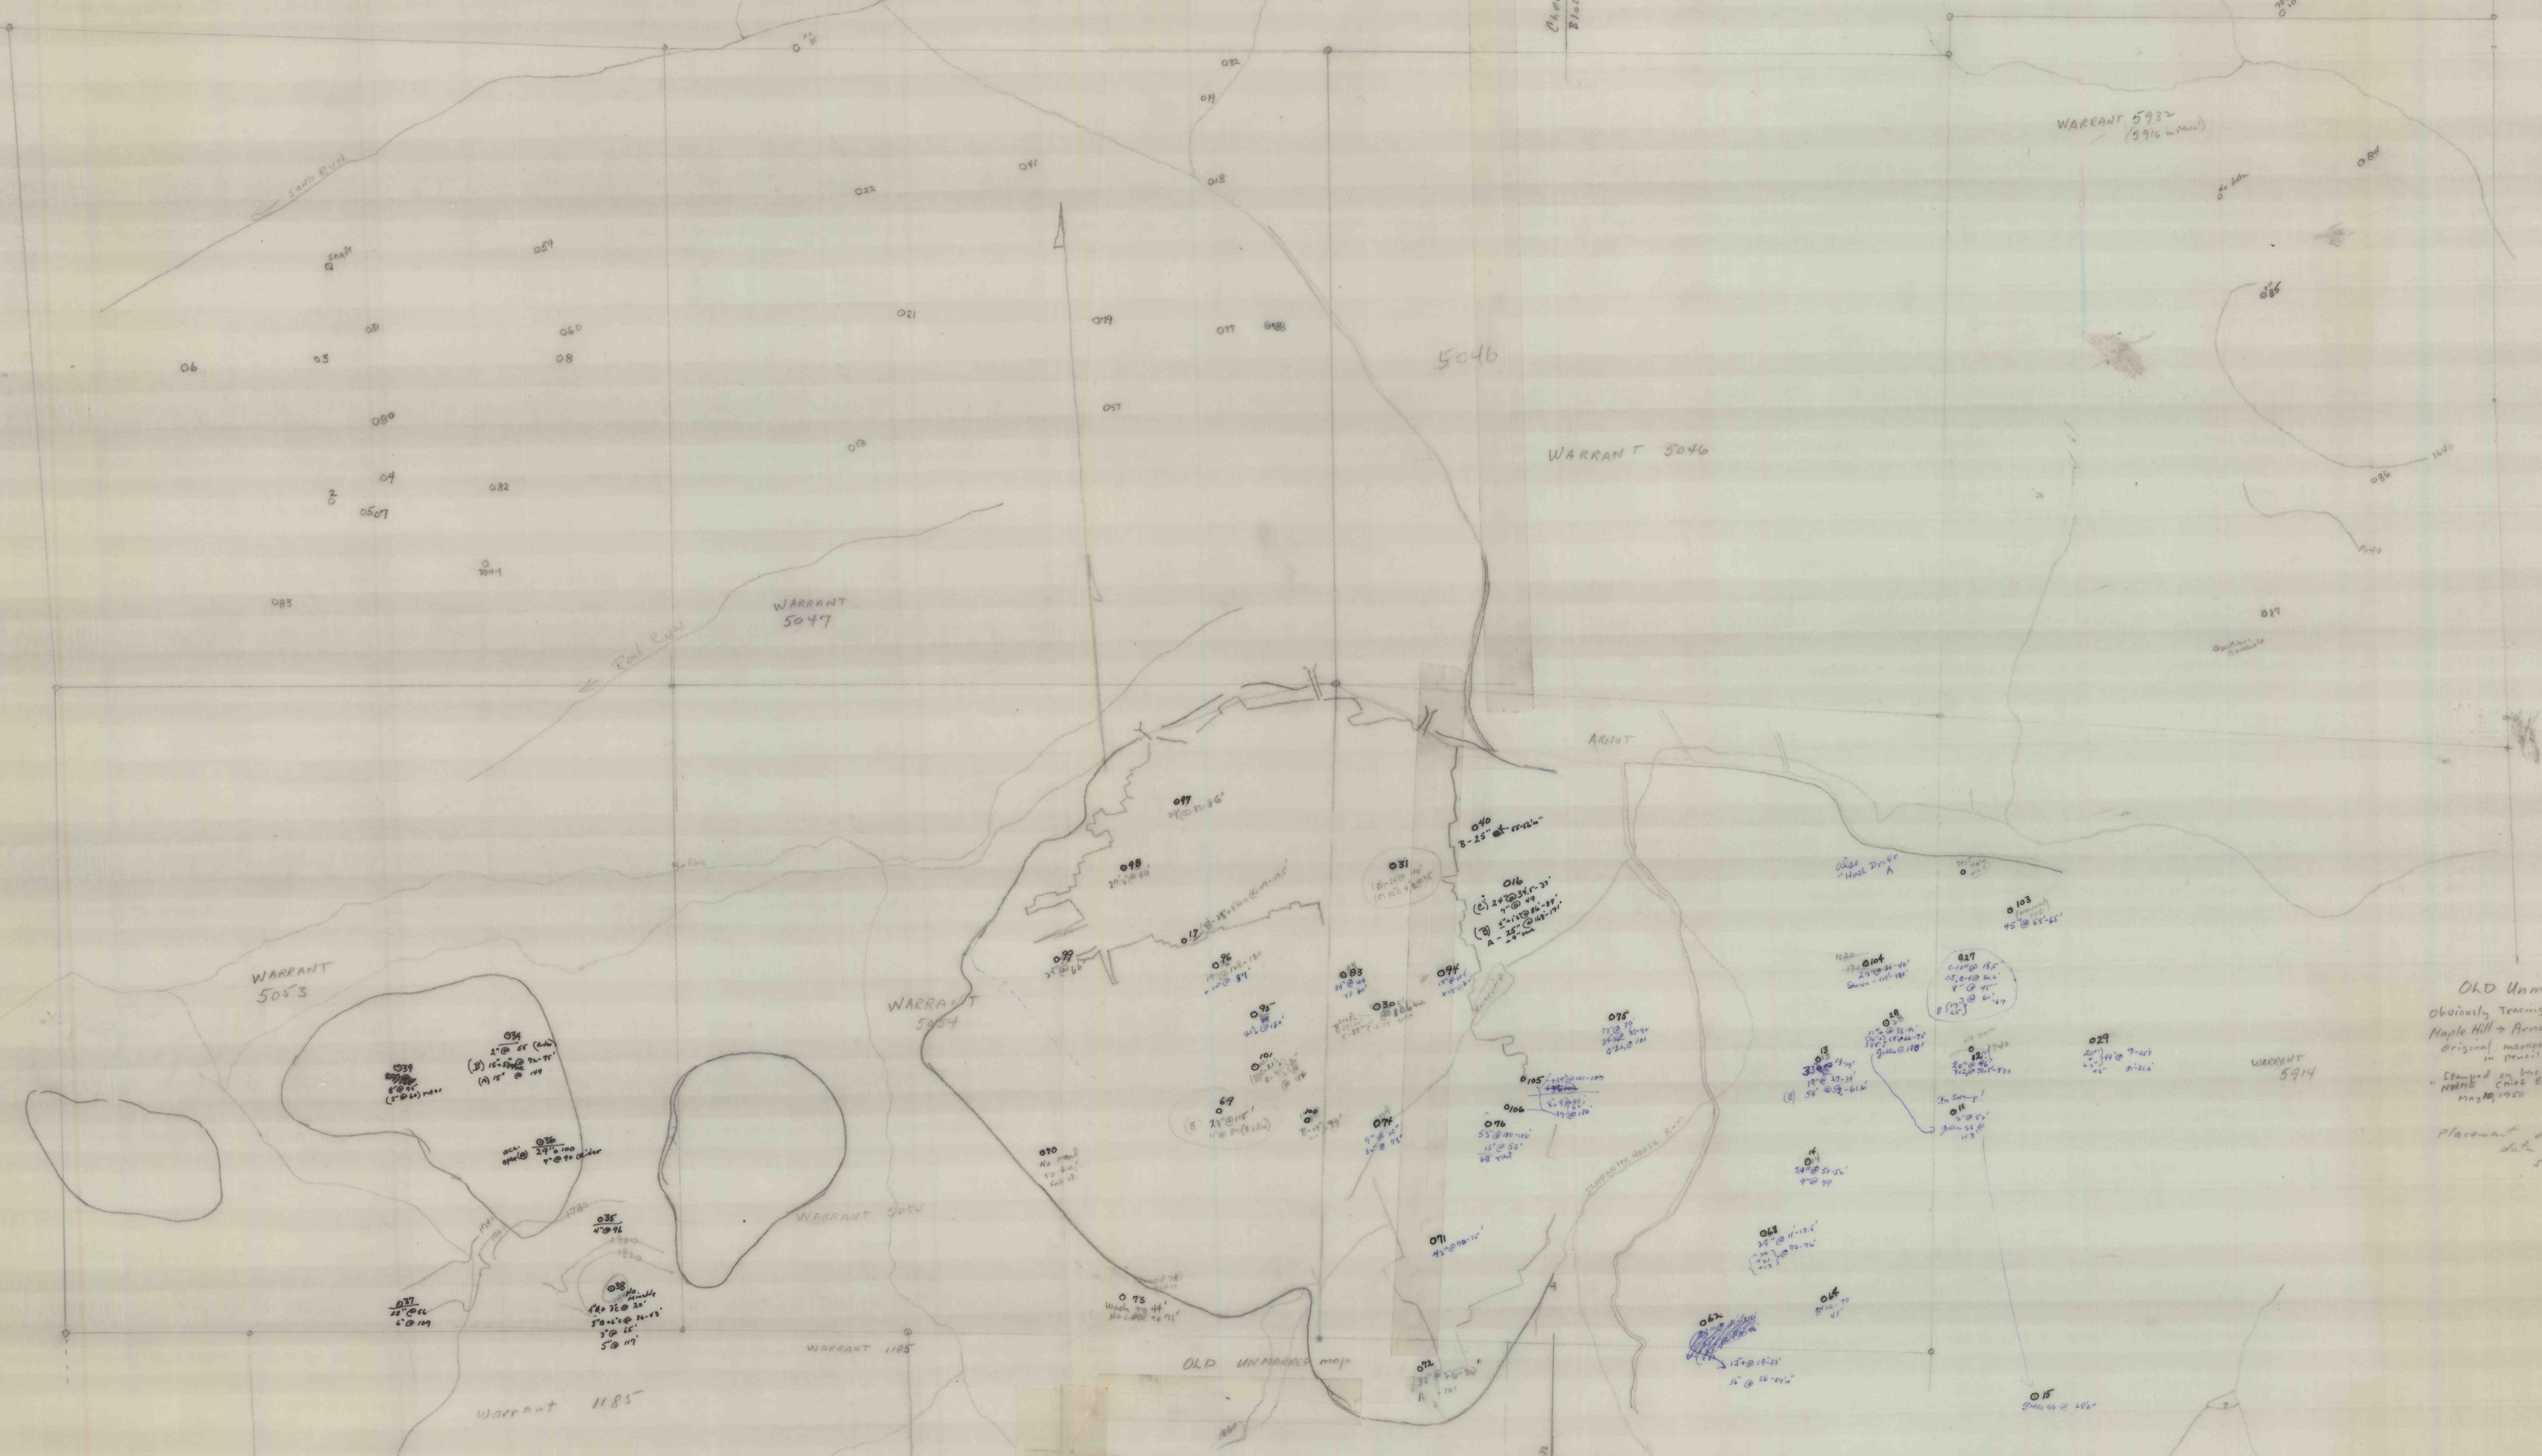

1" = 100'