


100A

Extent of Arnot 1933
expressed from
Norman & Guy lease map
made by our party
only made 12/20/33
& located in same
original
and used
correctly
for USGS maps
Scale on the
Norman & Guy
map
correct here

Cherry Fork
Blossburg

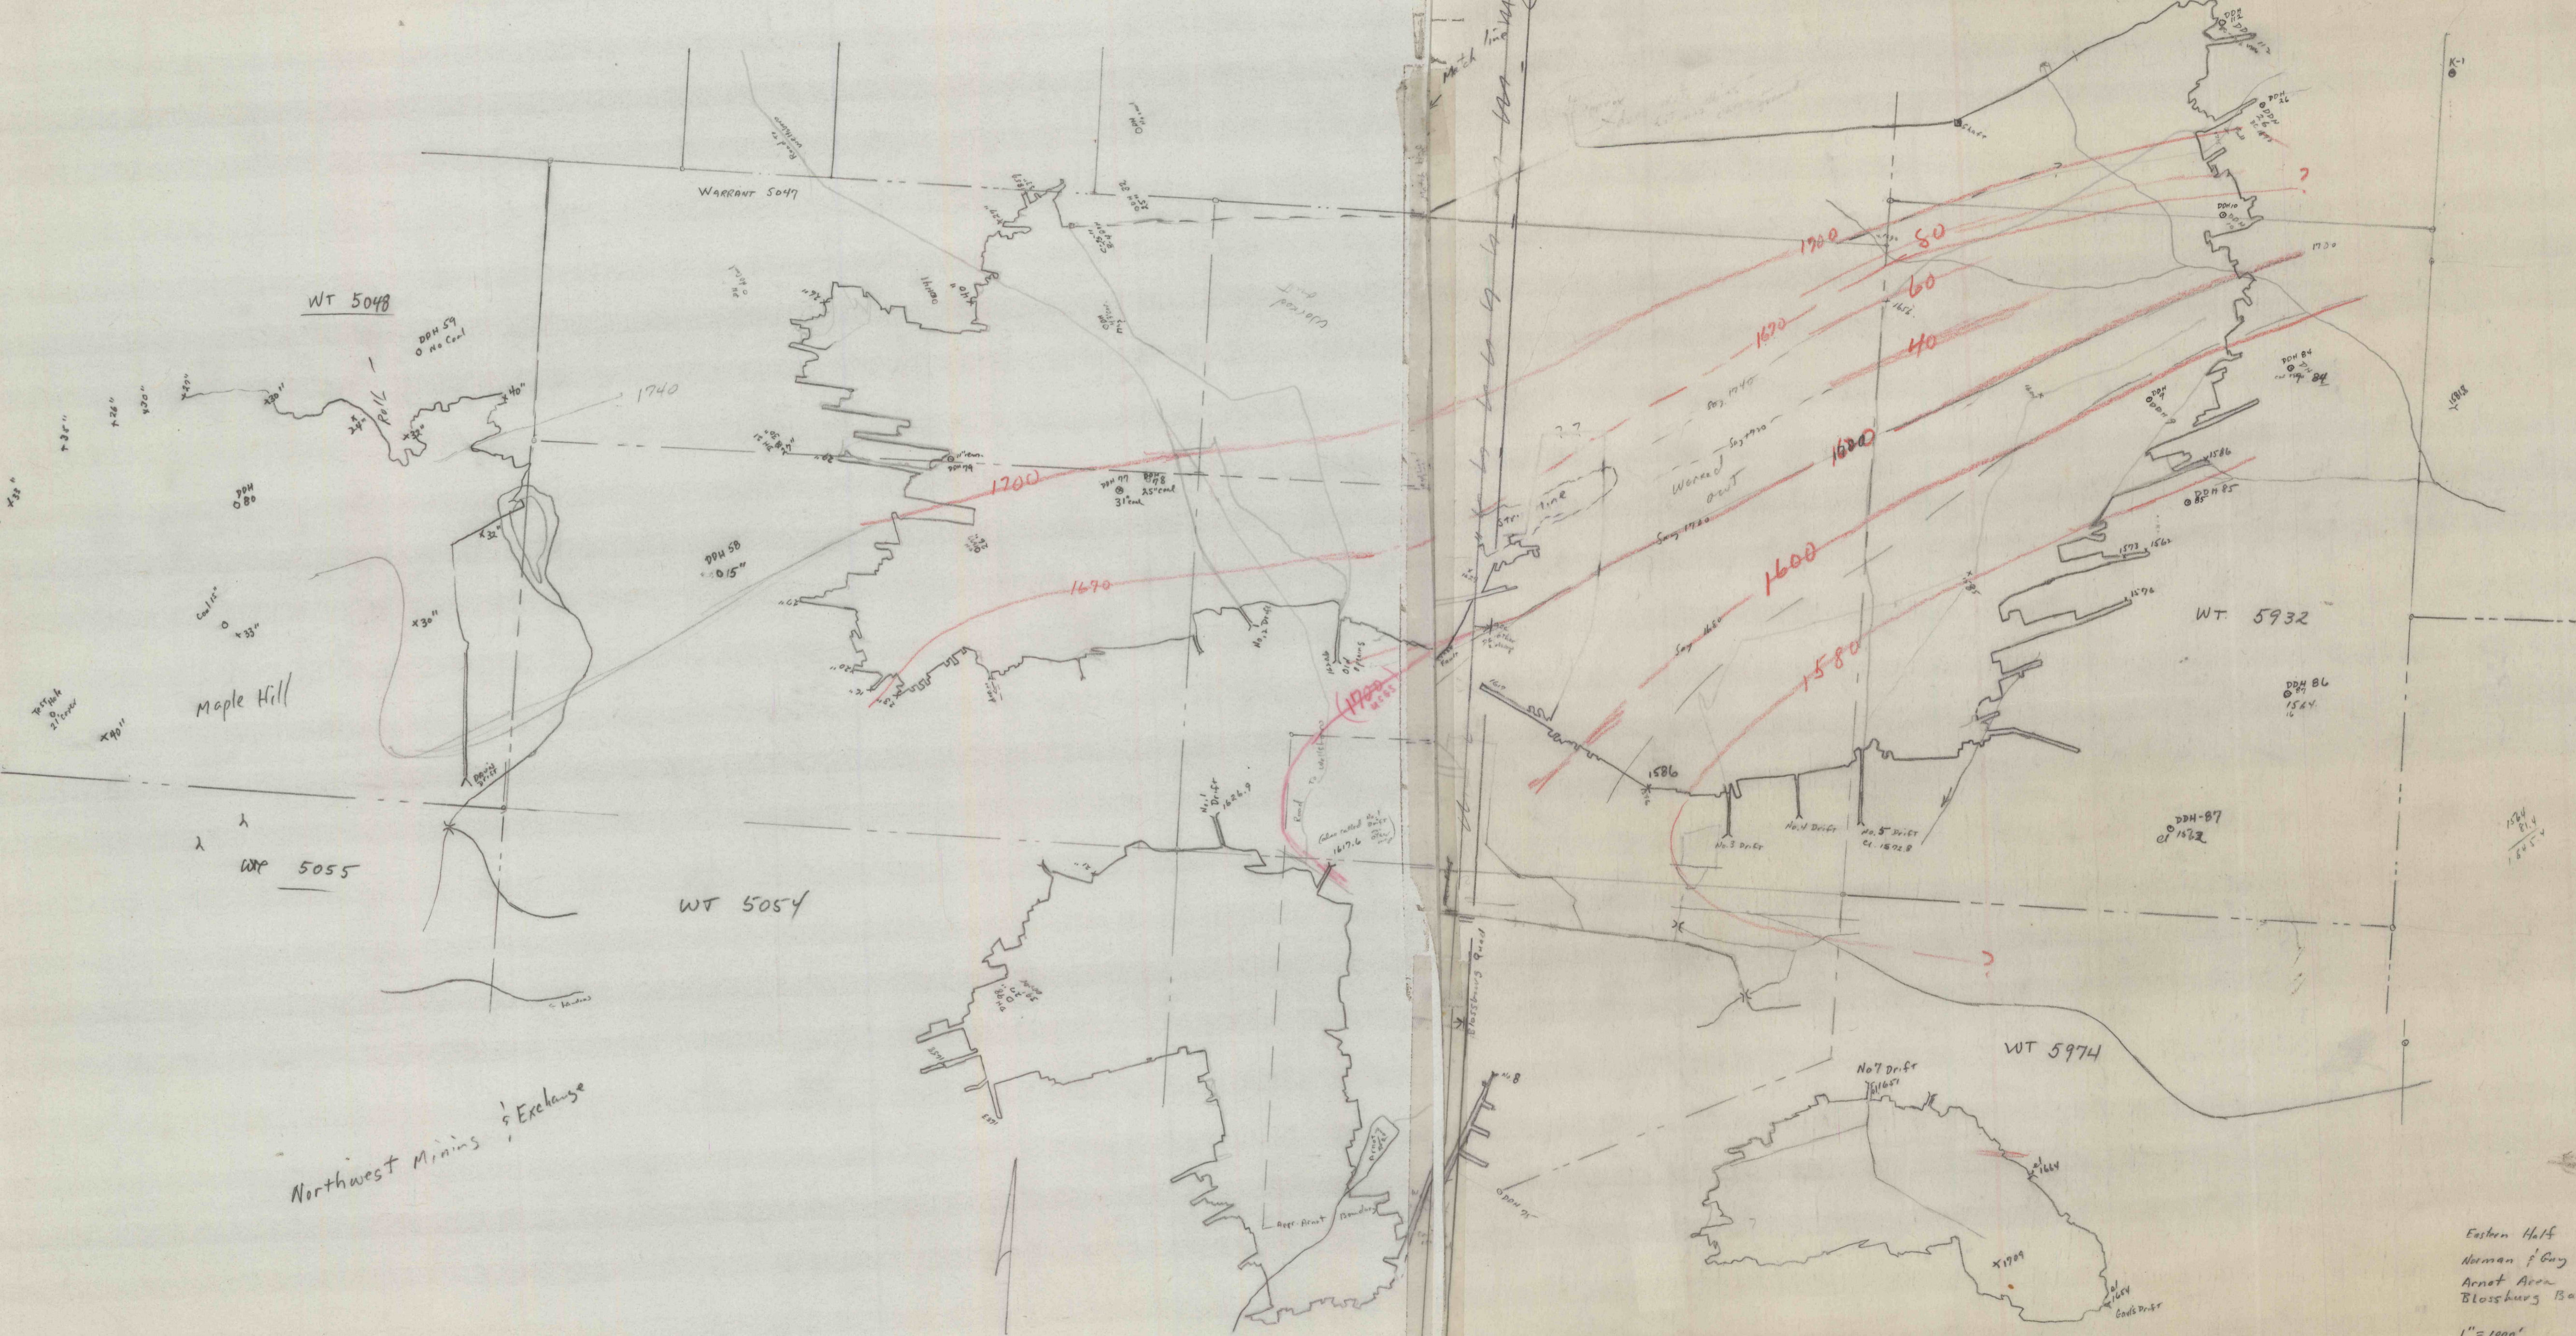

Eastern Half
Norman & Guy Lease
Arnot Area
Blossburg Basin

1" = 1000'
E.F. Koppe
10/14