


08
AS
D
M
K
C
O
X

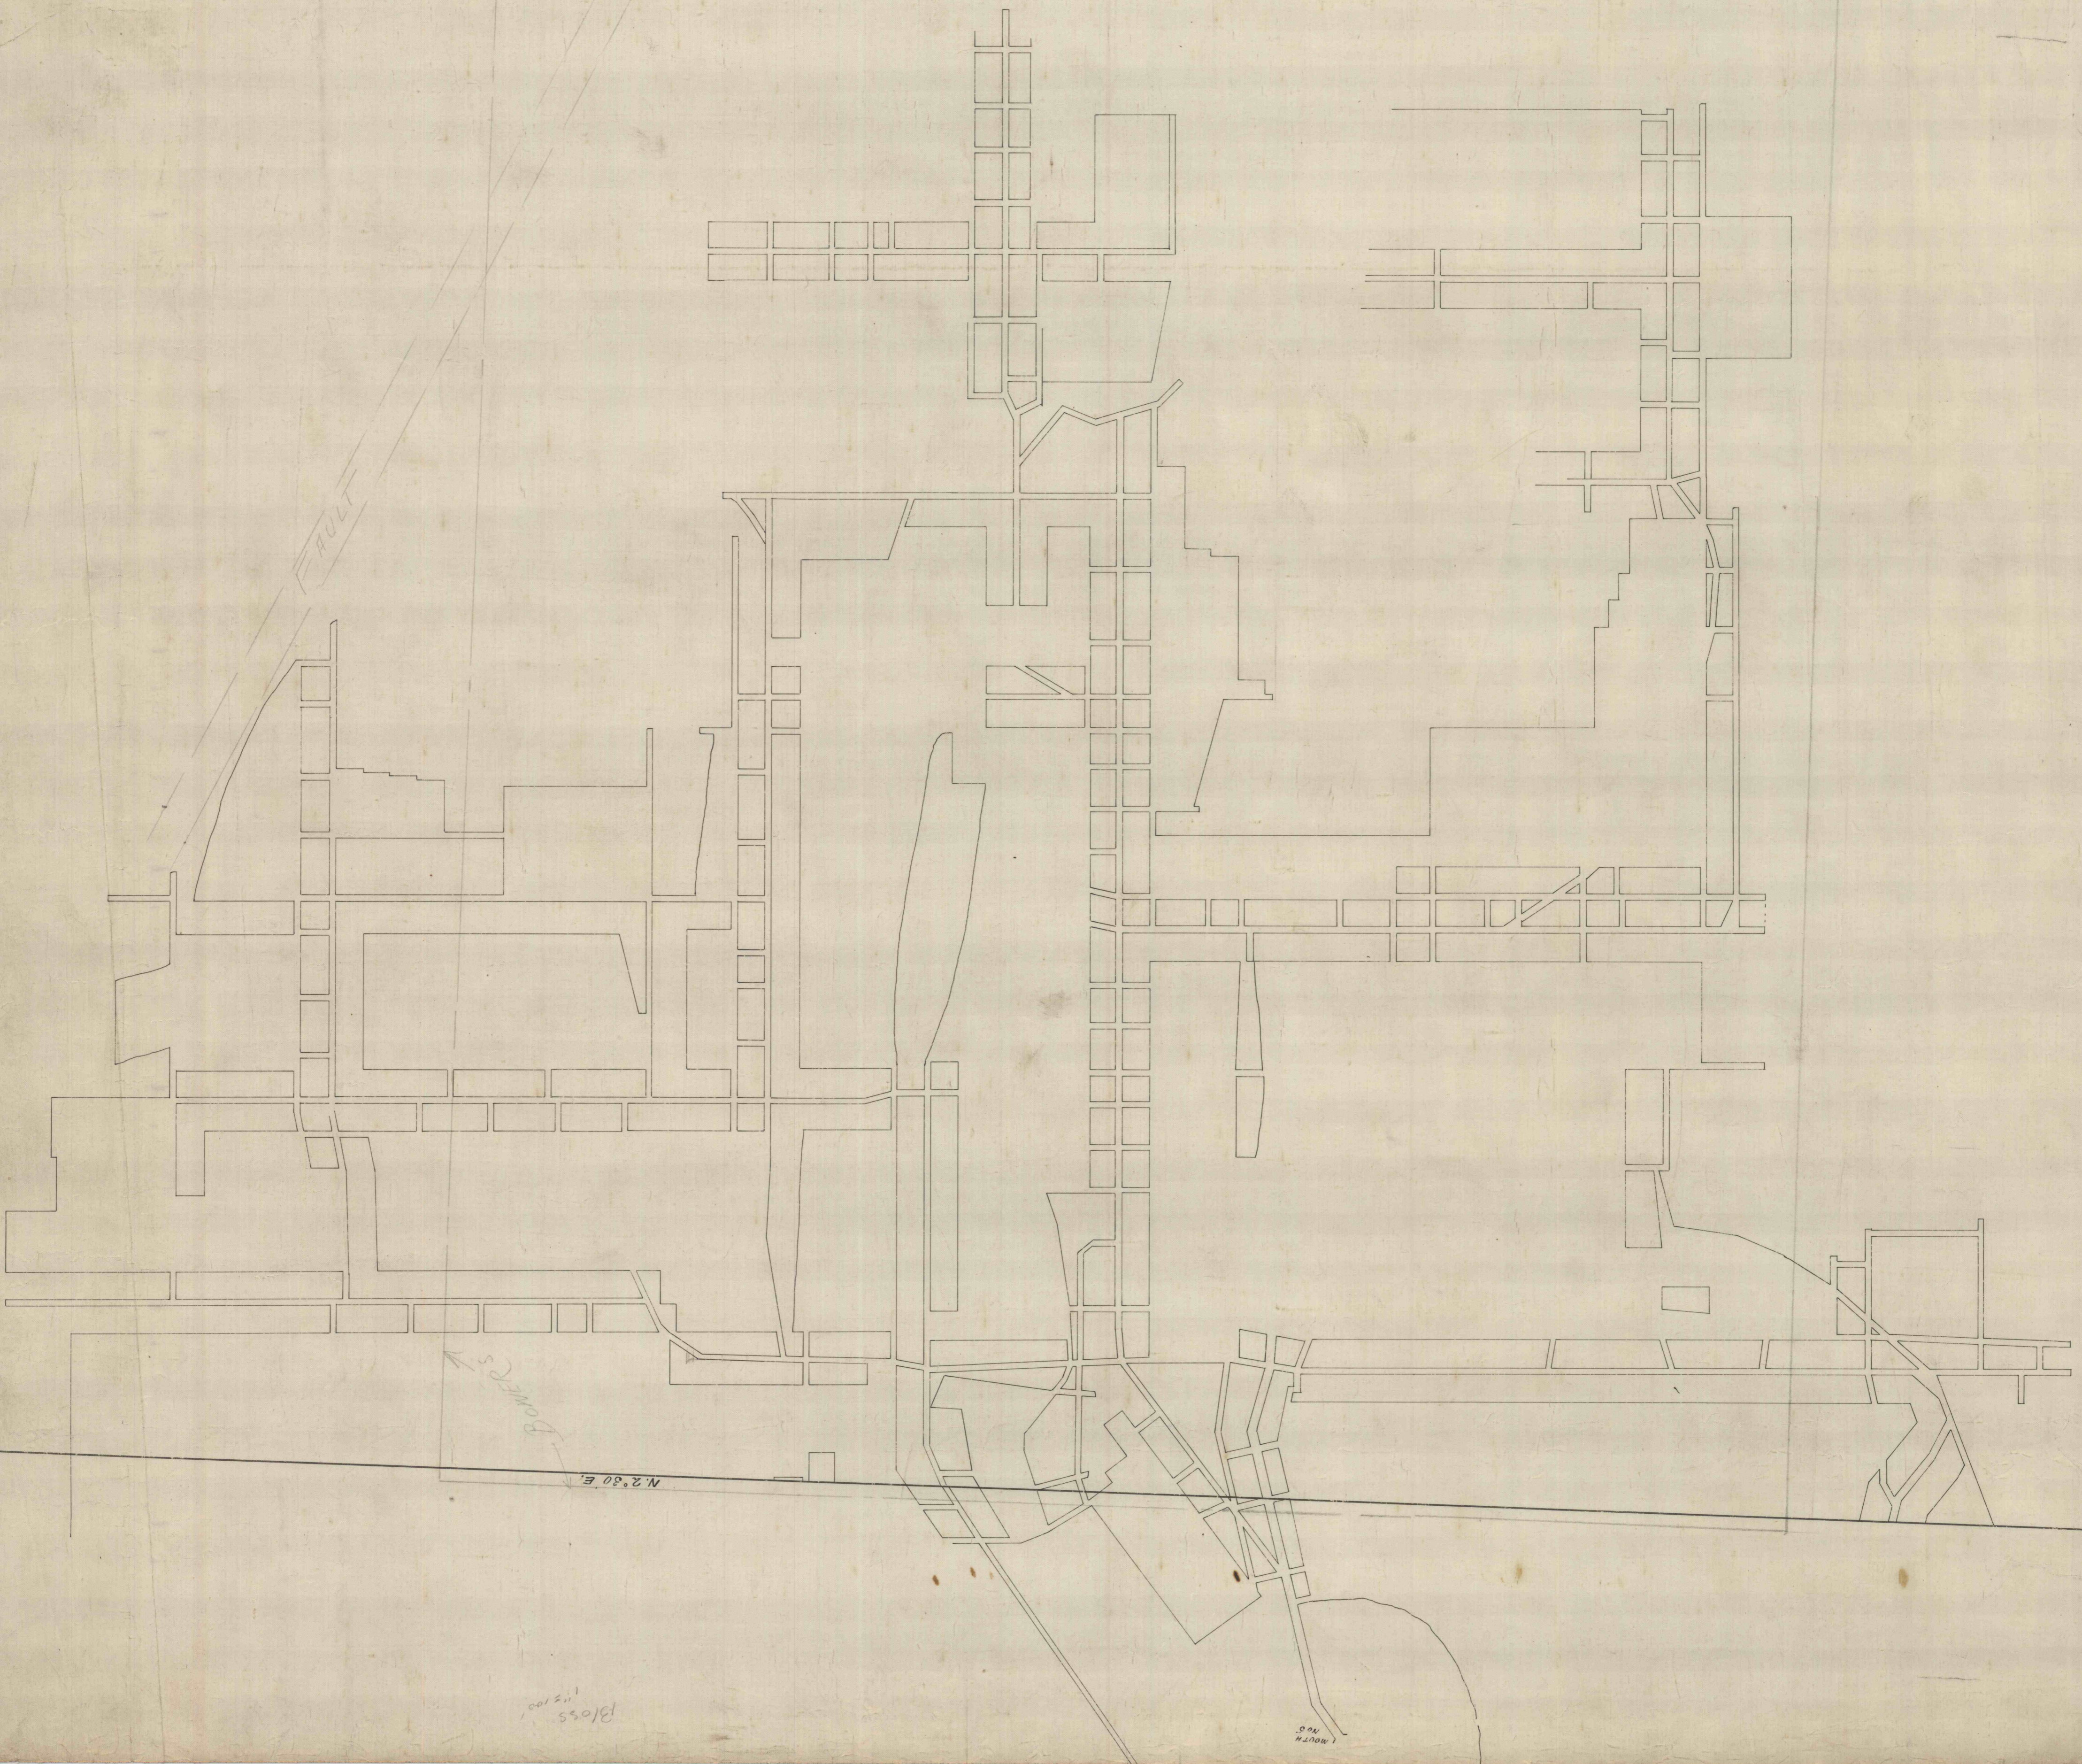

FAULT

Bloss
↑

N. 2° 30' E.

No. 3