


ASAPH REALTY Co.
 Original Scale 1" = 40 Rods - drawn by B. Kentz
 reduced to
 1" = 1000 feet - E.K. Koppe
 B-85
 Approximate Bare Hole Locations:
 Drill Series 1 - January, 1951
 2 - August + 1959

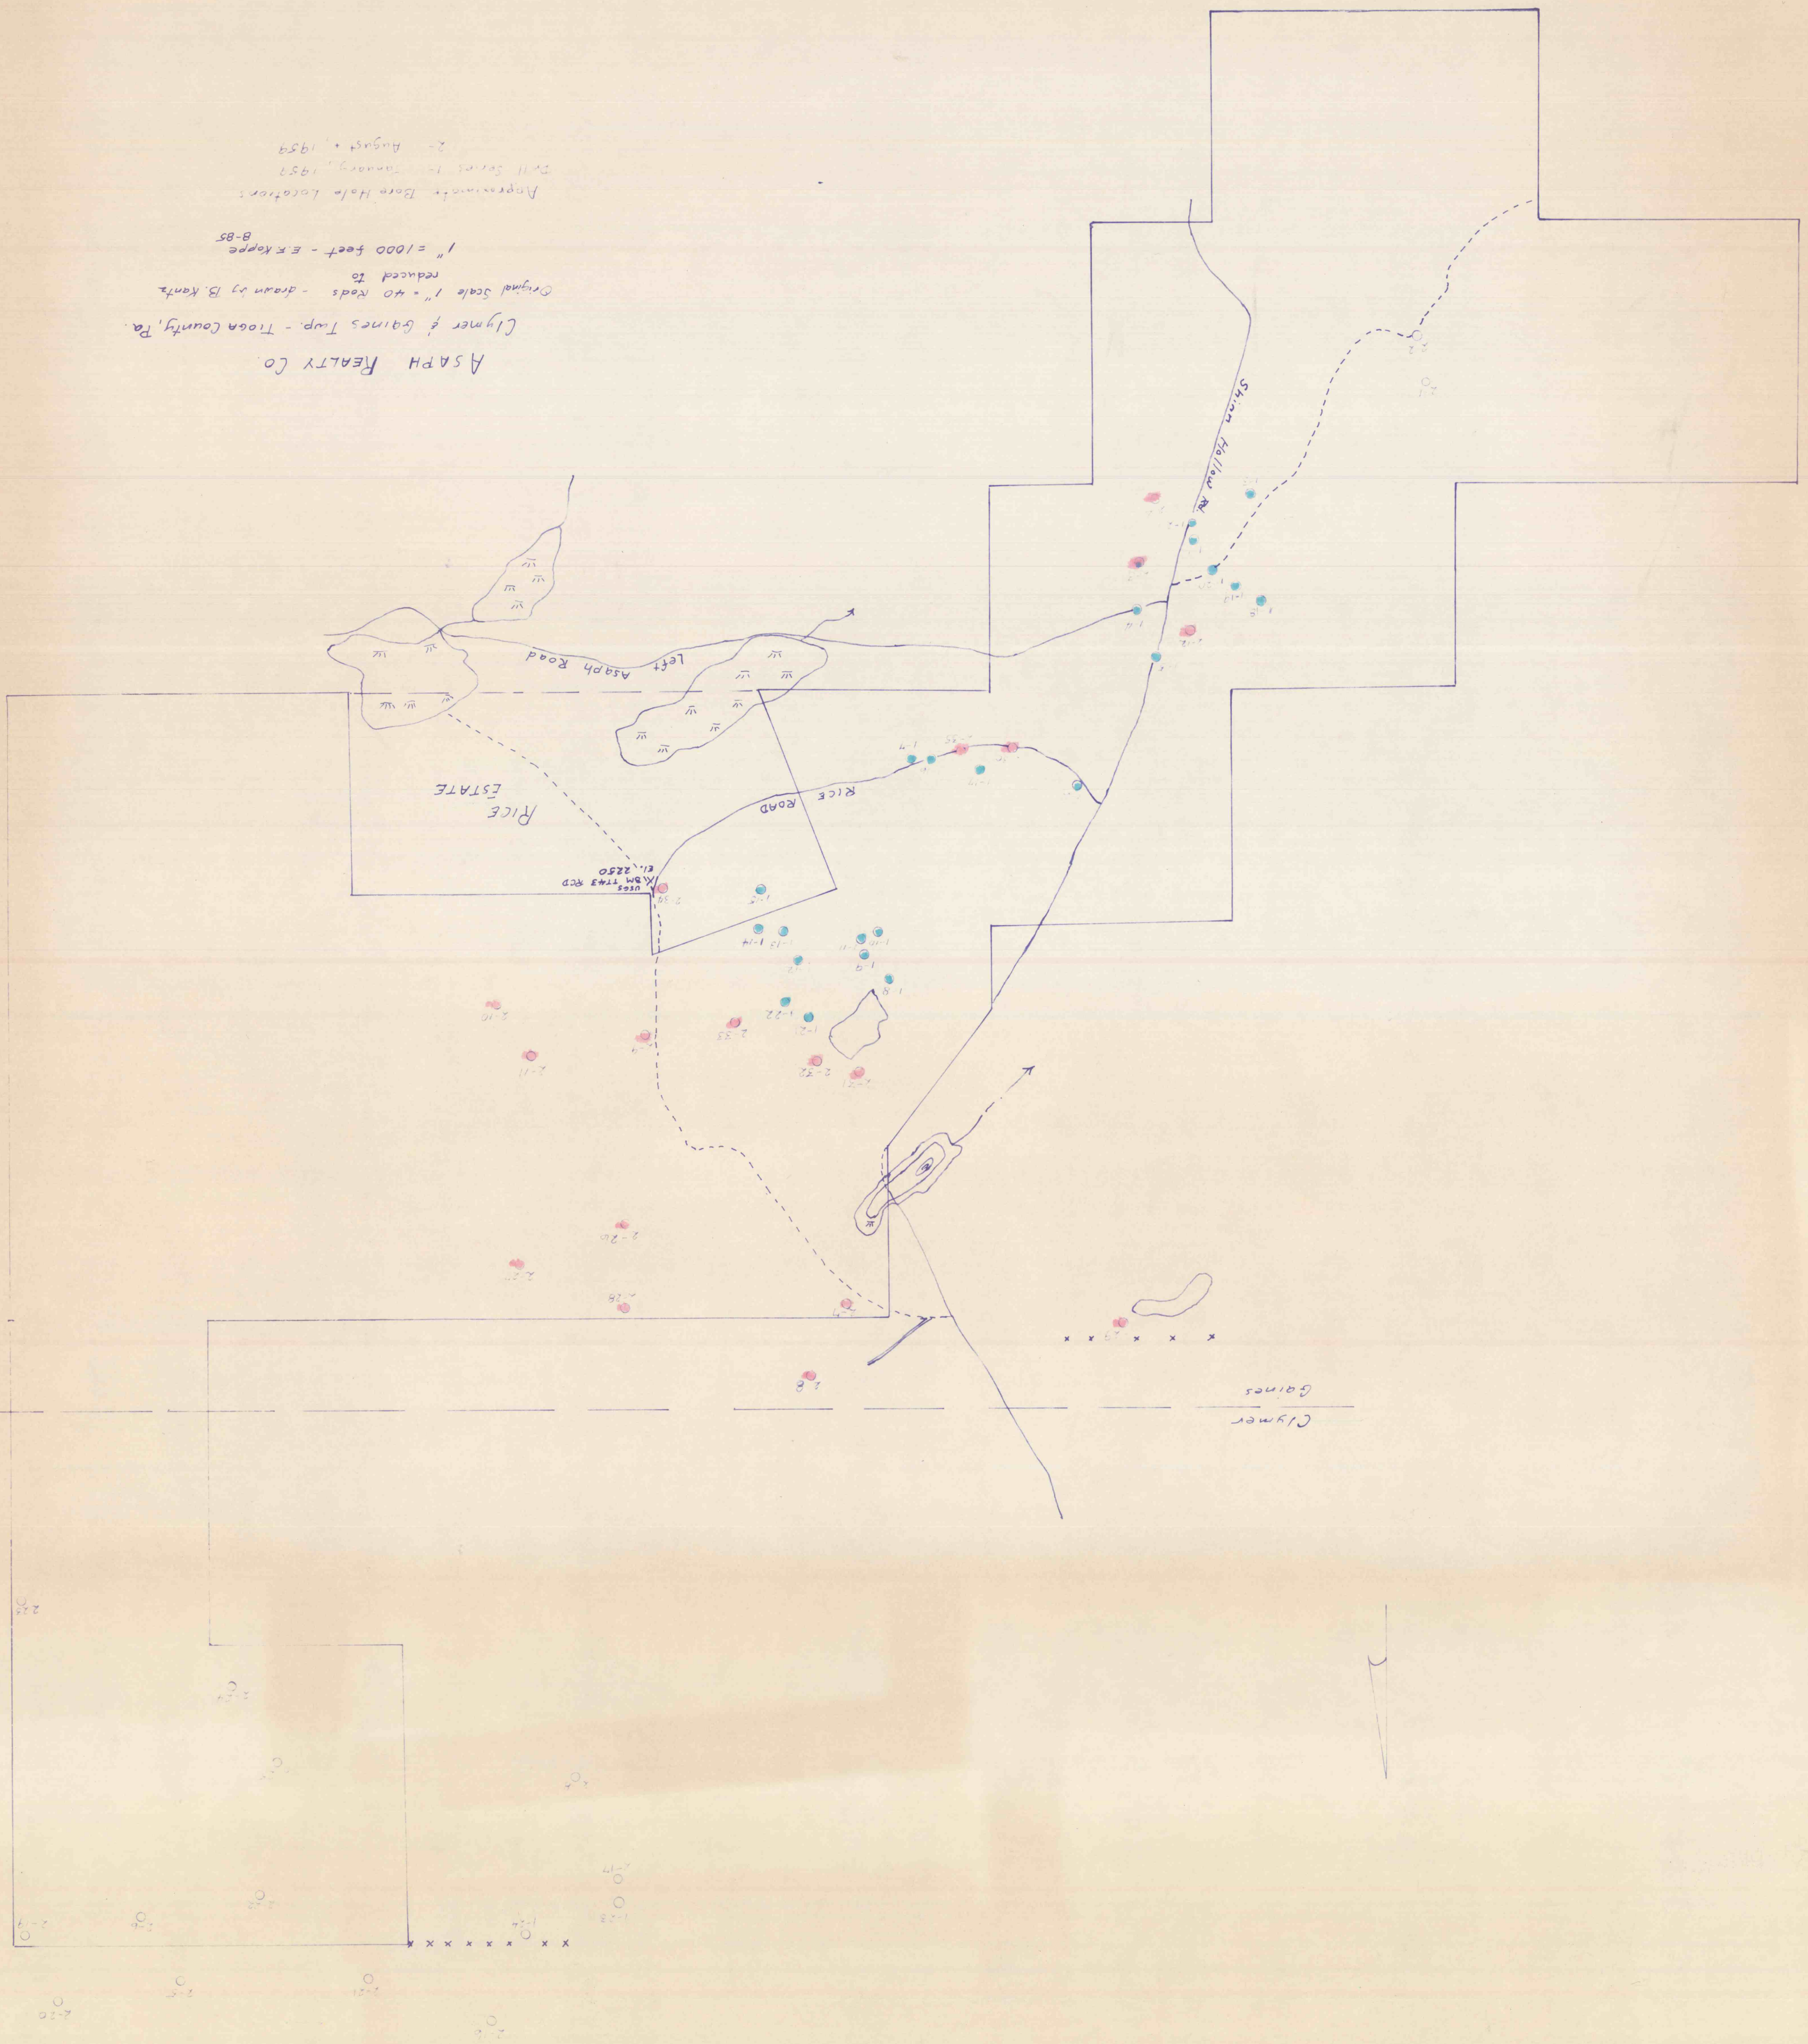

