



PDVMS

03052

224

24X

318455

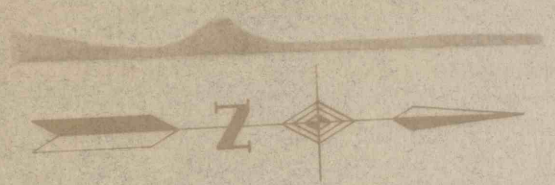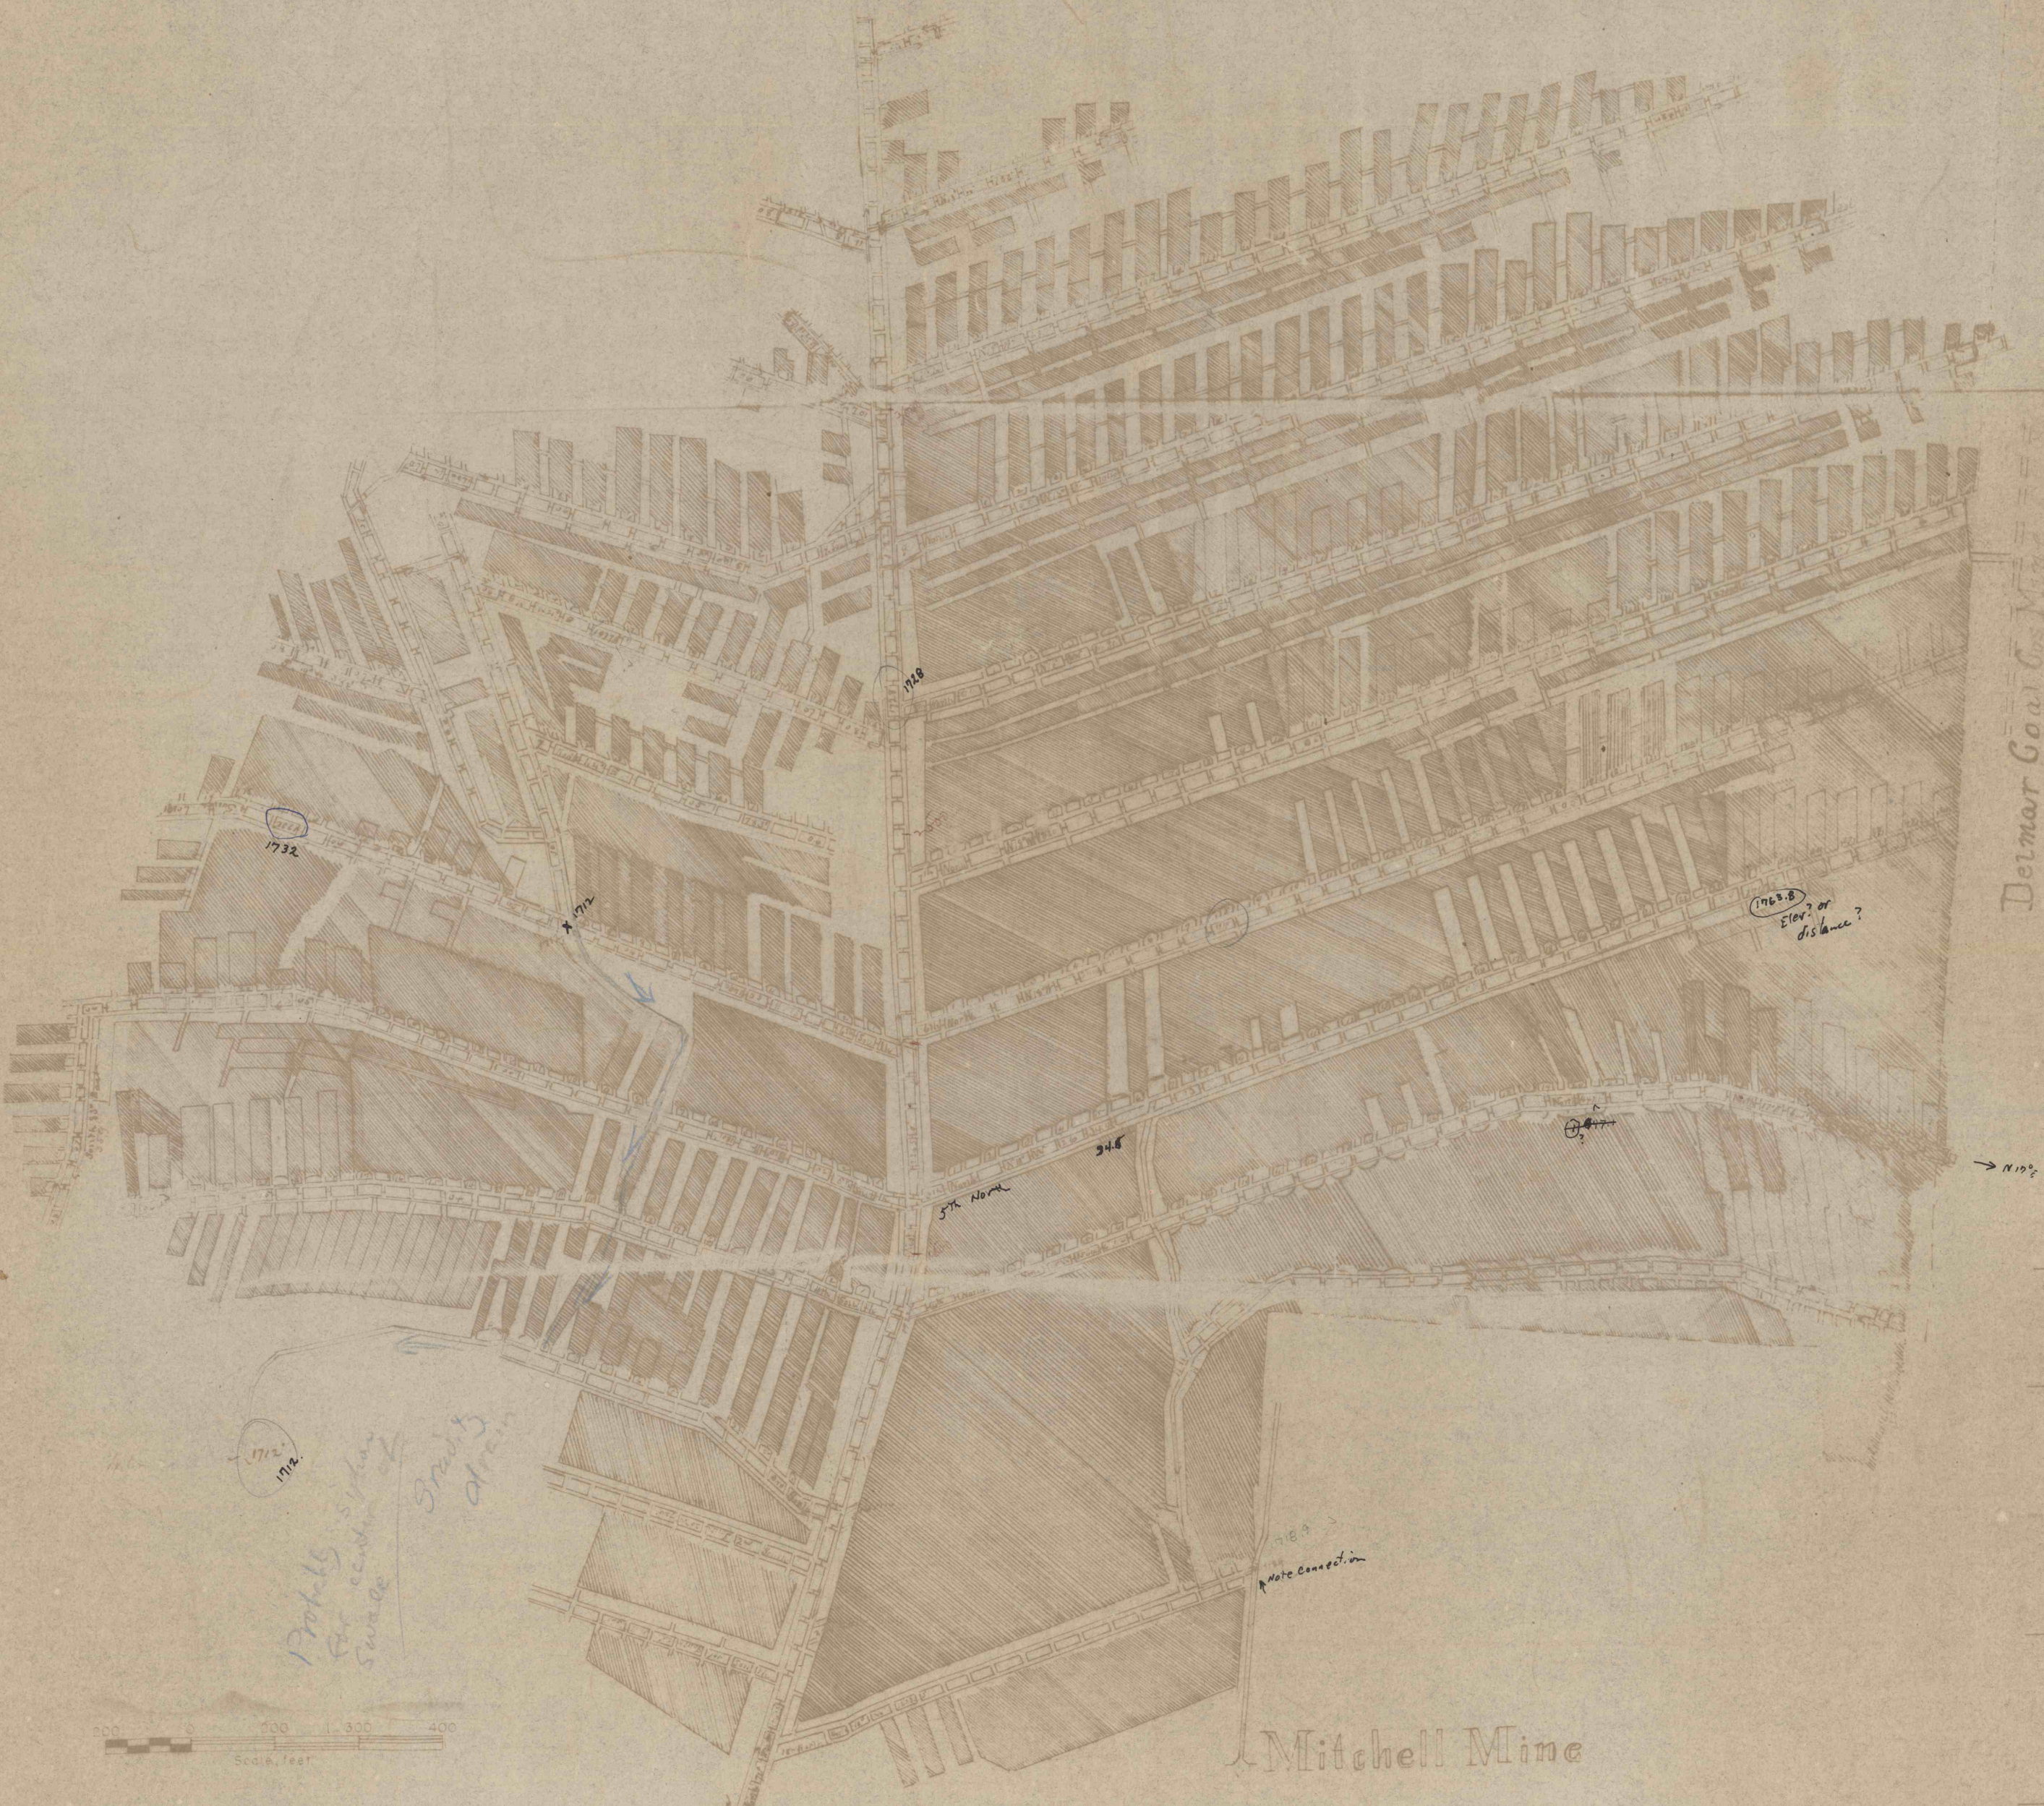

ANNA S

Mitchell Mine

Delmar Coal Co. Mine

Repro 11