



Photo taken
ANNA S

1" = 500'

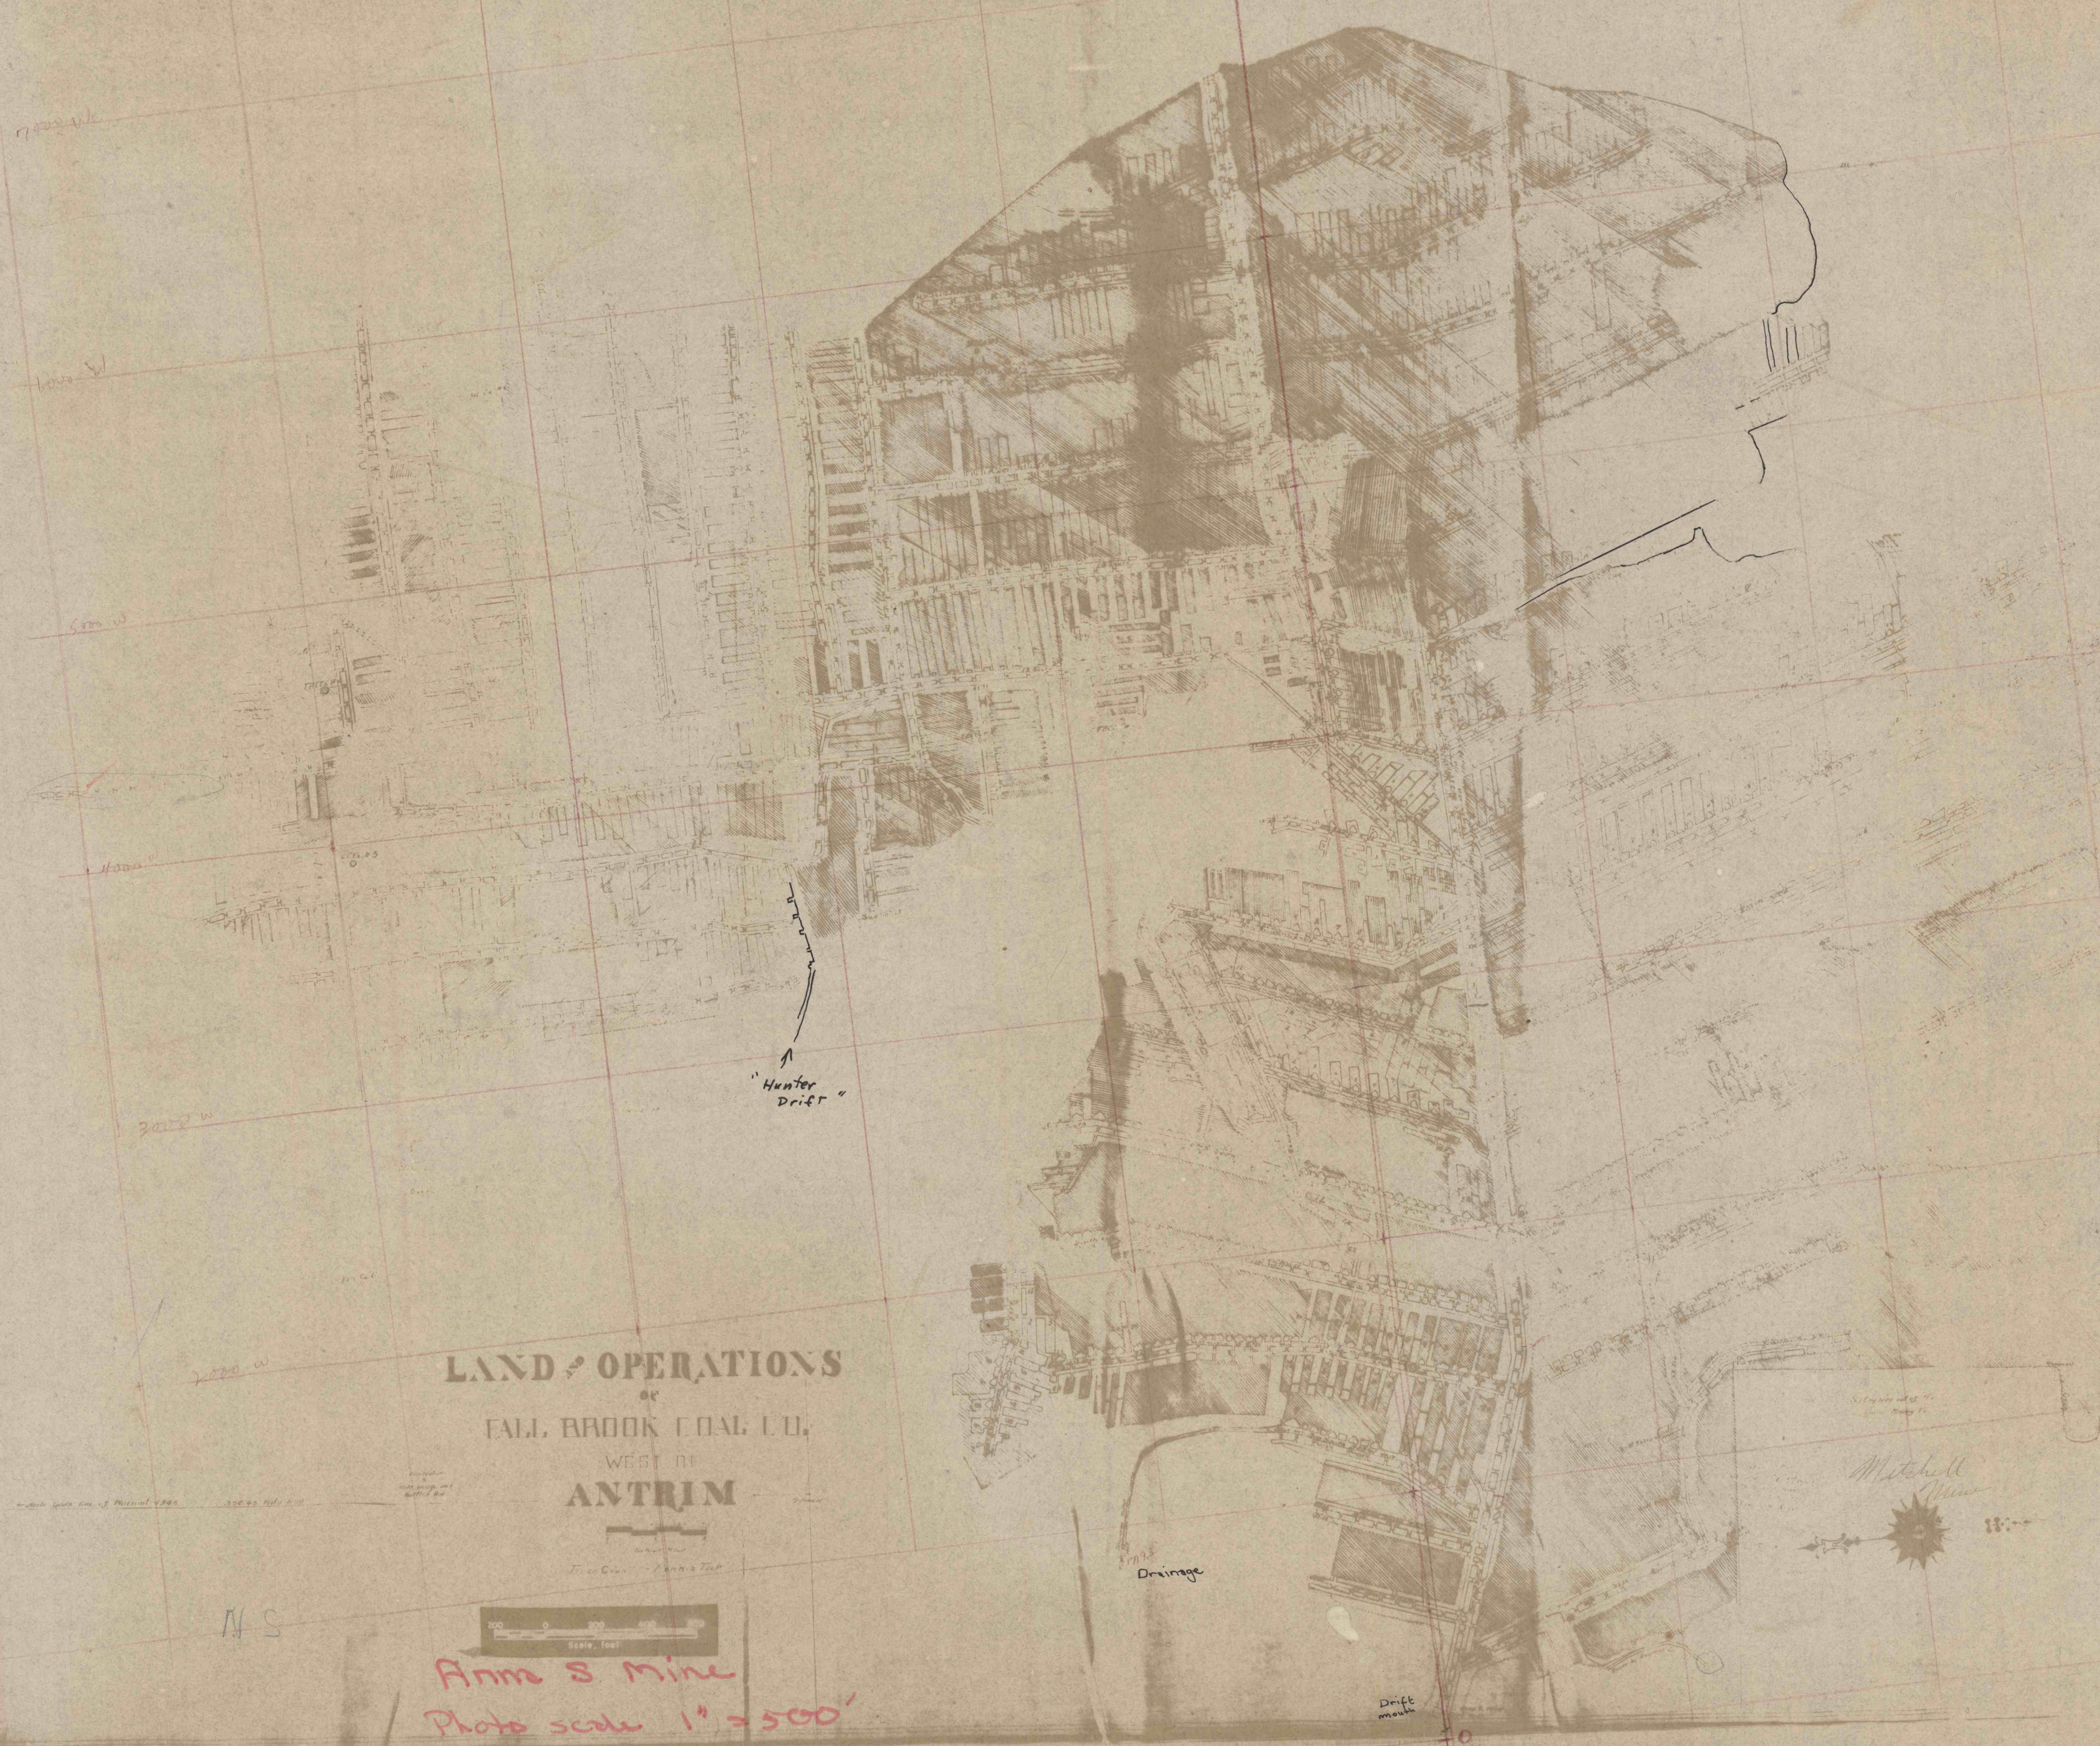

LAND OPERATIONS
 of
 FALL BROOK COAL CO.,
 WEST OF
 ANTRIM

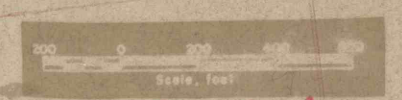

Anna S Mine
 Photo scale 1" = 500'

NS



03013 98 36X 30 3797