



PLAN VIEW
TEST HOLE LOCATIONS
SCALE 1" = 400 FEET

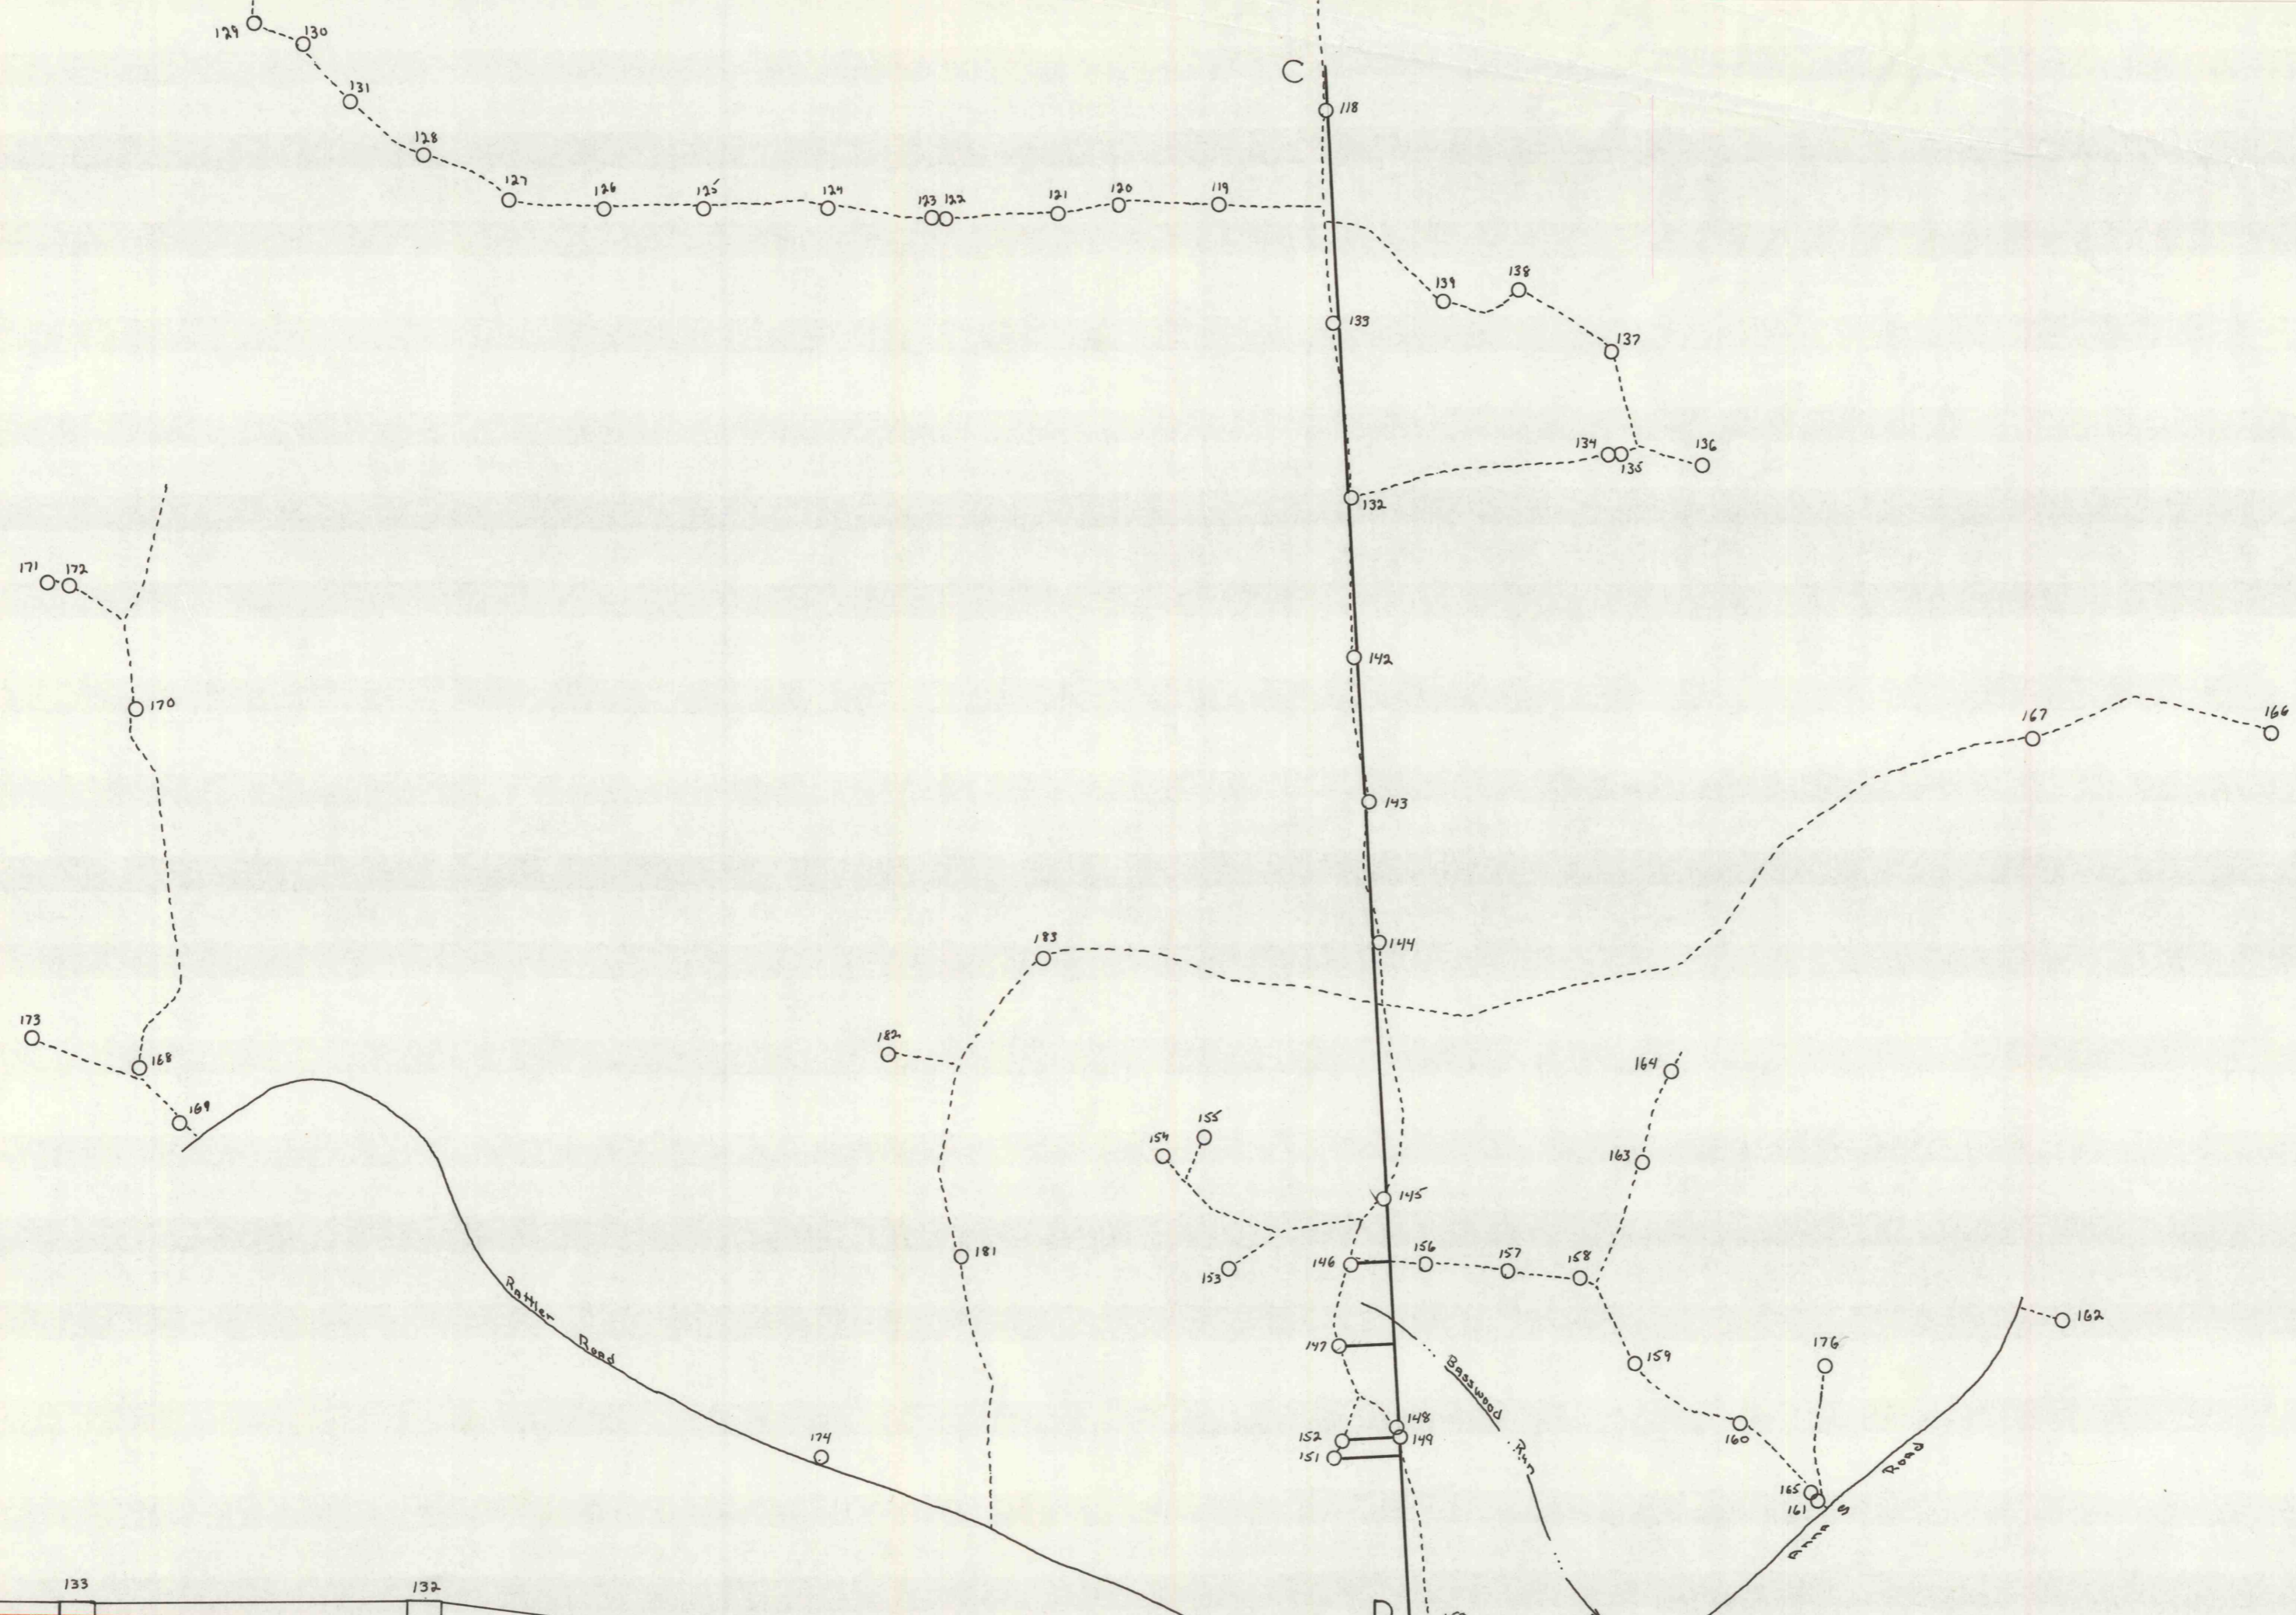

MAGNETIC
JULY 1979

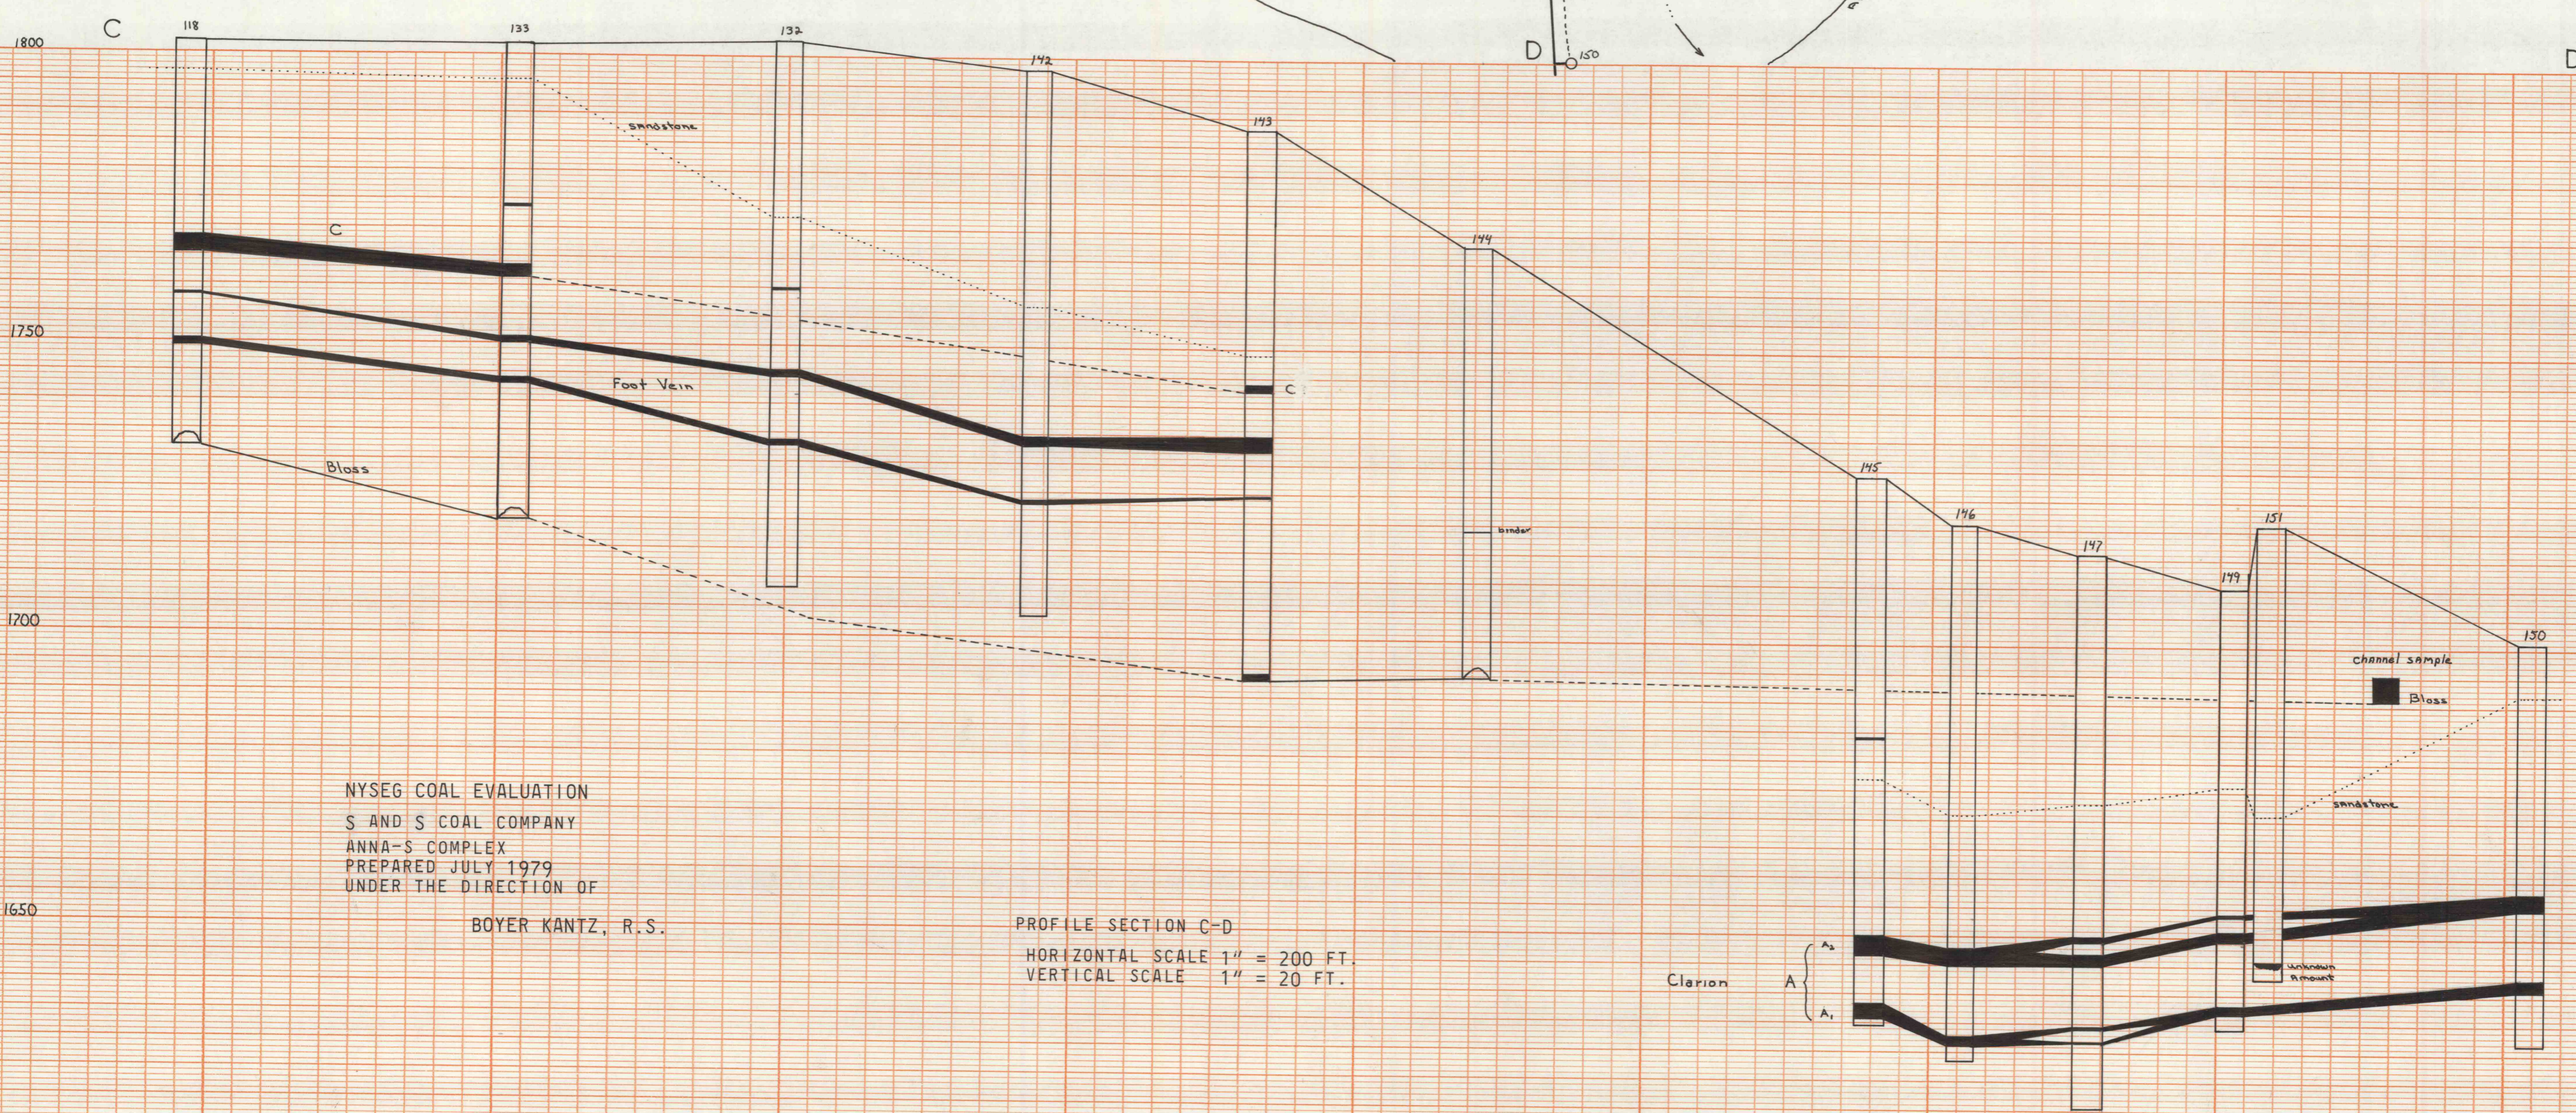

NYSEG COAL EVALUATION
S AND S COAL COMPANY
ANNA-S COMPLEX
PREPARED JULY 1979
UNDER THE DIRECTION OF
BOYER KANTZ, R.S.

PROFILE SECTION C-D
HORIZONTAL SCALE 1" = 200 FT.
VERTICAL SCALE 1" = 20 FT.

Clarion