


1719
1718
1717
1716
1715

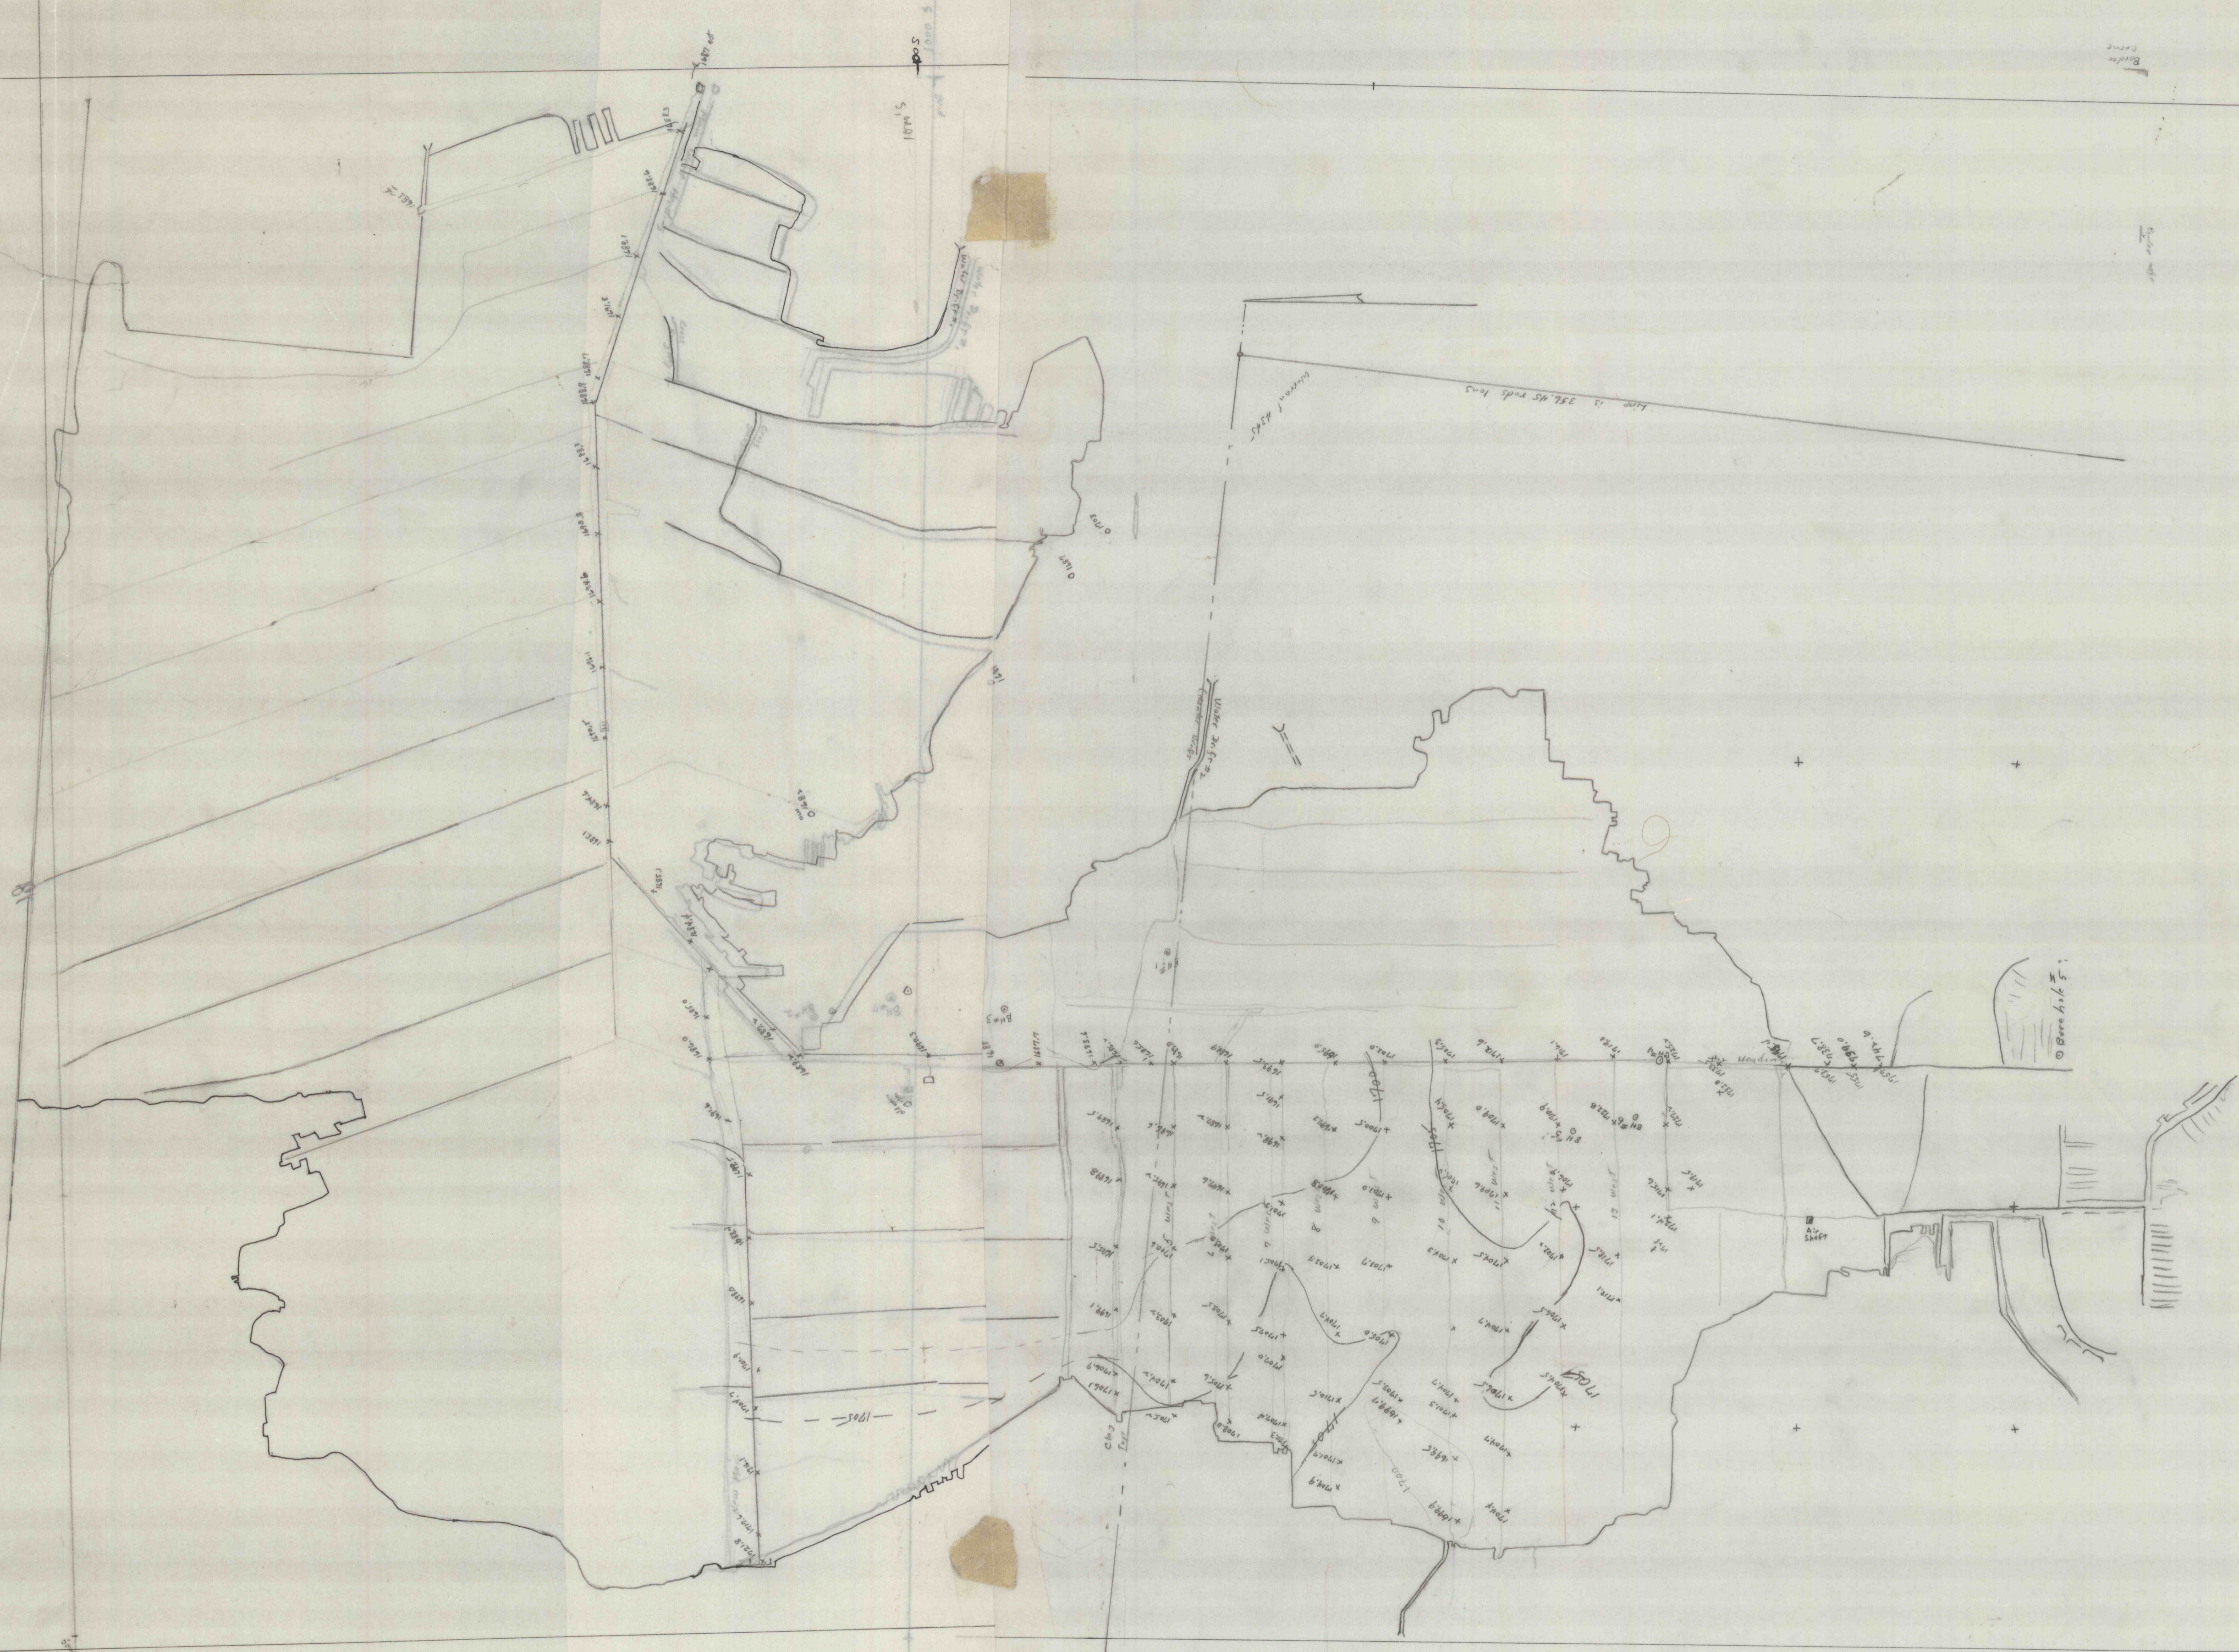

AMAS

+ 1015 to 1018
at 1899

1715