


APPROXIMATE LOCATION OF DELMAR TOWNSHIP LINE
APPROXIMATE LOCATION OF MORRIS TOWNSHIP LINE

DEPARTMENT OF FOREST AND WATERS
STATE GAME LANDS

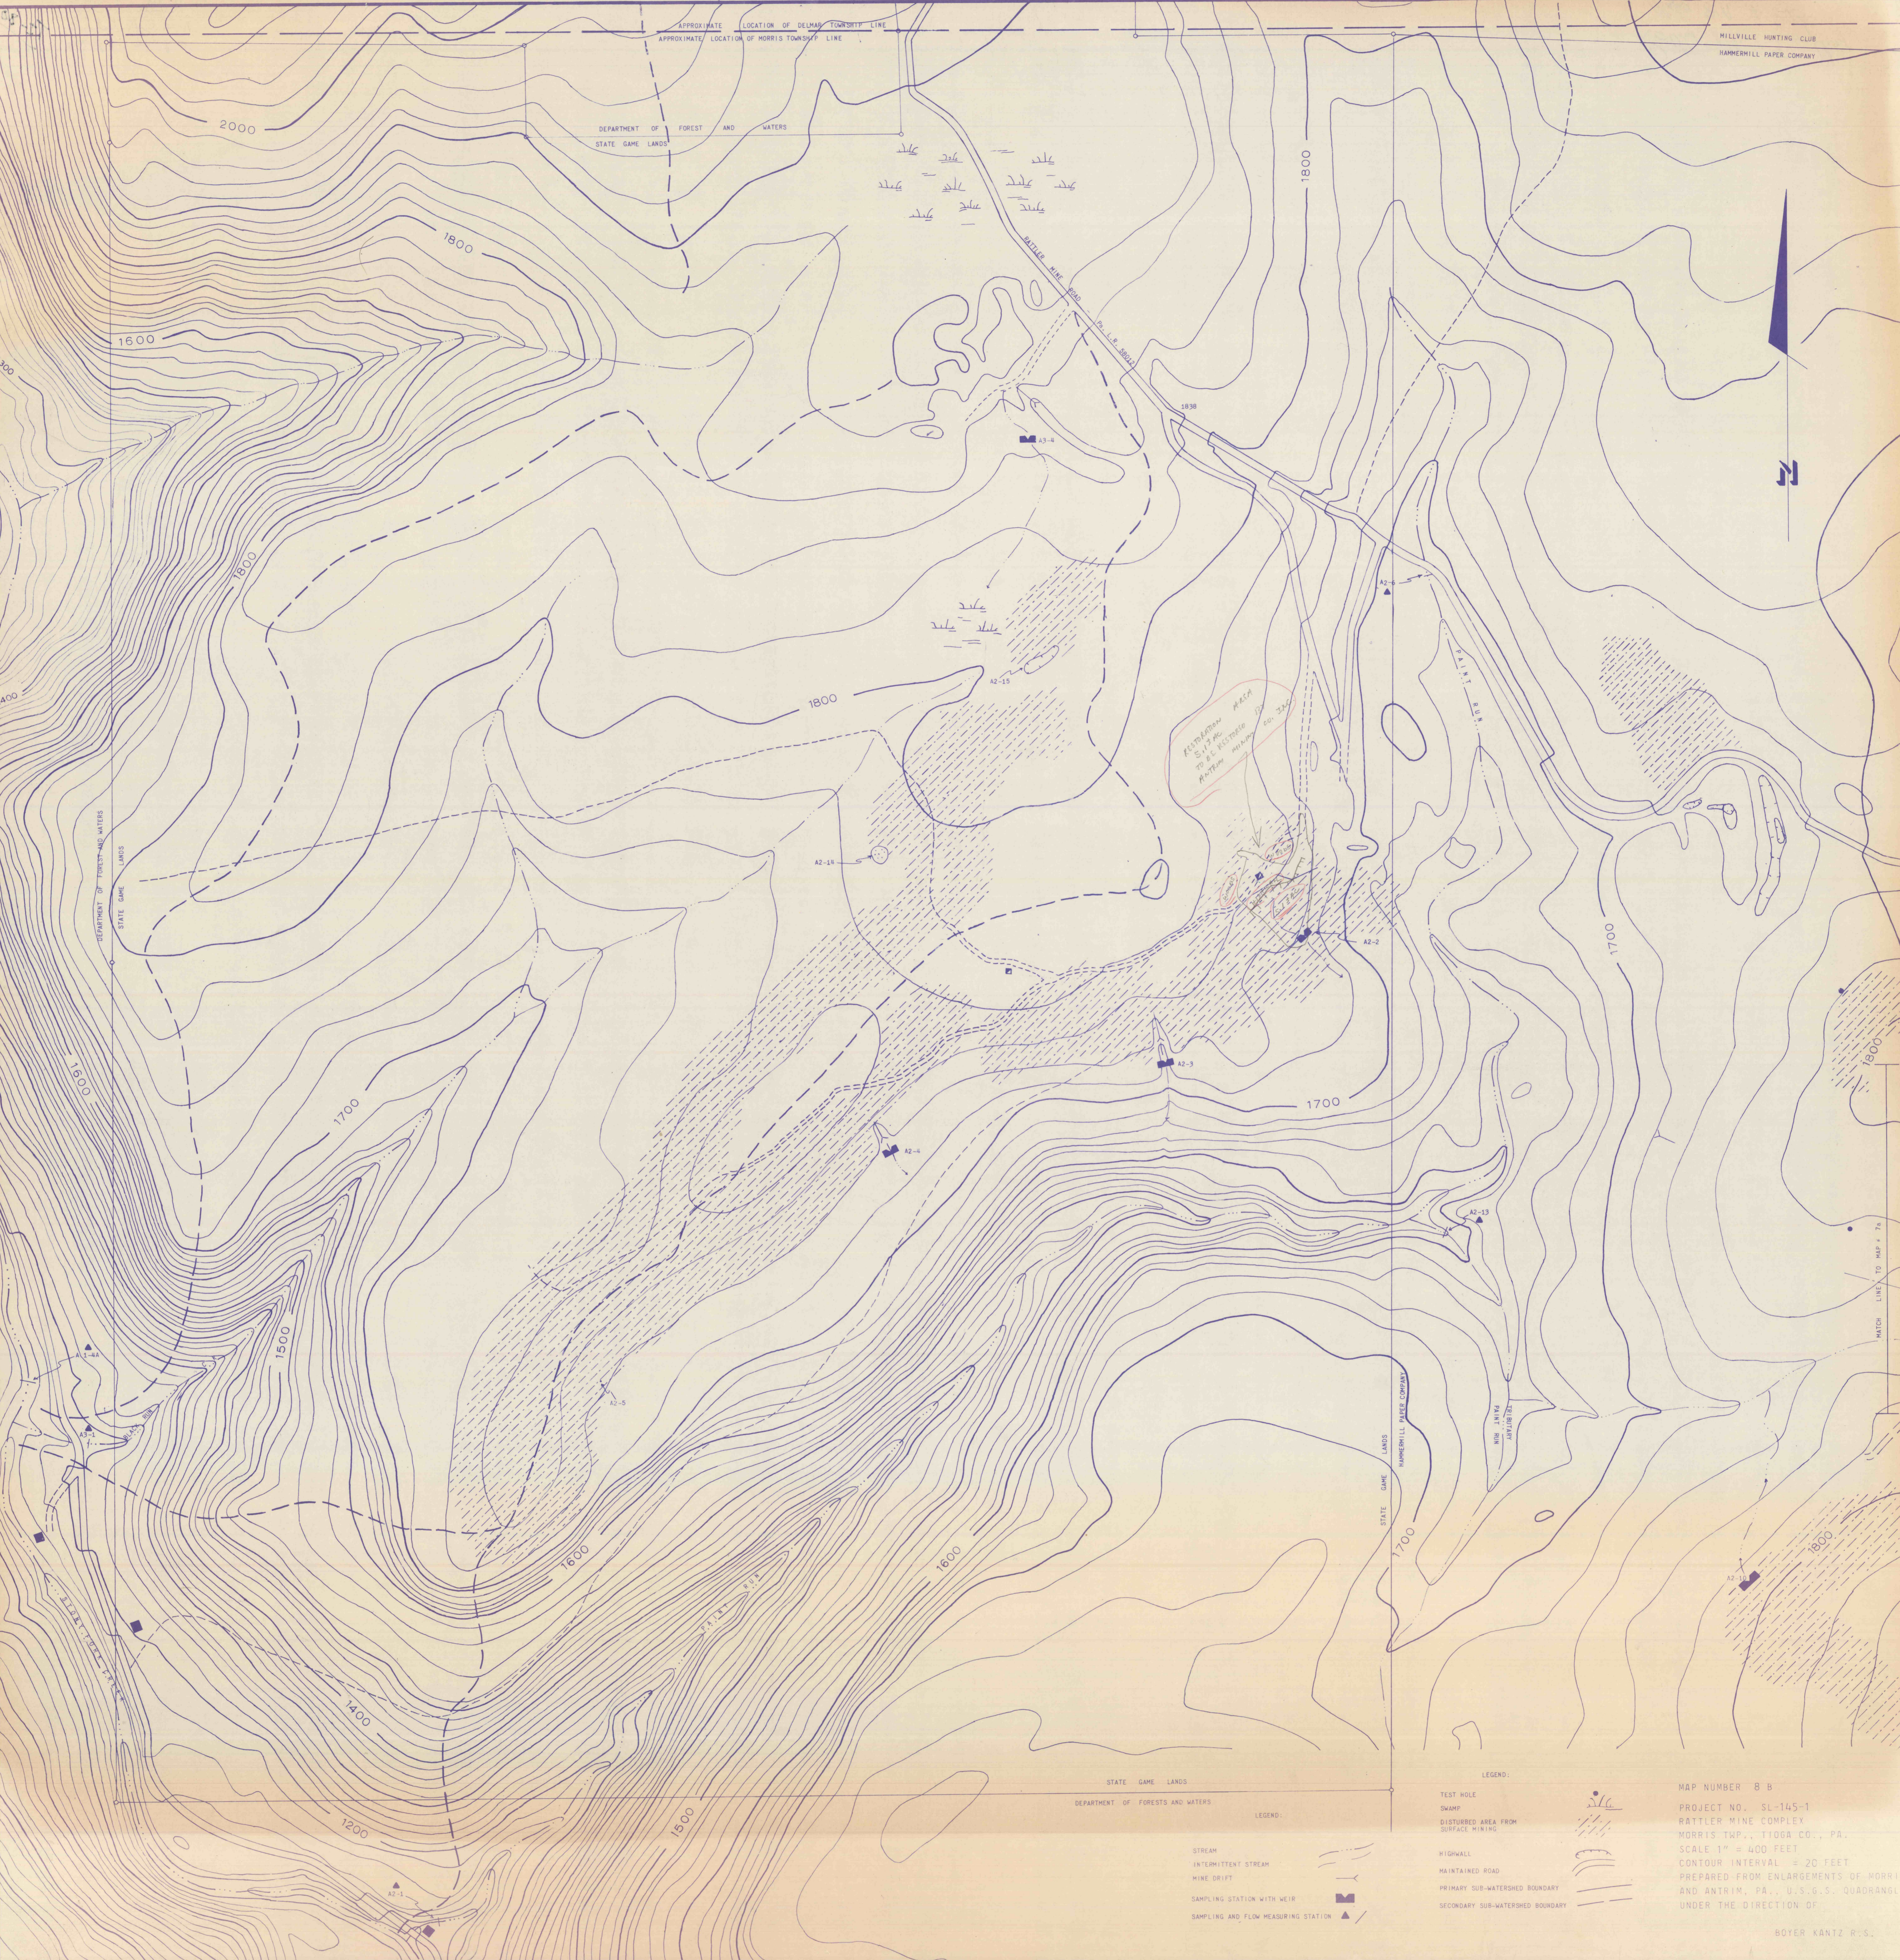

STATE GAME LANDS
DEPARTMENT OF FORESTS AND WATERS

LEGEND:

- STREAM
- INTERMITTENT STREAM
- WINE DRIFT
- SAMPLING STATION WITH WEIR
- SAMPLING AND FLOW MEASURING STATION

LEGEND:

- TEST HOLE
- SWAMP
- DISTURBED AREA FROM SURFACE MARKING
- HIGHWALL
- MAINTAINED ROAD
- PRIMARY SUB-WATERSHED BOUNDARY
- SECONDARY SUB-WATERSHED BOUNDARY

MAP NUMBER 8 B

PROJECT NO. SL-145-1
 RATTLER MINE COMPLEX
 MORRIS TWP., TIOGA CO., PA.
 SCALE 1" = 400 FEET
 CONTOUR INTERVAL = 20 FEET
 PREPARED FROM ENLARGEMENTS OF MORRIS
 AND ANTRIM, PA., U.S.G.S. QUADRANGLES
 UNDER THE DIRECTION OF