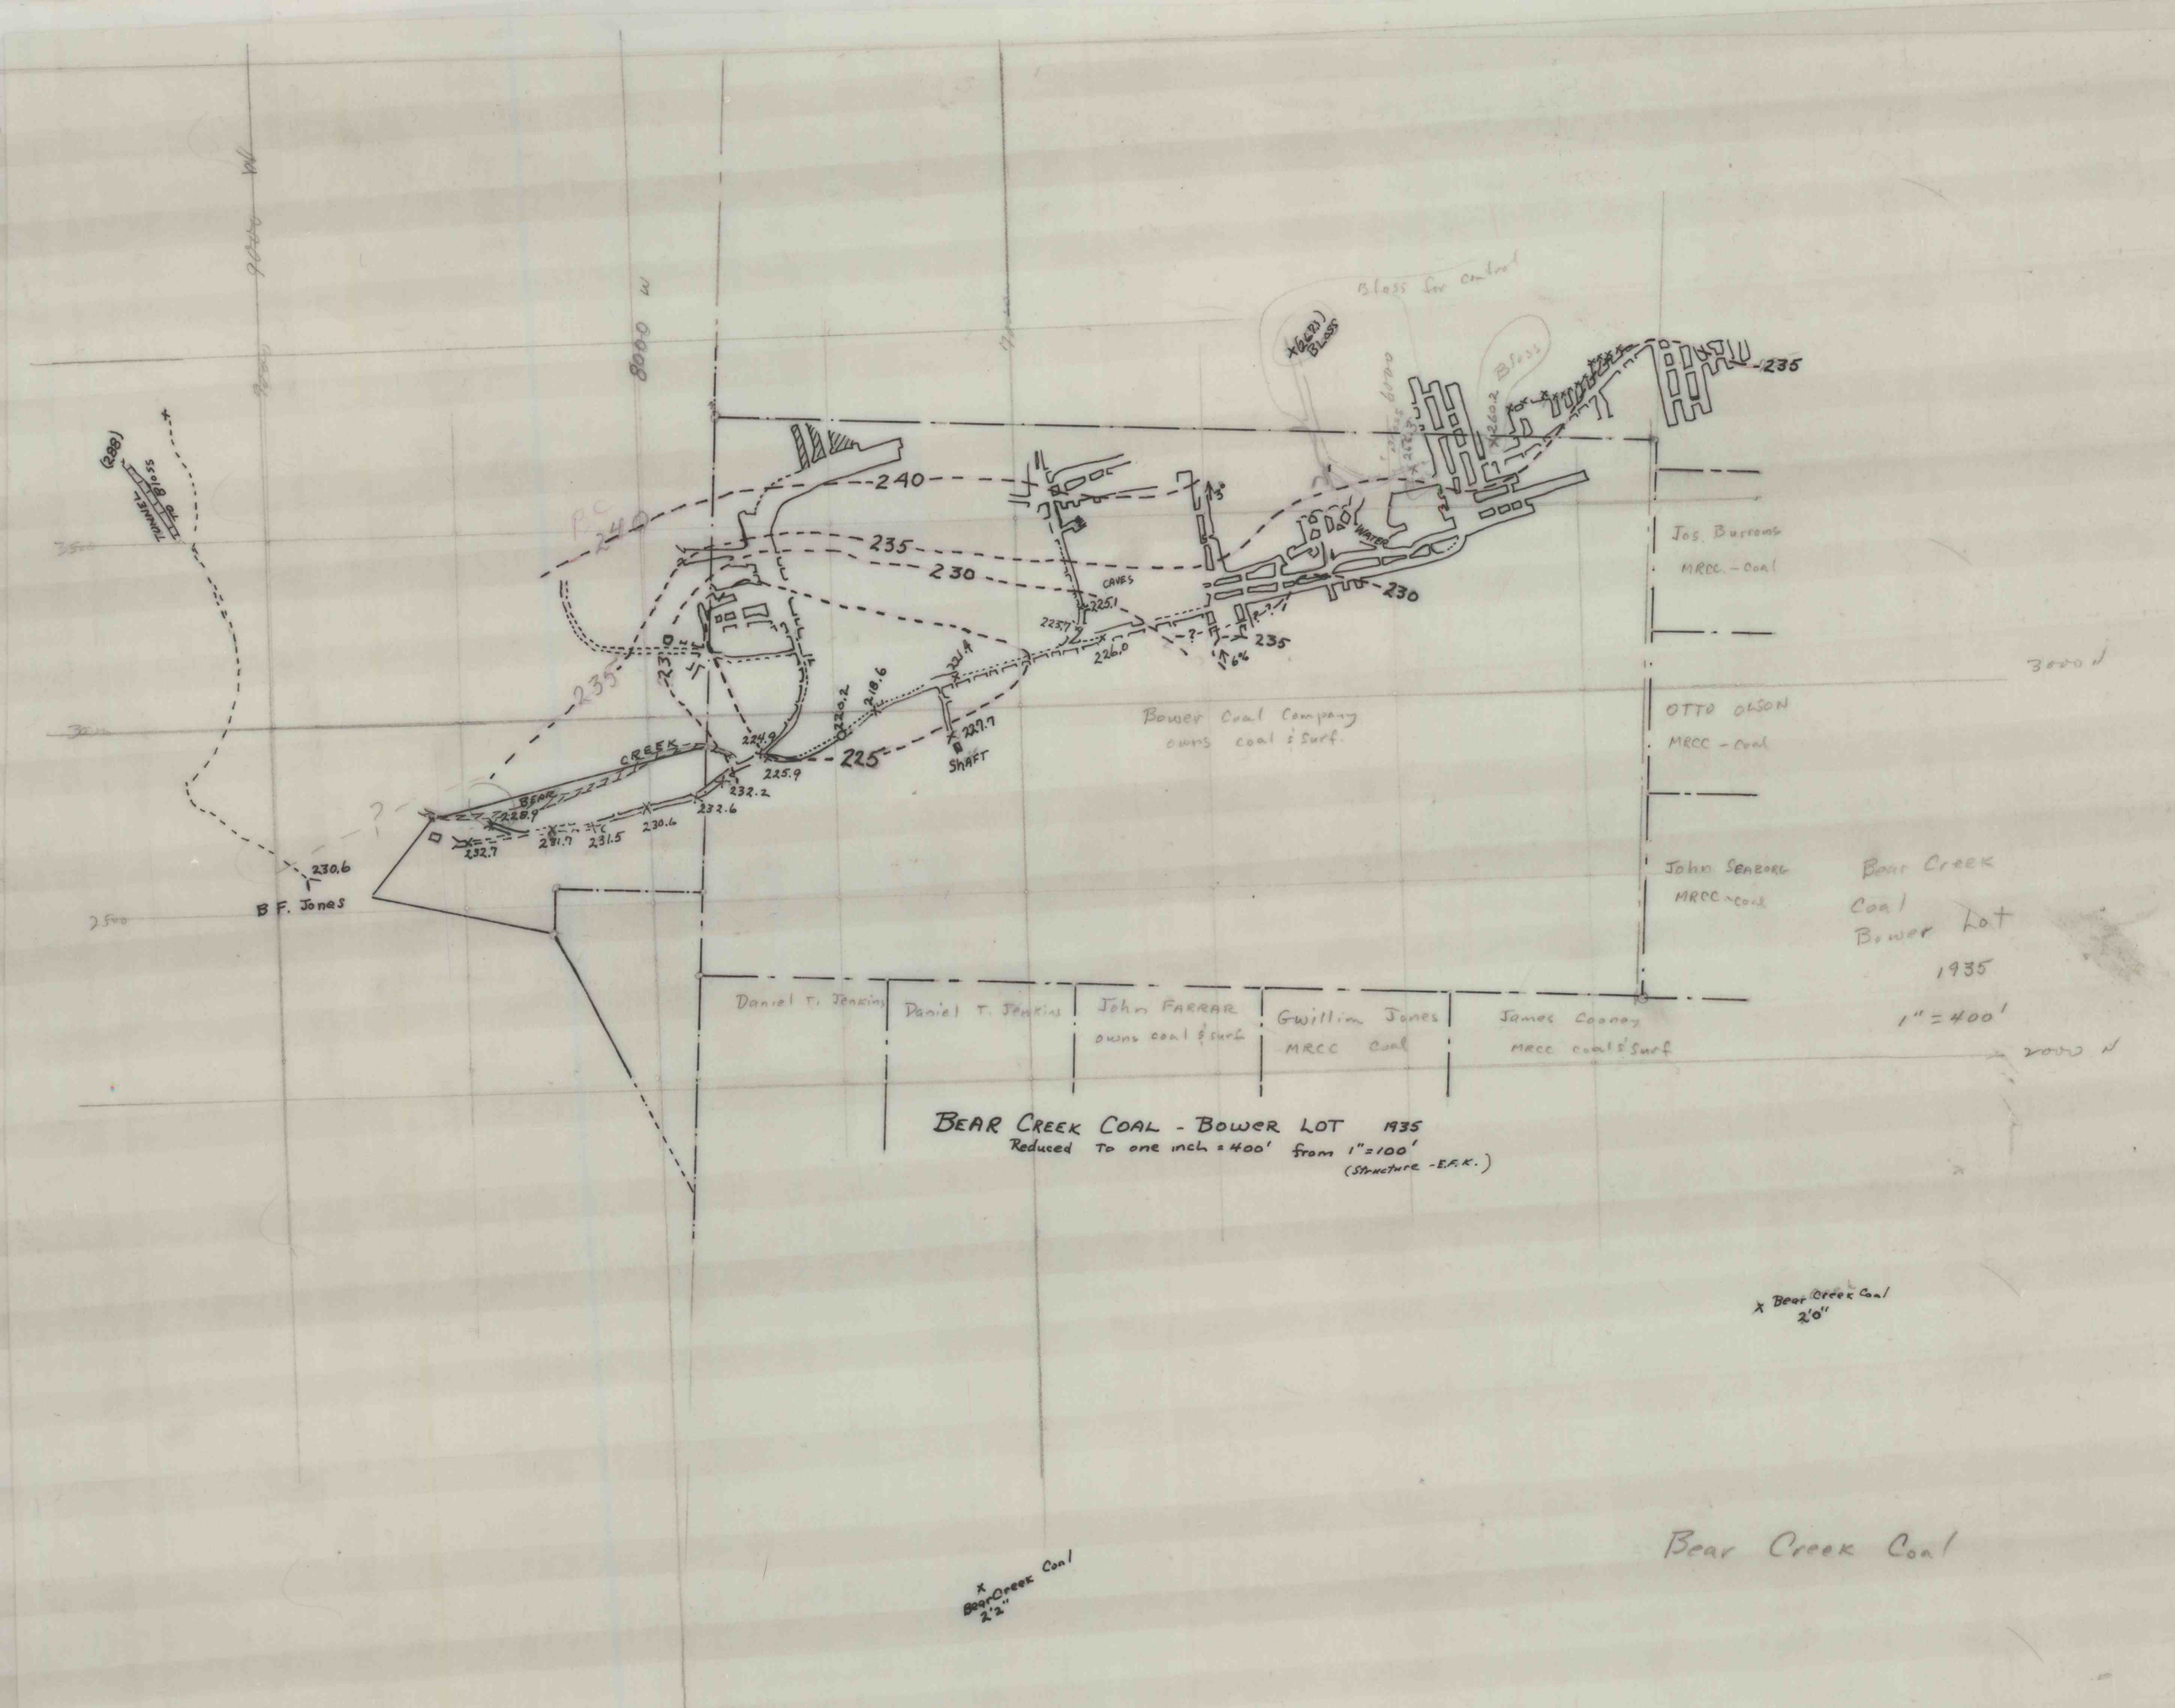

BEAR CREEK COAL - BOWER LOT 1935
Reduced to one inch = 400' from 1" = 100'
(Structure - E.F.K.)