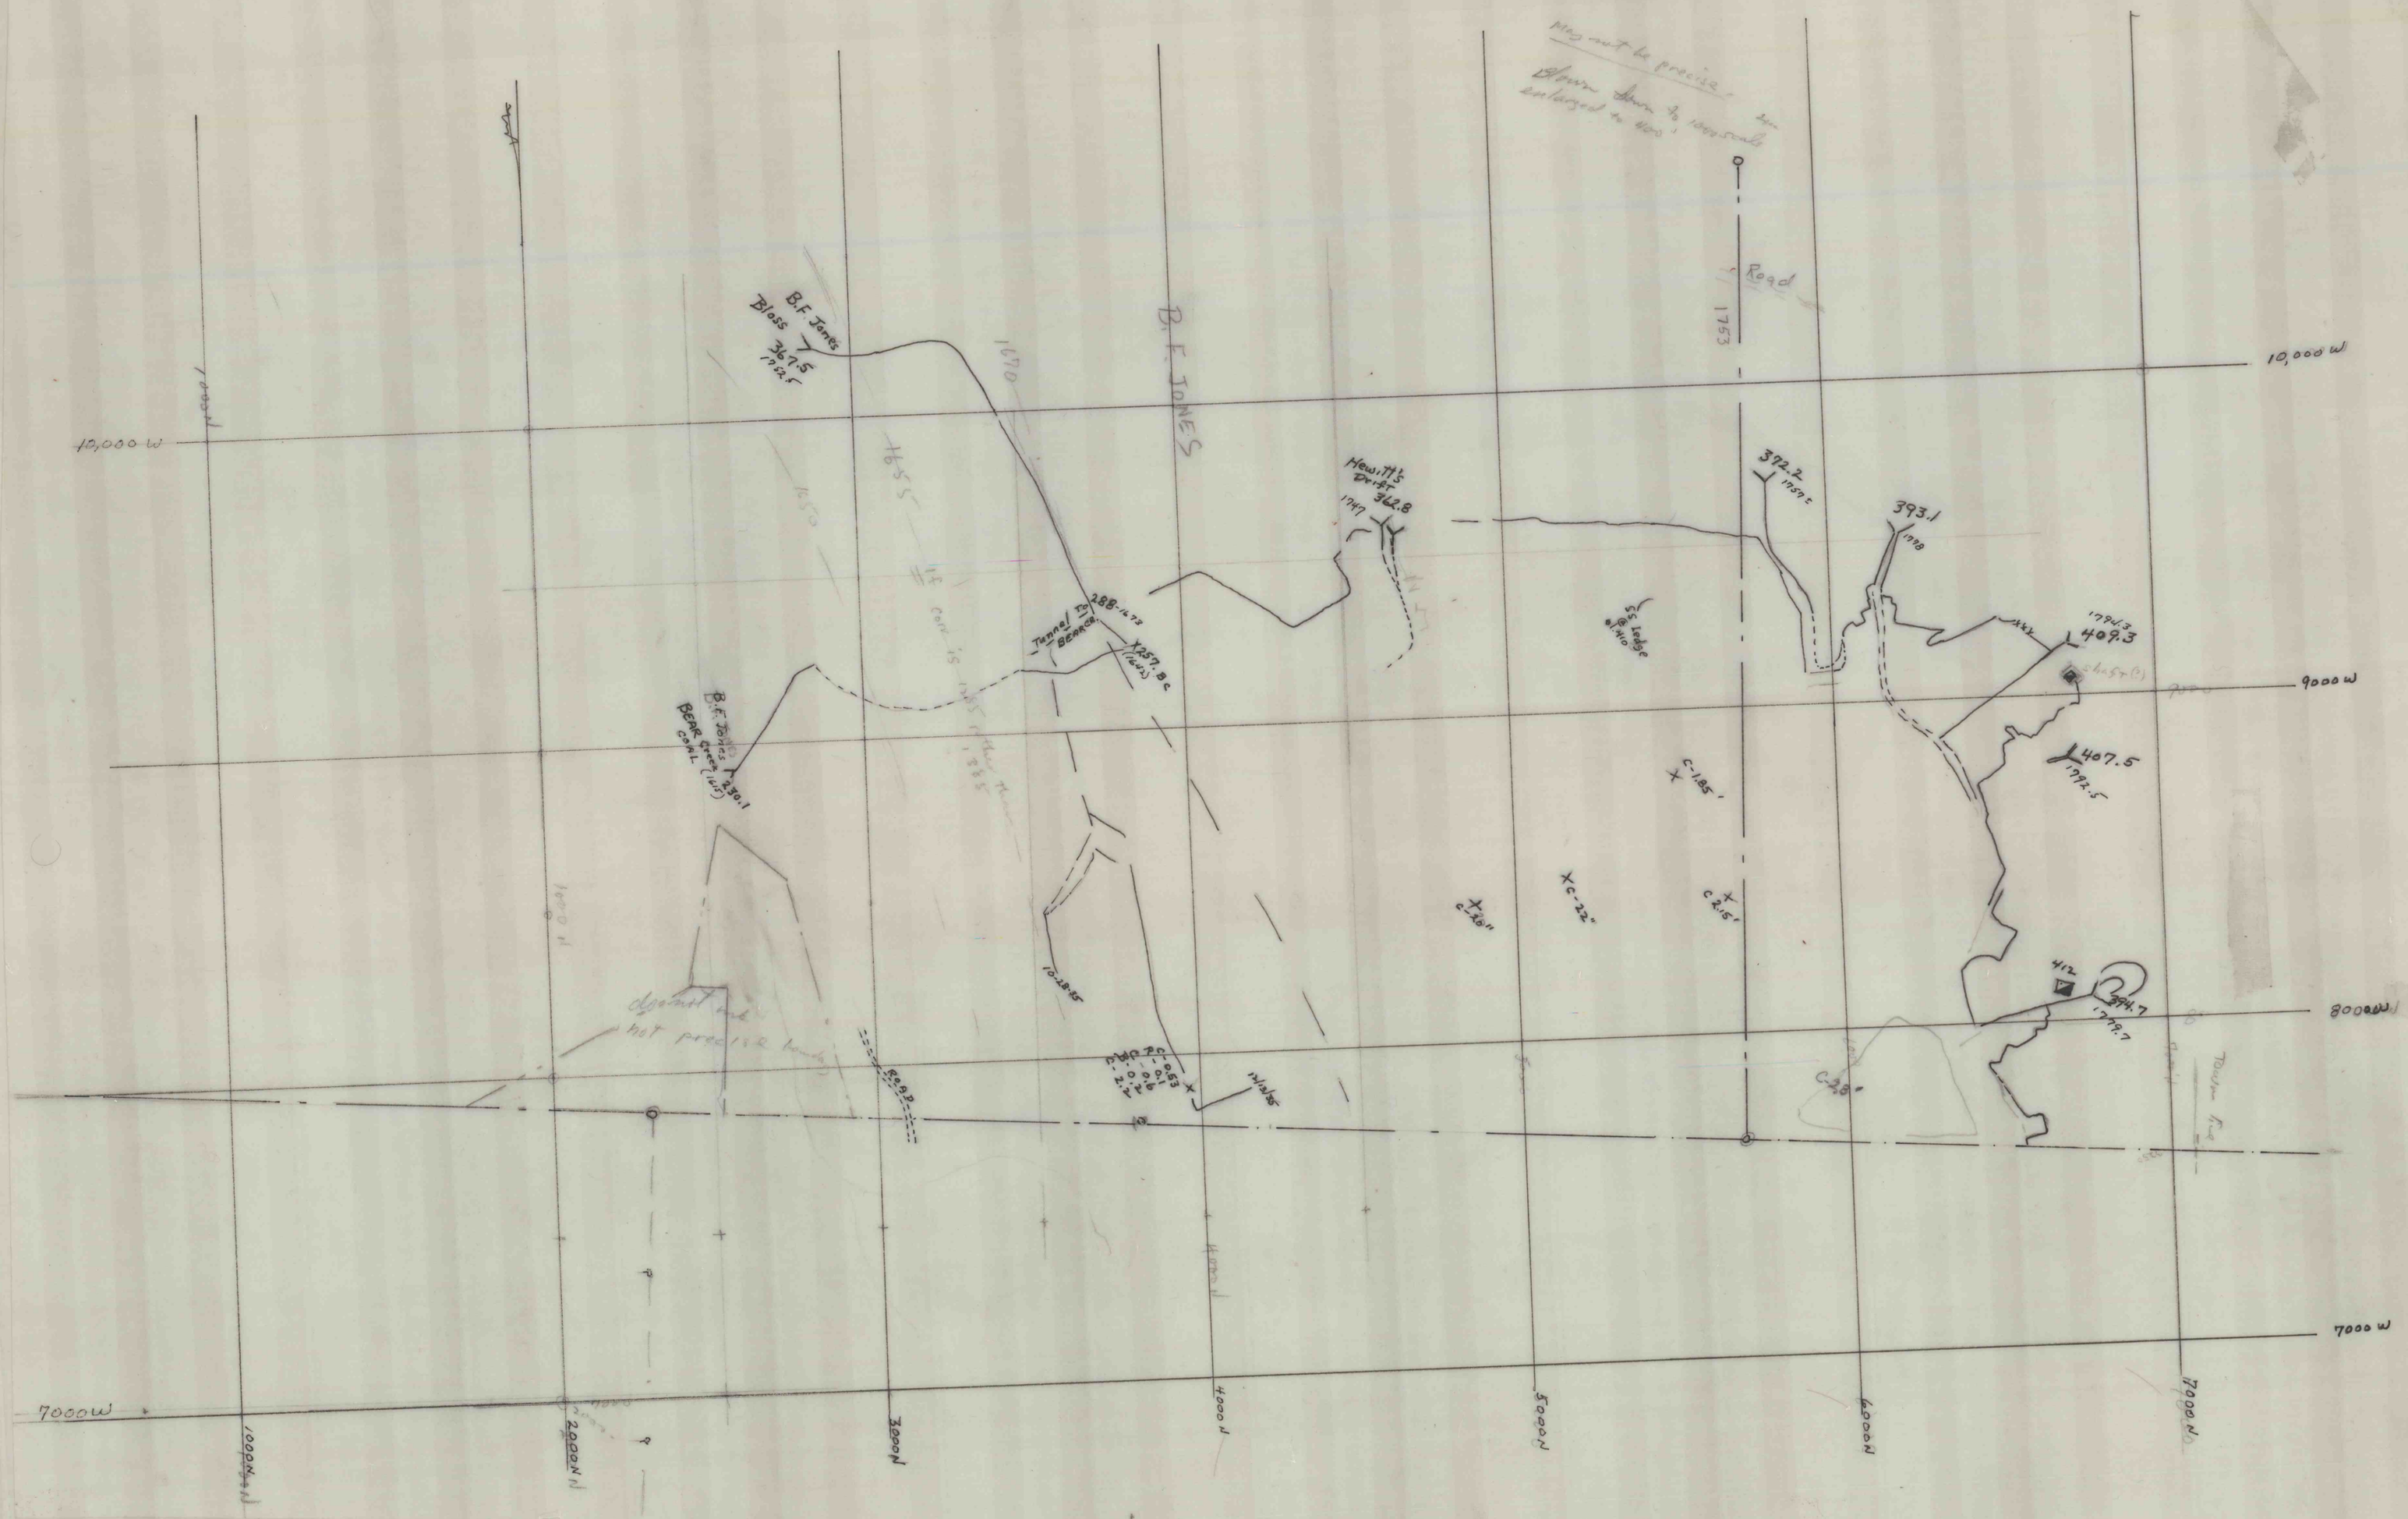
May not be precise - drawn down to 1000 scale enlarged to 1200'
Road
1753
10,000 W
B.F. Jones
Bloss
367.5
1755
1670
B.F. JONES
Hewitt's Drift
362.8
1747
372.2
1757
393.1
1778
Tunnel to Beaver Cr.
288-1673
257.8c
SS Ledge
Shaft
1784/33
409.3
9000 W
B.F. Jones
Bear Creek Coal
330.1
C-1.85'
407.5
1792.5
C-1.20'
C-2.2'
C-2.15'
412
394.7
1779.7
8000 W
10-18-85
C-0.53
C-0.01
C-0.6
C-2.2
13/2.85
C-2.8'
Doubtful but not precise bounds
Road
7000 W
1000N
2000N
3000N
4000N
5000N
6000N
7000N