


Bloss & Bear Creek

Structure thin
consideration
on base of Bloss

Revision Aug - 7-19-1979
Bloss thickness

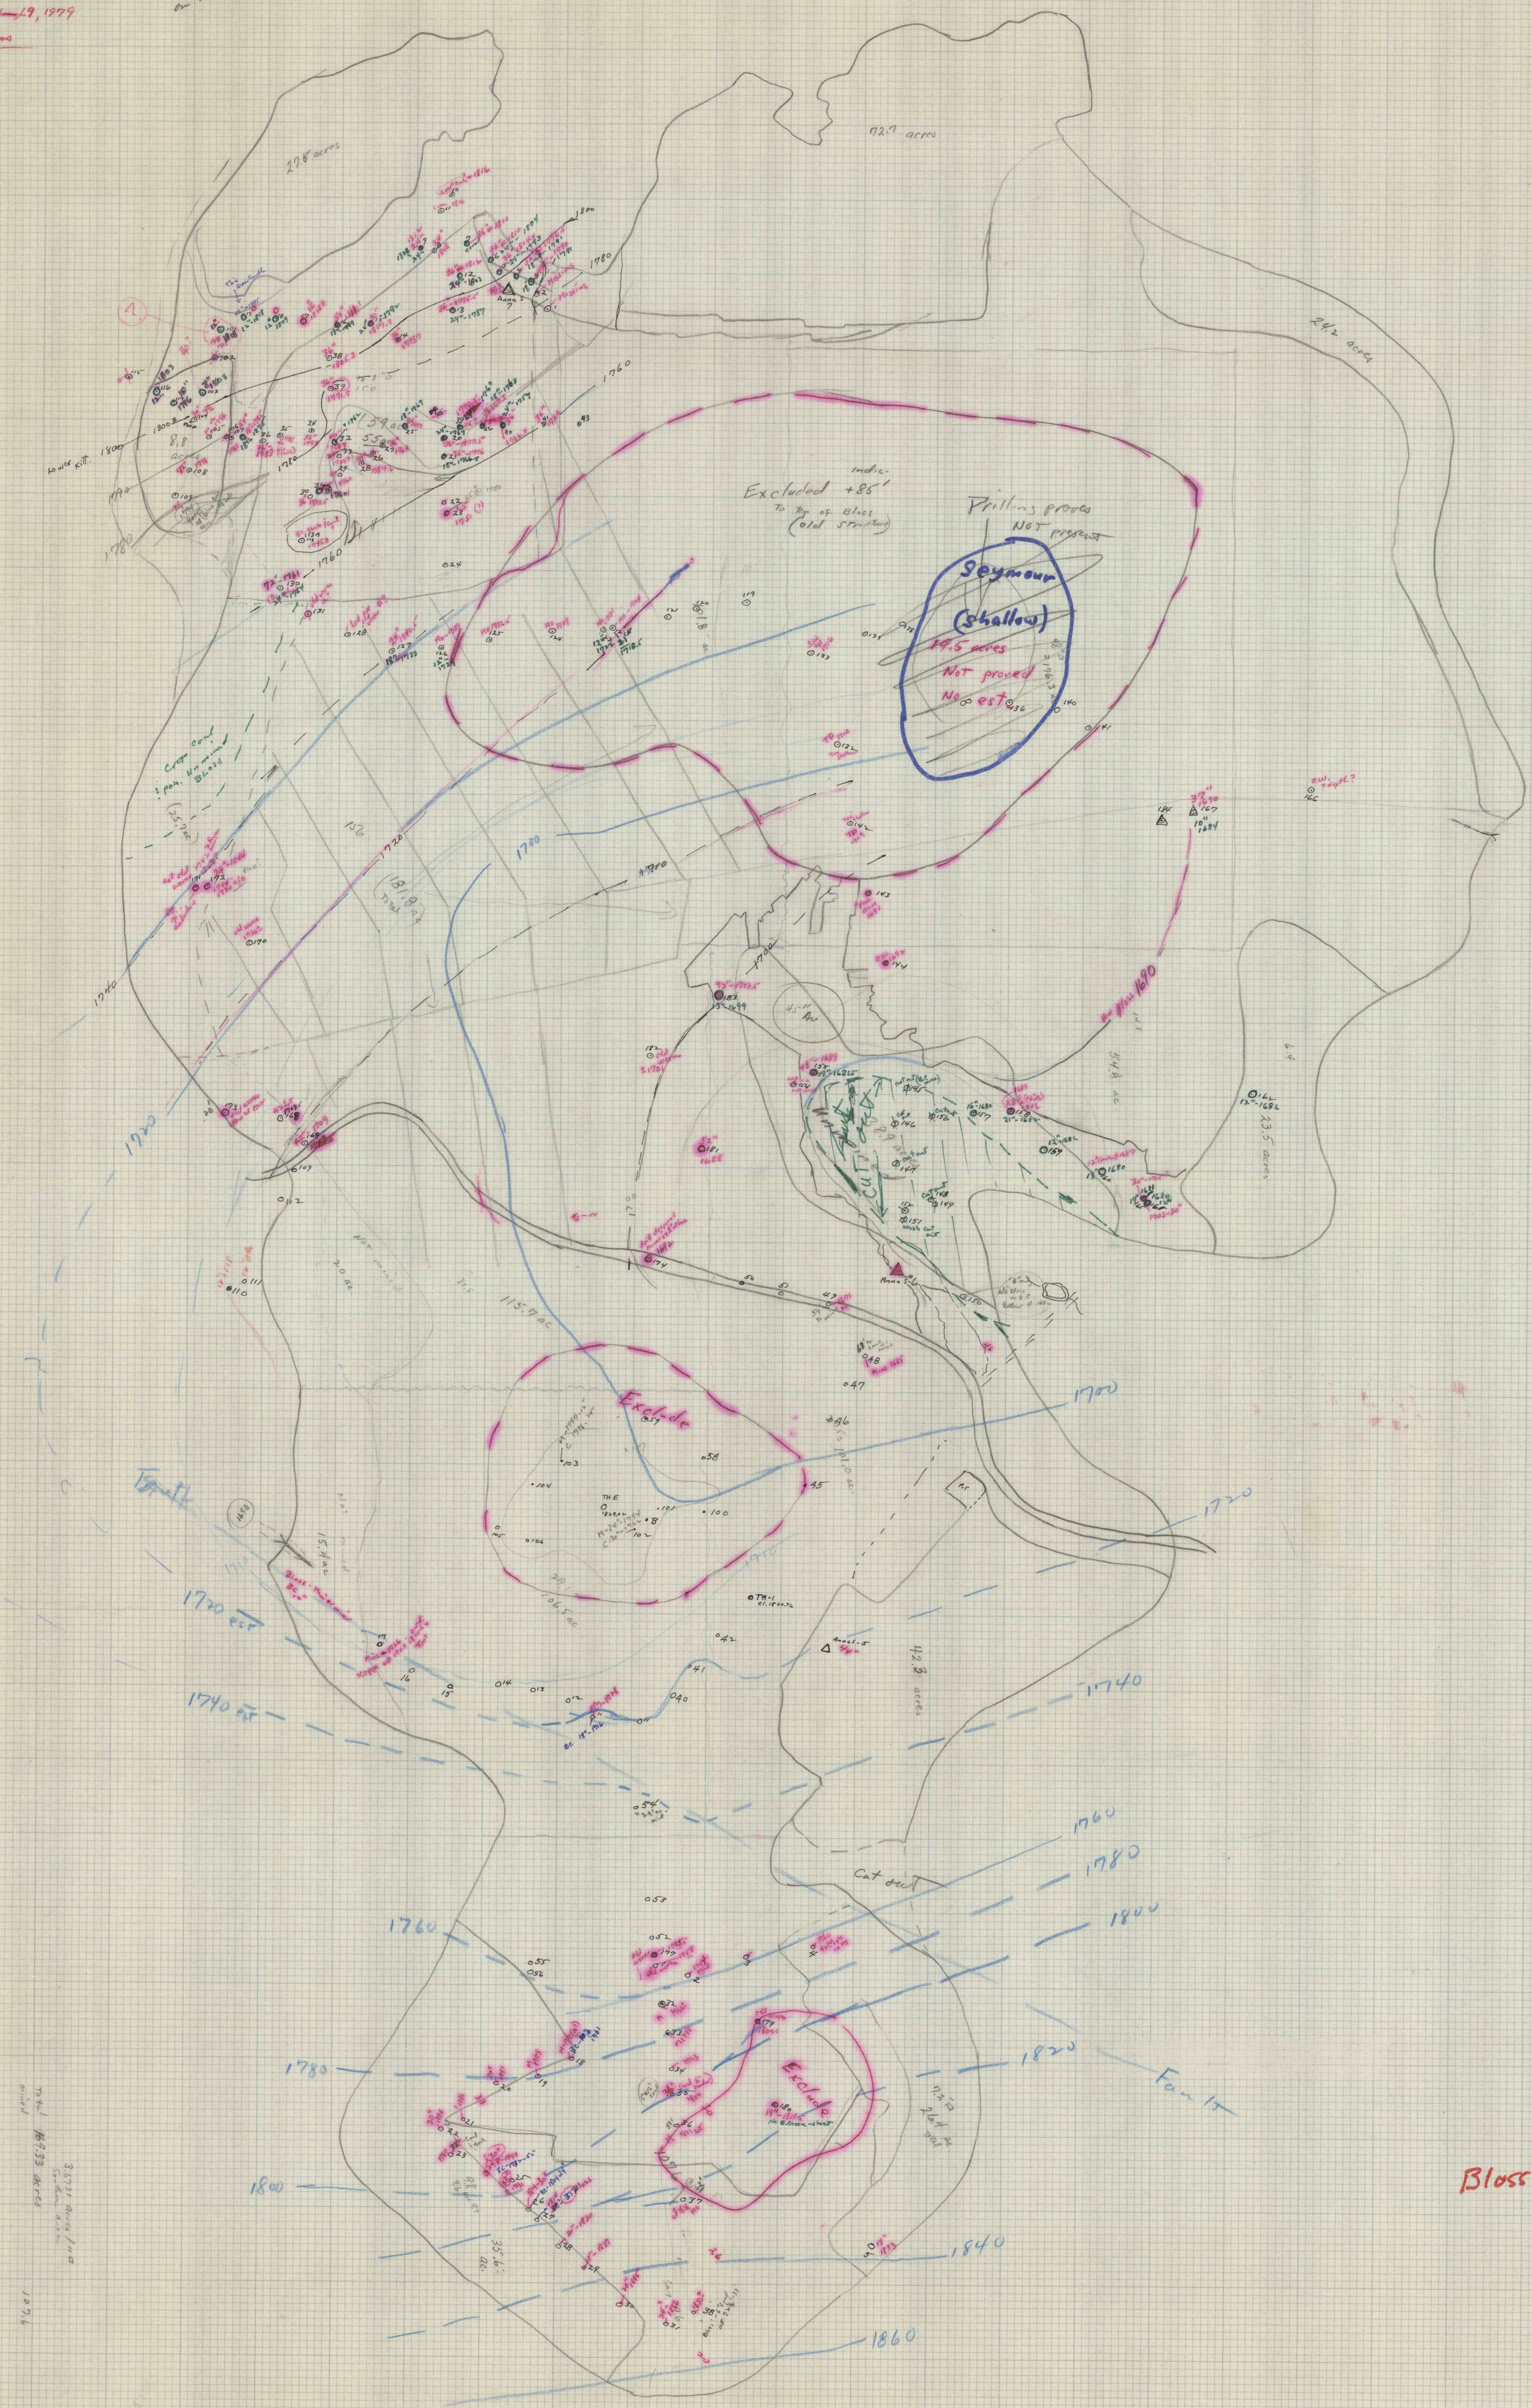

Bloss Structure

1740
