


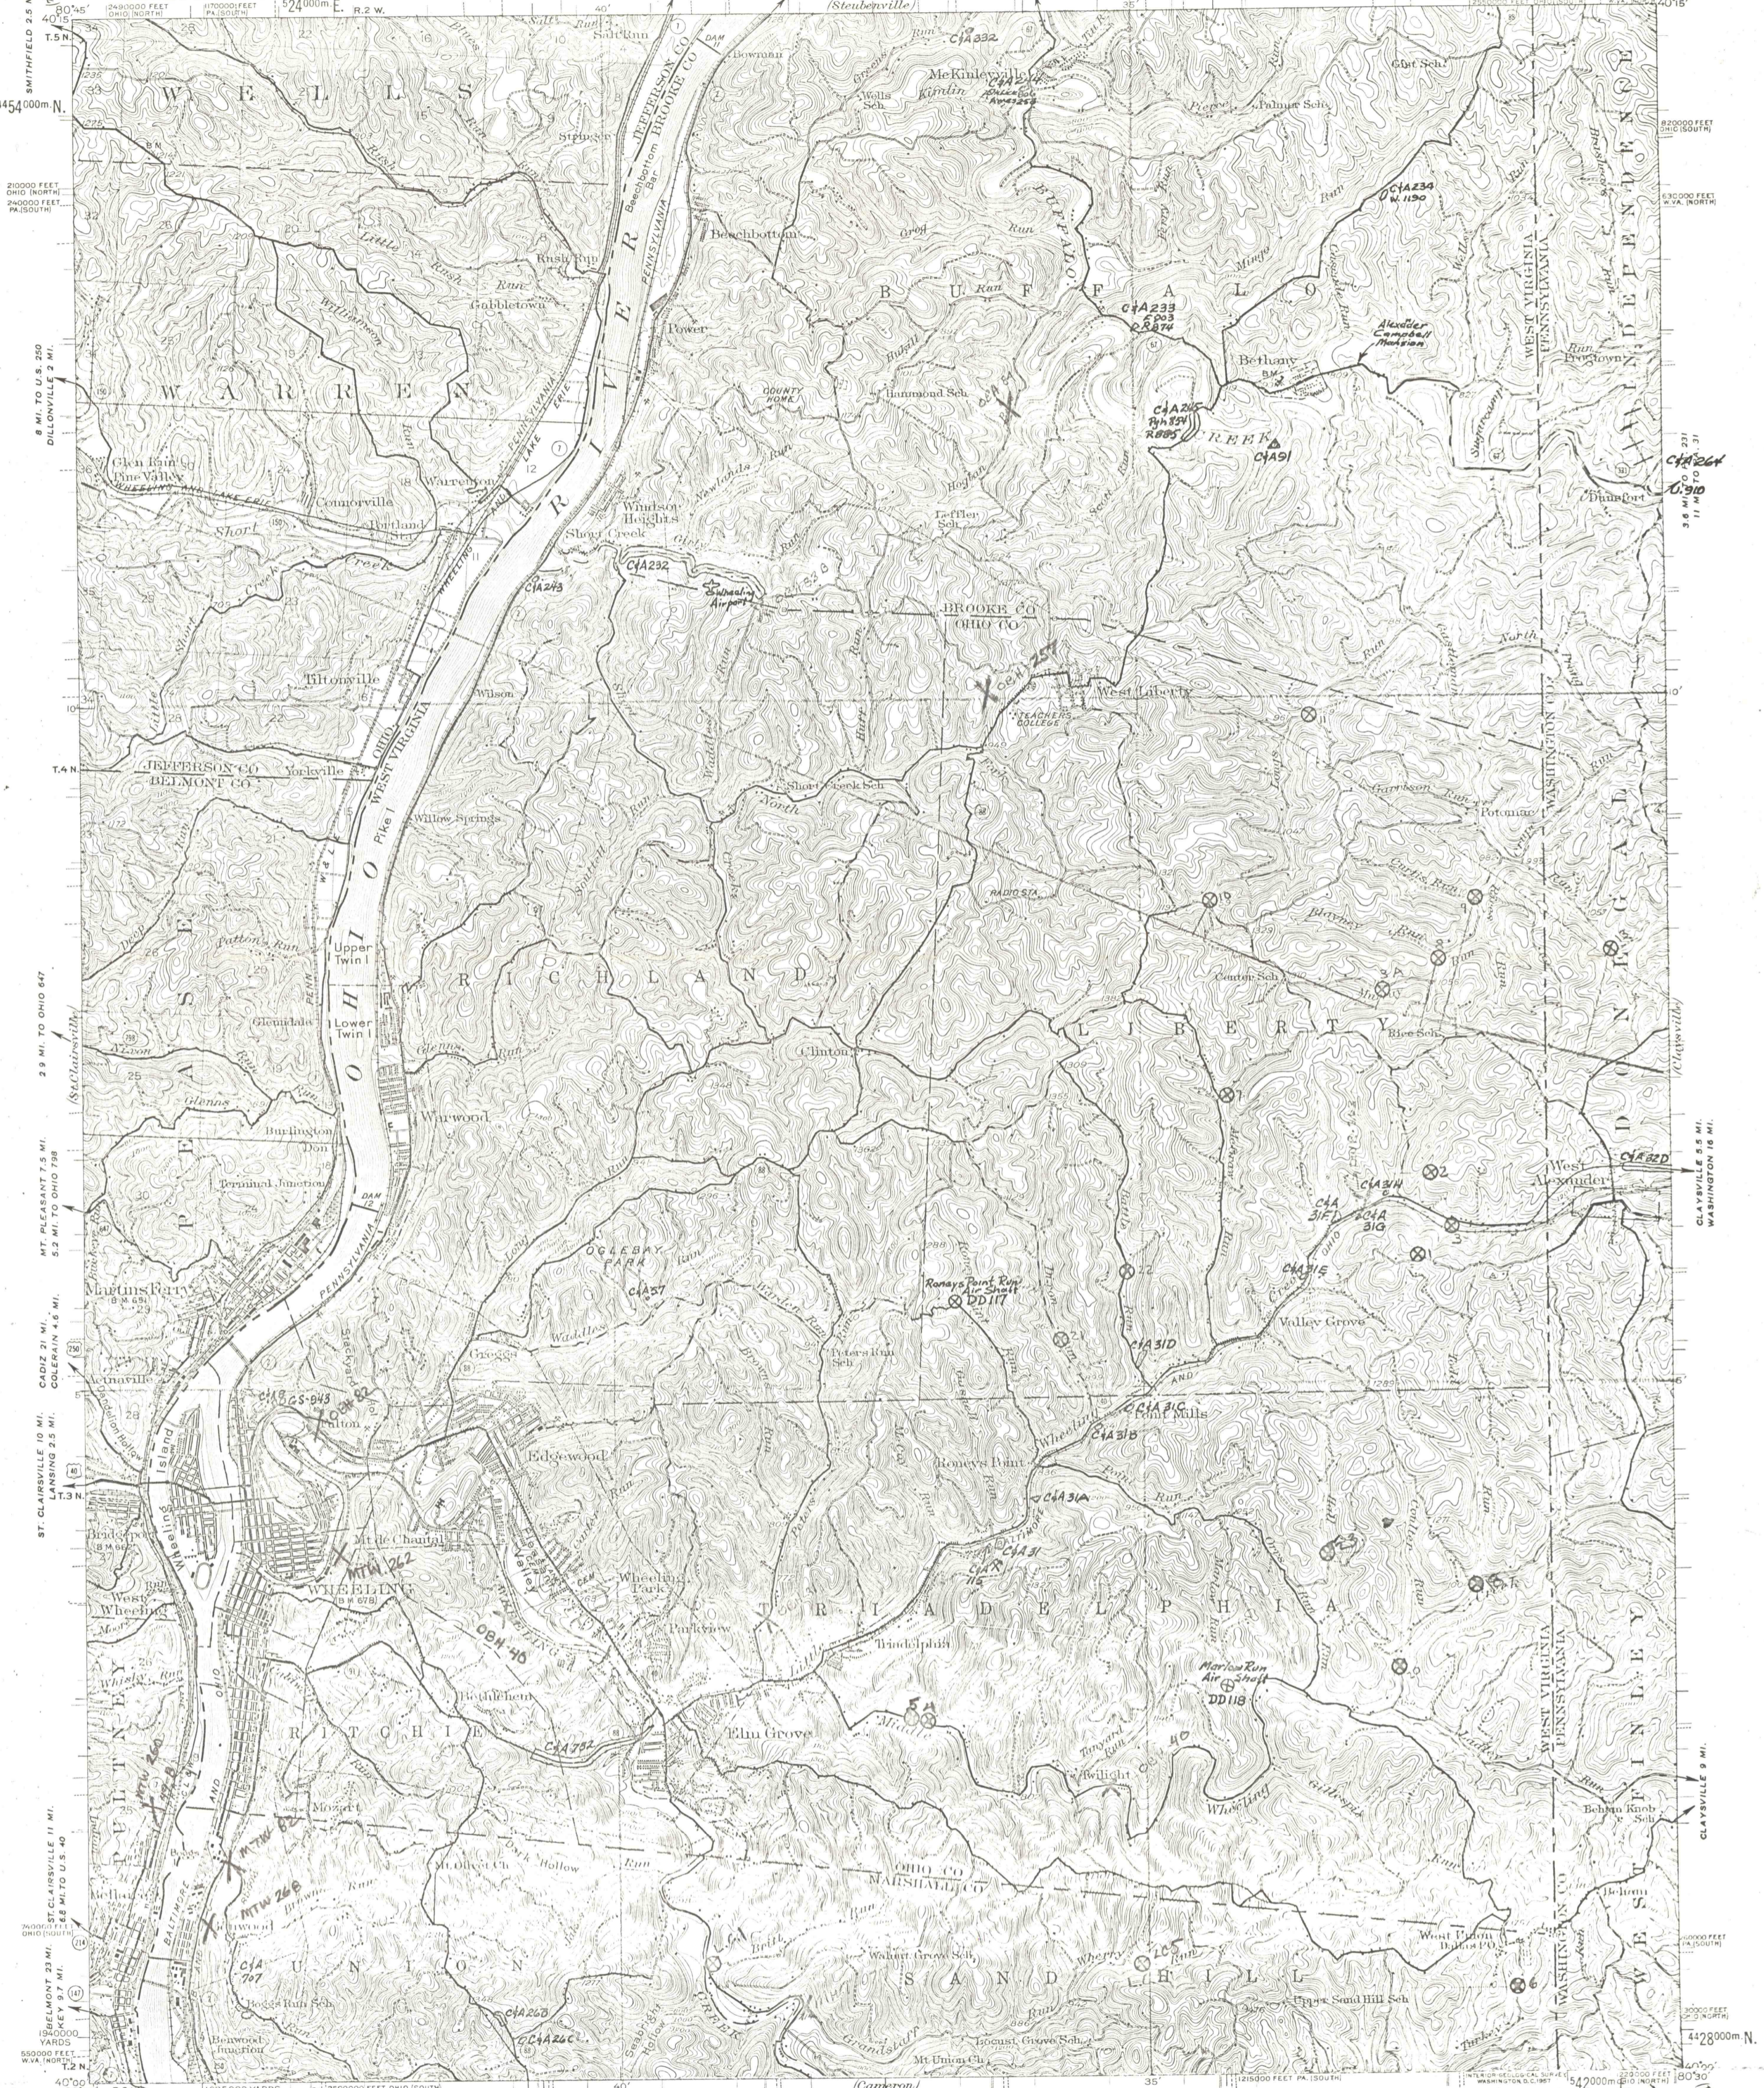

UNITED STATES DEPARTMENT OF THE INTERIOR GEOLOGICAL SURVEY
 STATE OF OHIO REPRESENTED BY THE GOVERNOR TOPOGRAPHIC AND GEOLOGIC SURVEY
 STATE OF WEST VIRGINIA REPRESENTED BY THE GOVERNOR TOPOGRAPHIC AND GEOLOGIC SURVEY
 WEST VIRGINIA-OHIO-PENNSYLVANIA WHEELING QUADRANGLE 15-MINUTE SERIES



Scale: 1:62500
 Contour Interval: 20 Feet
 Datum: Mean Sea Level
 Polyconic projection, North American datum 5000 yard grid based on U.S. zone system, B
 10000 foot grids based on West Virginia (North), Ohio (North), Ohio (South), and Pennsylvania (South) rectangular coordinate systems
 ROAD CLASSIFICATION: Heavy-duty, Light-duty, Medium-duty, Unimproved dirt
 U.S. Route, State Route
 WHEELING, W.VA.-O-PA. N4000-W8030/15
 1935