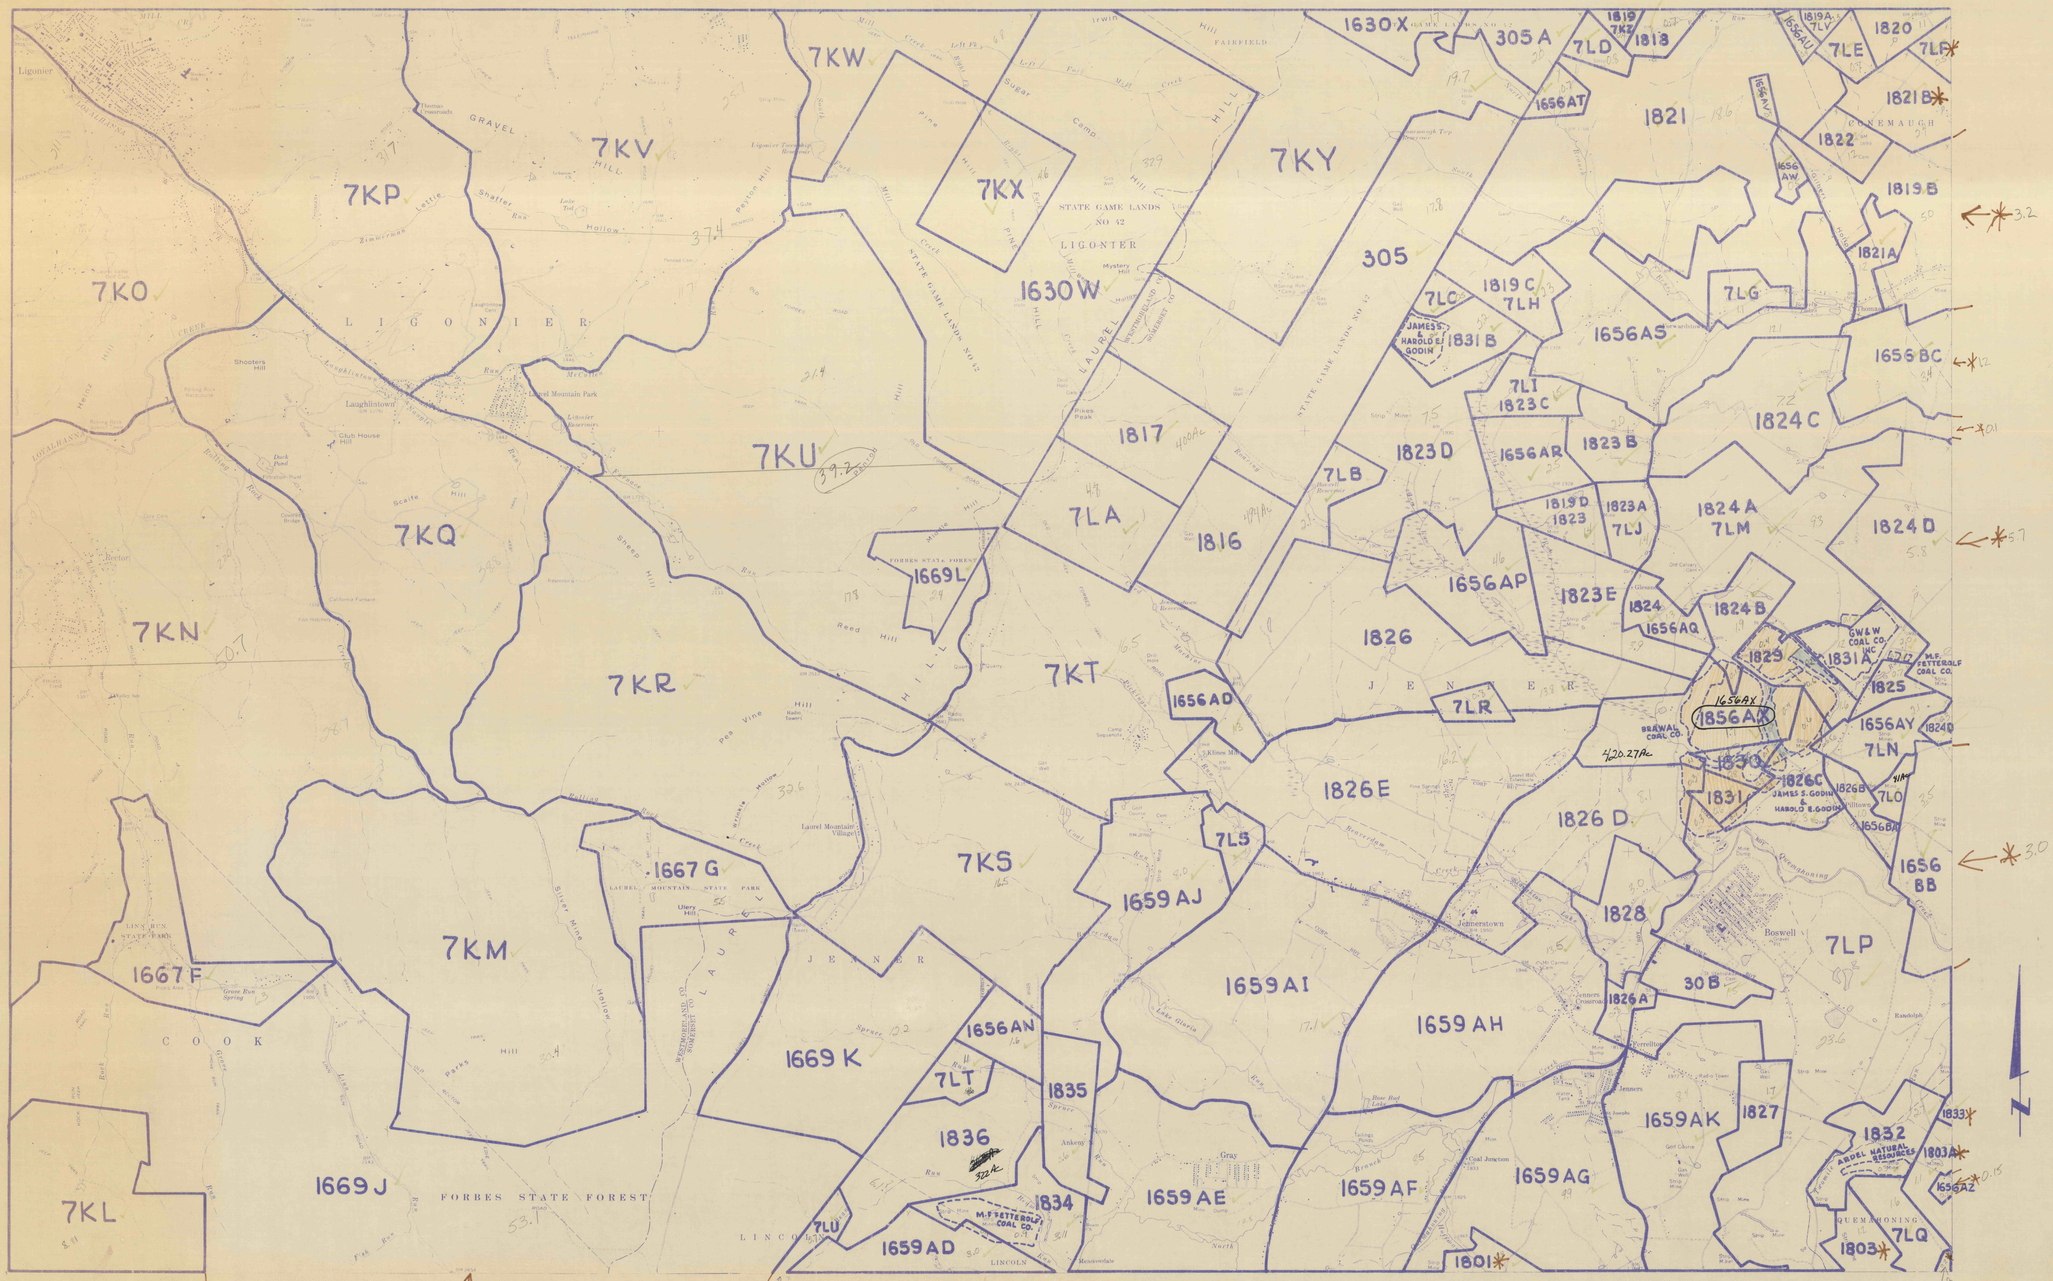

NO.	COAL PROPERTY
30	CONSOLIDATION COAL COMPANY
305	BETHLEHEM STEEL CORPORATION
1630	PENNSYLVANIA STATE GAME LANDS
1656	ELDORA LAND COMPANY
1659	A-G COAL COMPANY
1667	PENNSYLVANIA STATE PARK LANDS
1669	PENNSYLVANIA STATE FOREST LANDS
1801	NORMAN CRITCHFIELD
1803	ARROW REALITY
1816	WADE S. HOKE
1817	GEORGE M. THOMPSON
1818	GEORGE H. HAMMER
1819	ROBERT LOHR
1820	WILLIAM J. WATKINS
1821	KINNERLY COAL & COKE
1822	ALLEGHENY MOUNTAIN LAKES INC.
1823	WASHINGTON COAL CO.
1824	HILLMAN COAL CO.
1825	C.M. & C.F. SHAULIS
1826	BOSWELL LAND CO.
1827	ELLIS & FLO FREIDLINE
1828	ATLANTIC COAL CO.
1829	HOWARD & FREDA ROSE
1830	JAMES S. GODIN
1831	M.F. LAND CO.
1832	JOHN BEEKNER
1833	JOHN S. CARR
1834	MYRON F. & INEZ FETTEROLF
1835	LLOYD K. ST. CLAIR
1836	CHARLES & GRACE KESLAR JR.
7	INDIVIDUALS

COAL LANDS IN PENNSYLVANIA

SOMERSET REGION

MAP NO. 57

TRIBUTARY TO

THE BALTIMORE & OHIO RAILROAD

Prepared By

GWIN, DOBSON & FOREMAN, INC.

Consulting Engineers

Altoona, Pennsylvania

SCALE 4000 3000 2000 1000 0 2000 4000

DATE: MAY 1976