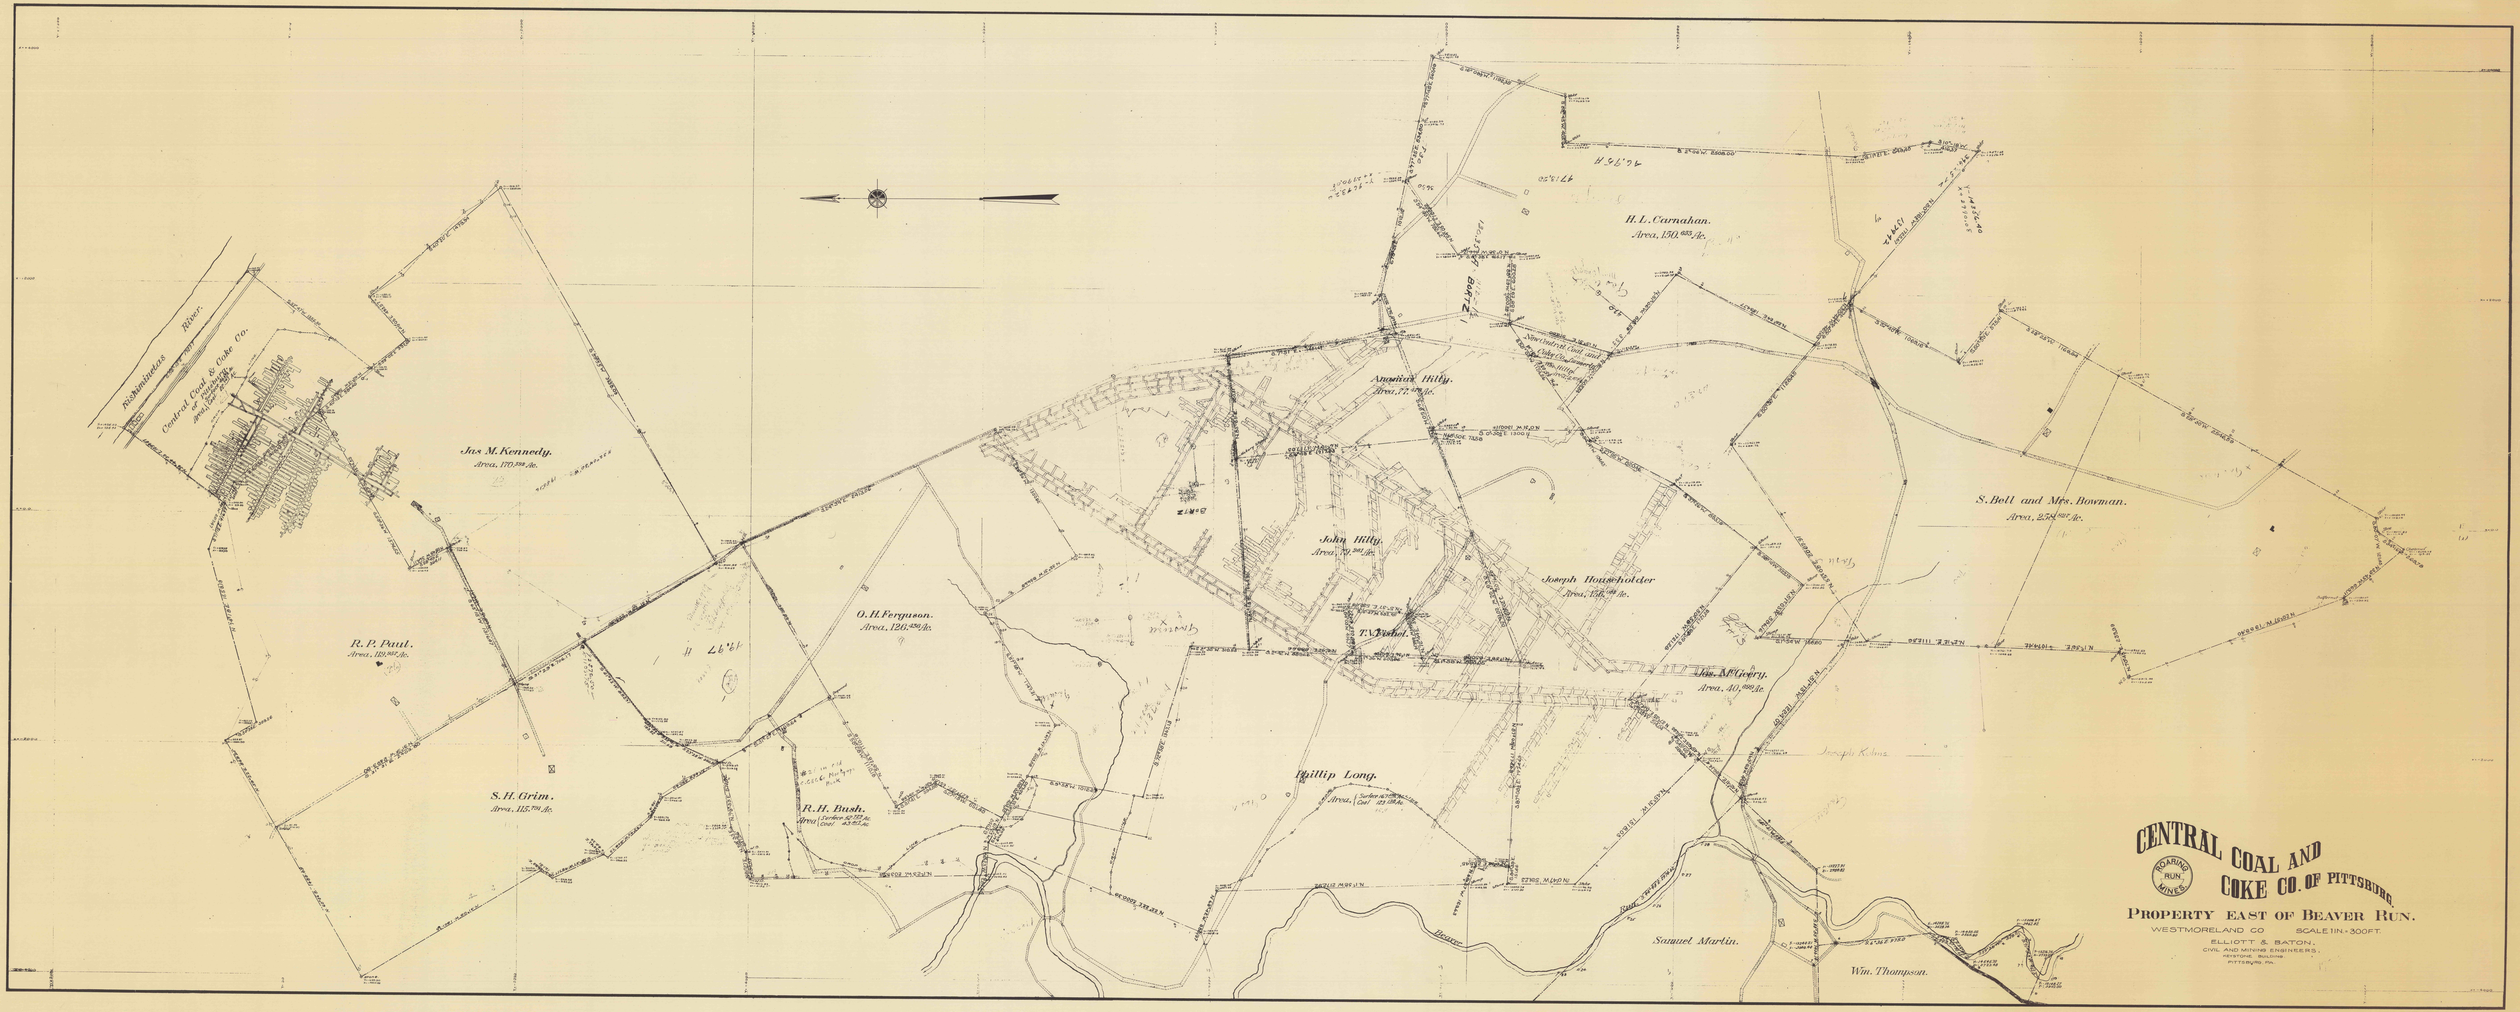

CENTRAL COAL AND COKE CO. OF PITTSBURG.
ROARING RUN MINES.
PROPERTY EAST OF BEAVER RUN.
WESTMORELAND CO SCALE 1 IN. = 300 FT.
ELLIOTT & BATON.
CIVIL AND MINING ENGINEERS.
KEYSTONE BUILDING
PITTSBURG, PA.
Rishiminetas River.
Central Coal & Coke Co.
Jas M. Kennedy.
Area, 170.[illegible] Ac.
R. P. Paul.
Area, 119.[illegible] Ac.
S. H. Grim.
Area, 115.[illegible] Ac.
O. H. Ferguson.
Area, 126.[illegible] Ac.
R. H. Bush.
Area { Surface 42.[illegible] Ac. Coal 43.[illegible] Ac.
Phillip Long.
Ananias Hilty.
Area, 77.[illegible] Ac.
John Hilty.
Area, 79.[illegible] Ac.
T. V. Fischel.
Joseph Householder
Jas. McGeery.
Area, 40.[illegible] Ac.
H. L. Carnahan.
Area, 150.[illegible] Ac.
S. Bell and Mrs. Bowman.
Area, 258.[illegible] Ac.
Samuel Martin.
Wm. Thompson.
Beaver Run