


5.63 ACRES

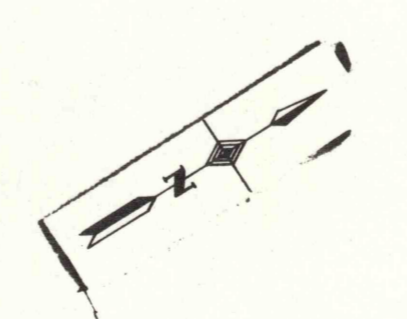

PDVMS 031271 4 36X348435

1-31-77	11-29
12-31-76	10-3
11-30-76	8-31
8-31-76	7-31
7-31-76	6-30-76
6-30-76	5-31-76
5-31-76	4-30-76
4-30-76	3-31-76
3-31-76	2-29-76
2-29-76	