

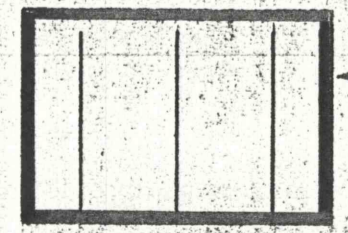
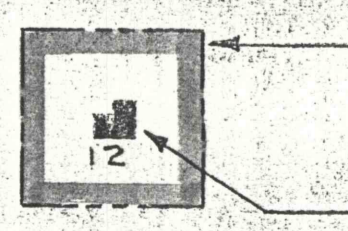
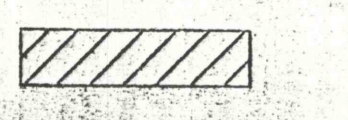



H

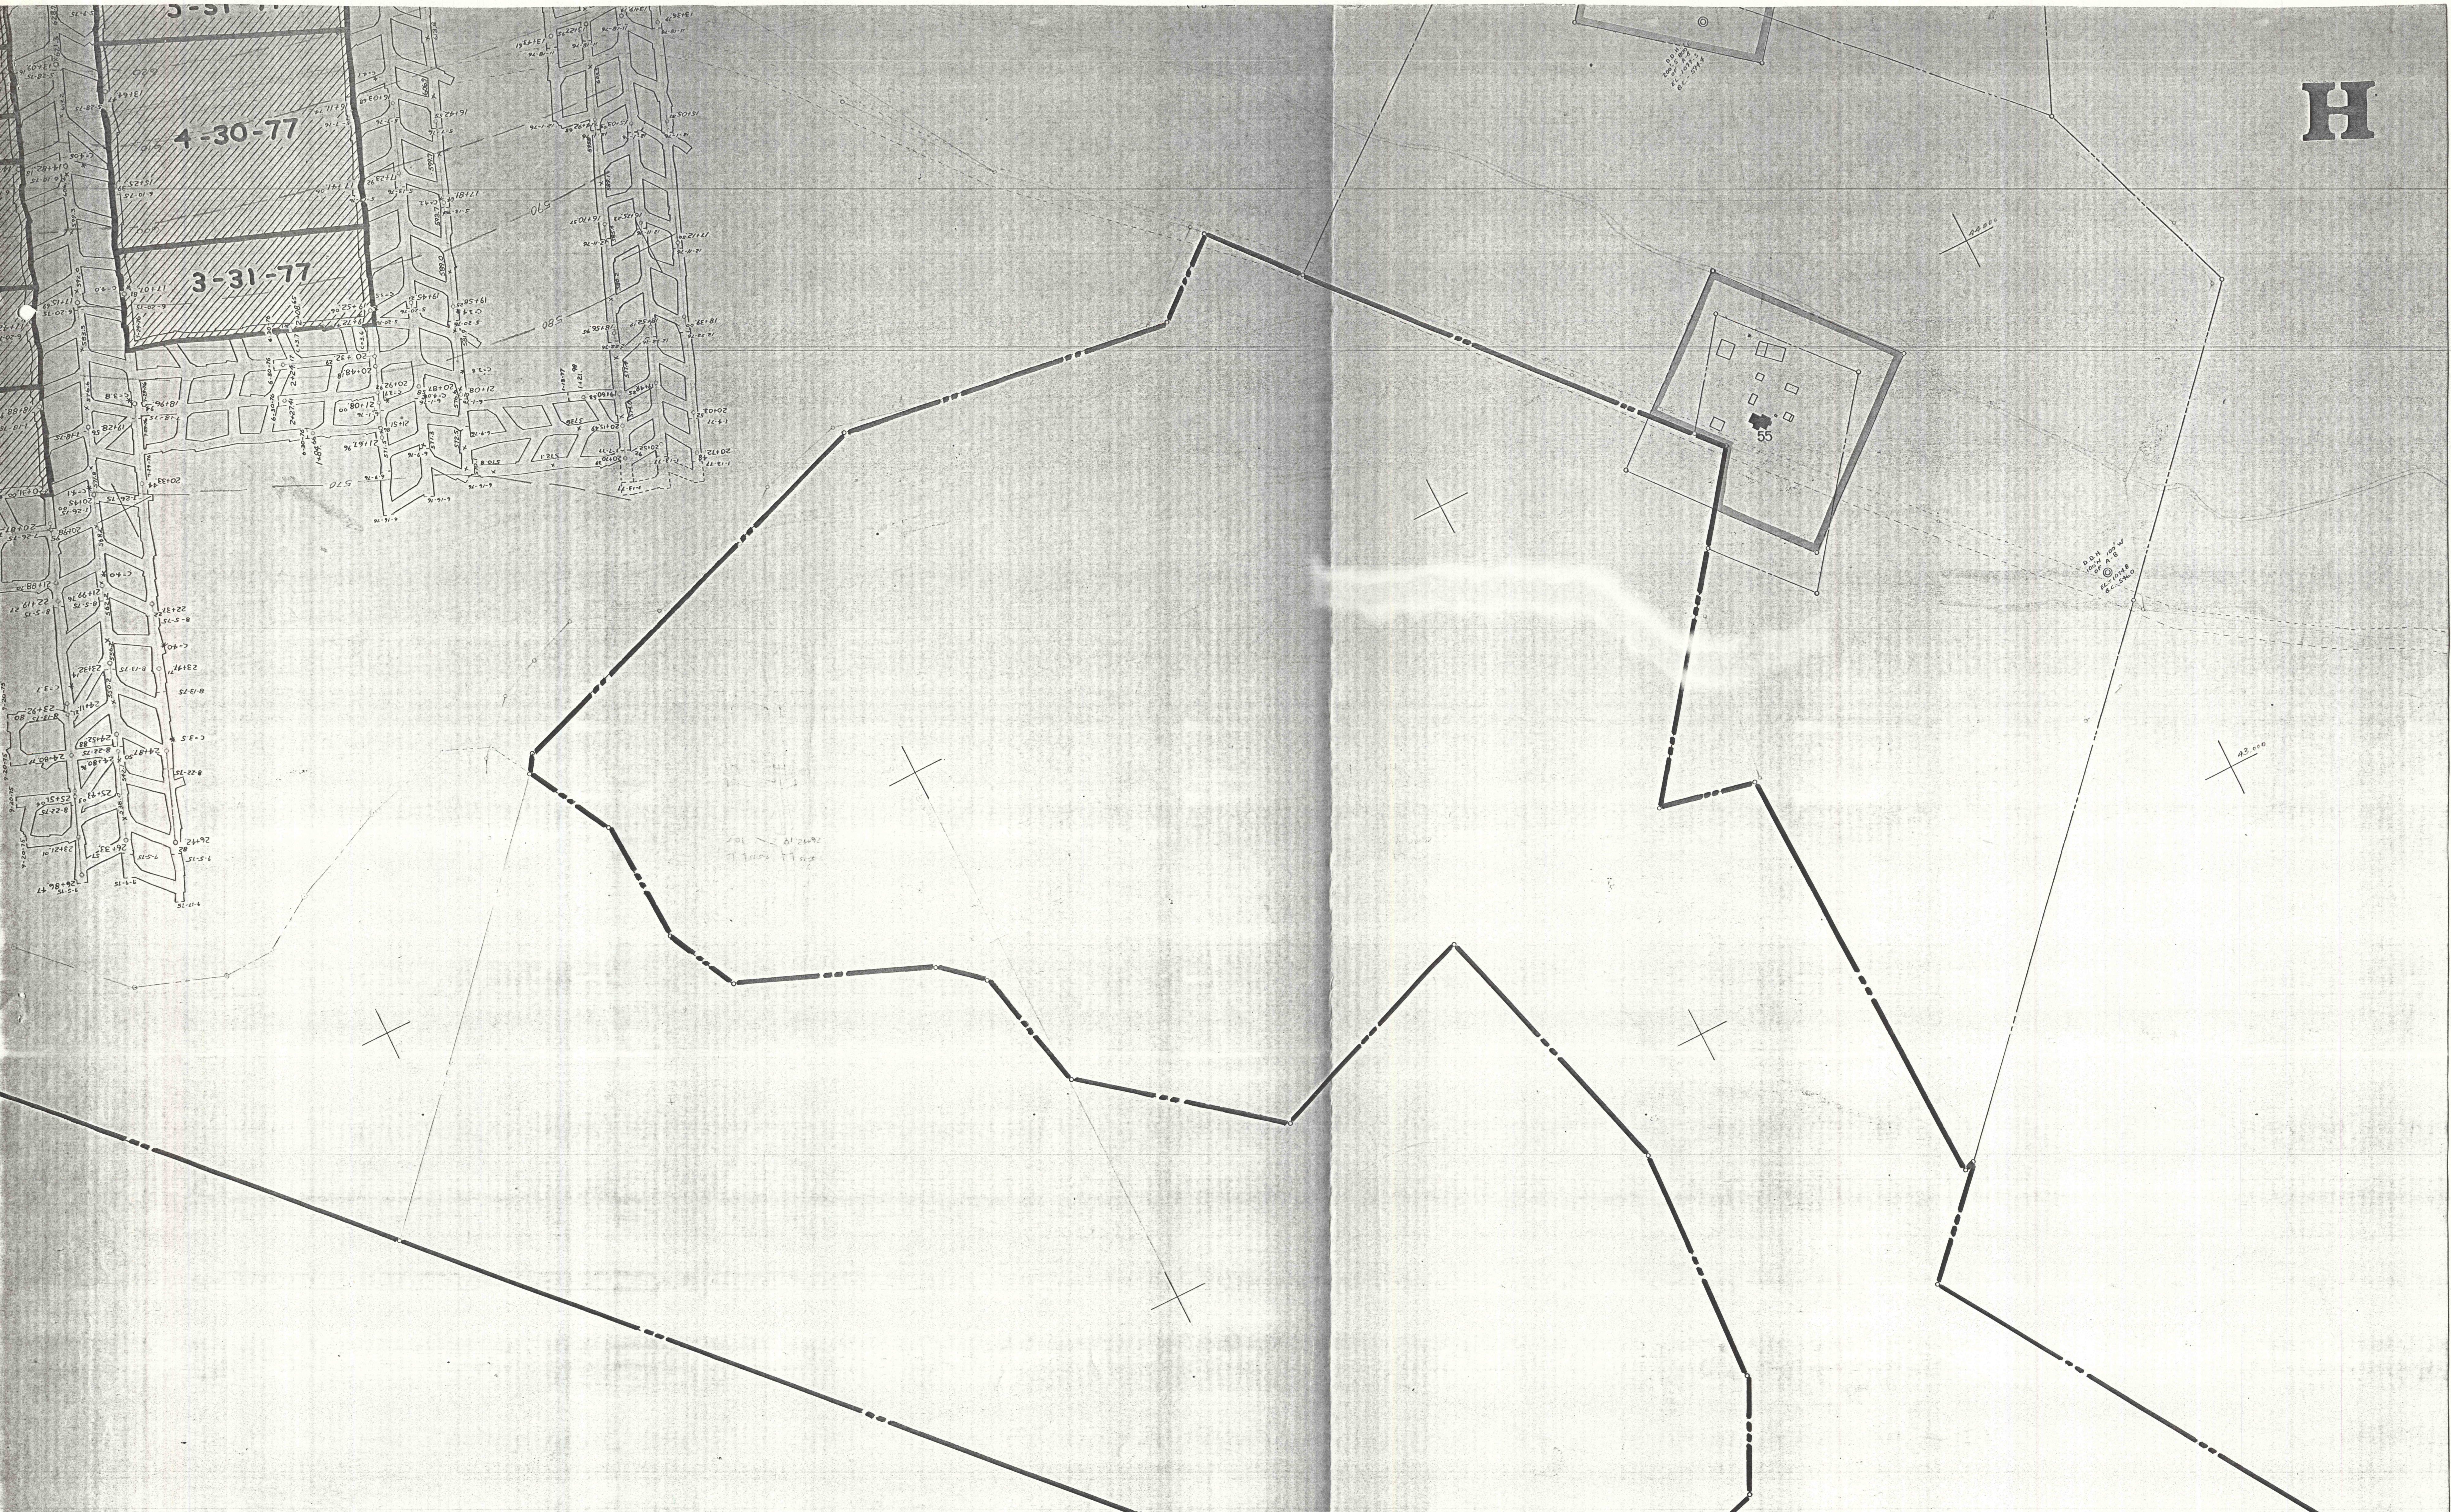


<b>LEGEND</b>	
	Coal Boundary Line
	Proposed Mining (red)
	Required support area (yellow) 50% of coal to be left in blocks.
	Protected Structure and No.
	Mining Completed

SIX MONTH MINE SUBSIDENCE MAP  
EASTERN ASSOCIATED COAL CORP.  
BELMONT MINE


East Huntingdon Twp., Westmoreland Co., Pa.  
South Huntingdon Twp., Westmoreland Co., Pa.

Scale 1" = 100'      Survey Date 2-31-77

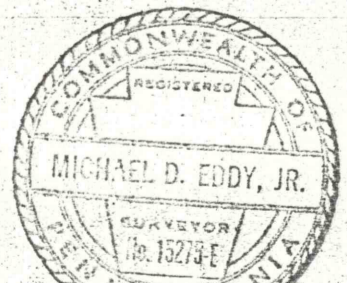

**MICHAEL D. EDDY, JR.**  
R.P.E. SU-015275 E

mt Pleasant

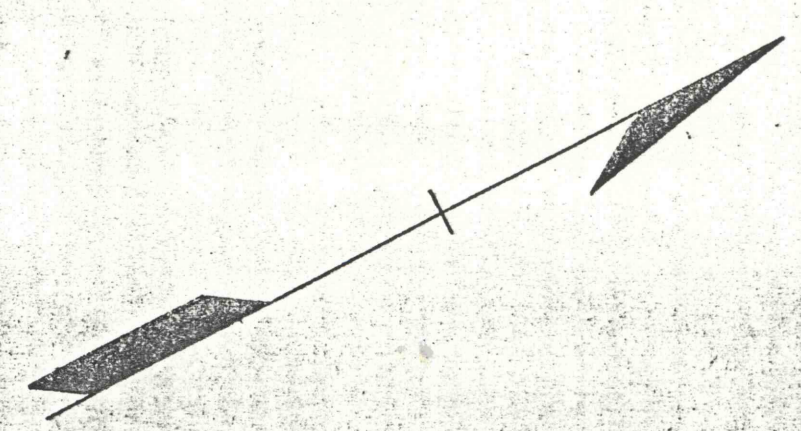

**RECEIVED**  
OF MINE  
SUBSIDENCE REGULATION  
JAN 27 1978  
MURRAY  
PENNSYLVANIA

FINAL MAP

H