


INDIANA COUNTY STRUCTURE
(ESP CORL 50)

BLAINSVILLE BOLIVAR
DERBY WILPEN

BOLIVAR NEW FLORENCE
WILPEN RACHELWOOD

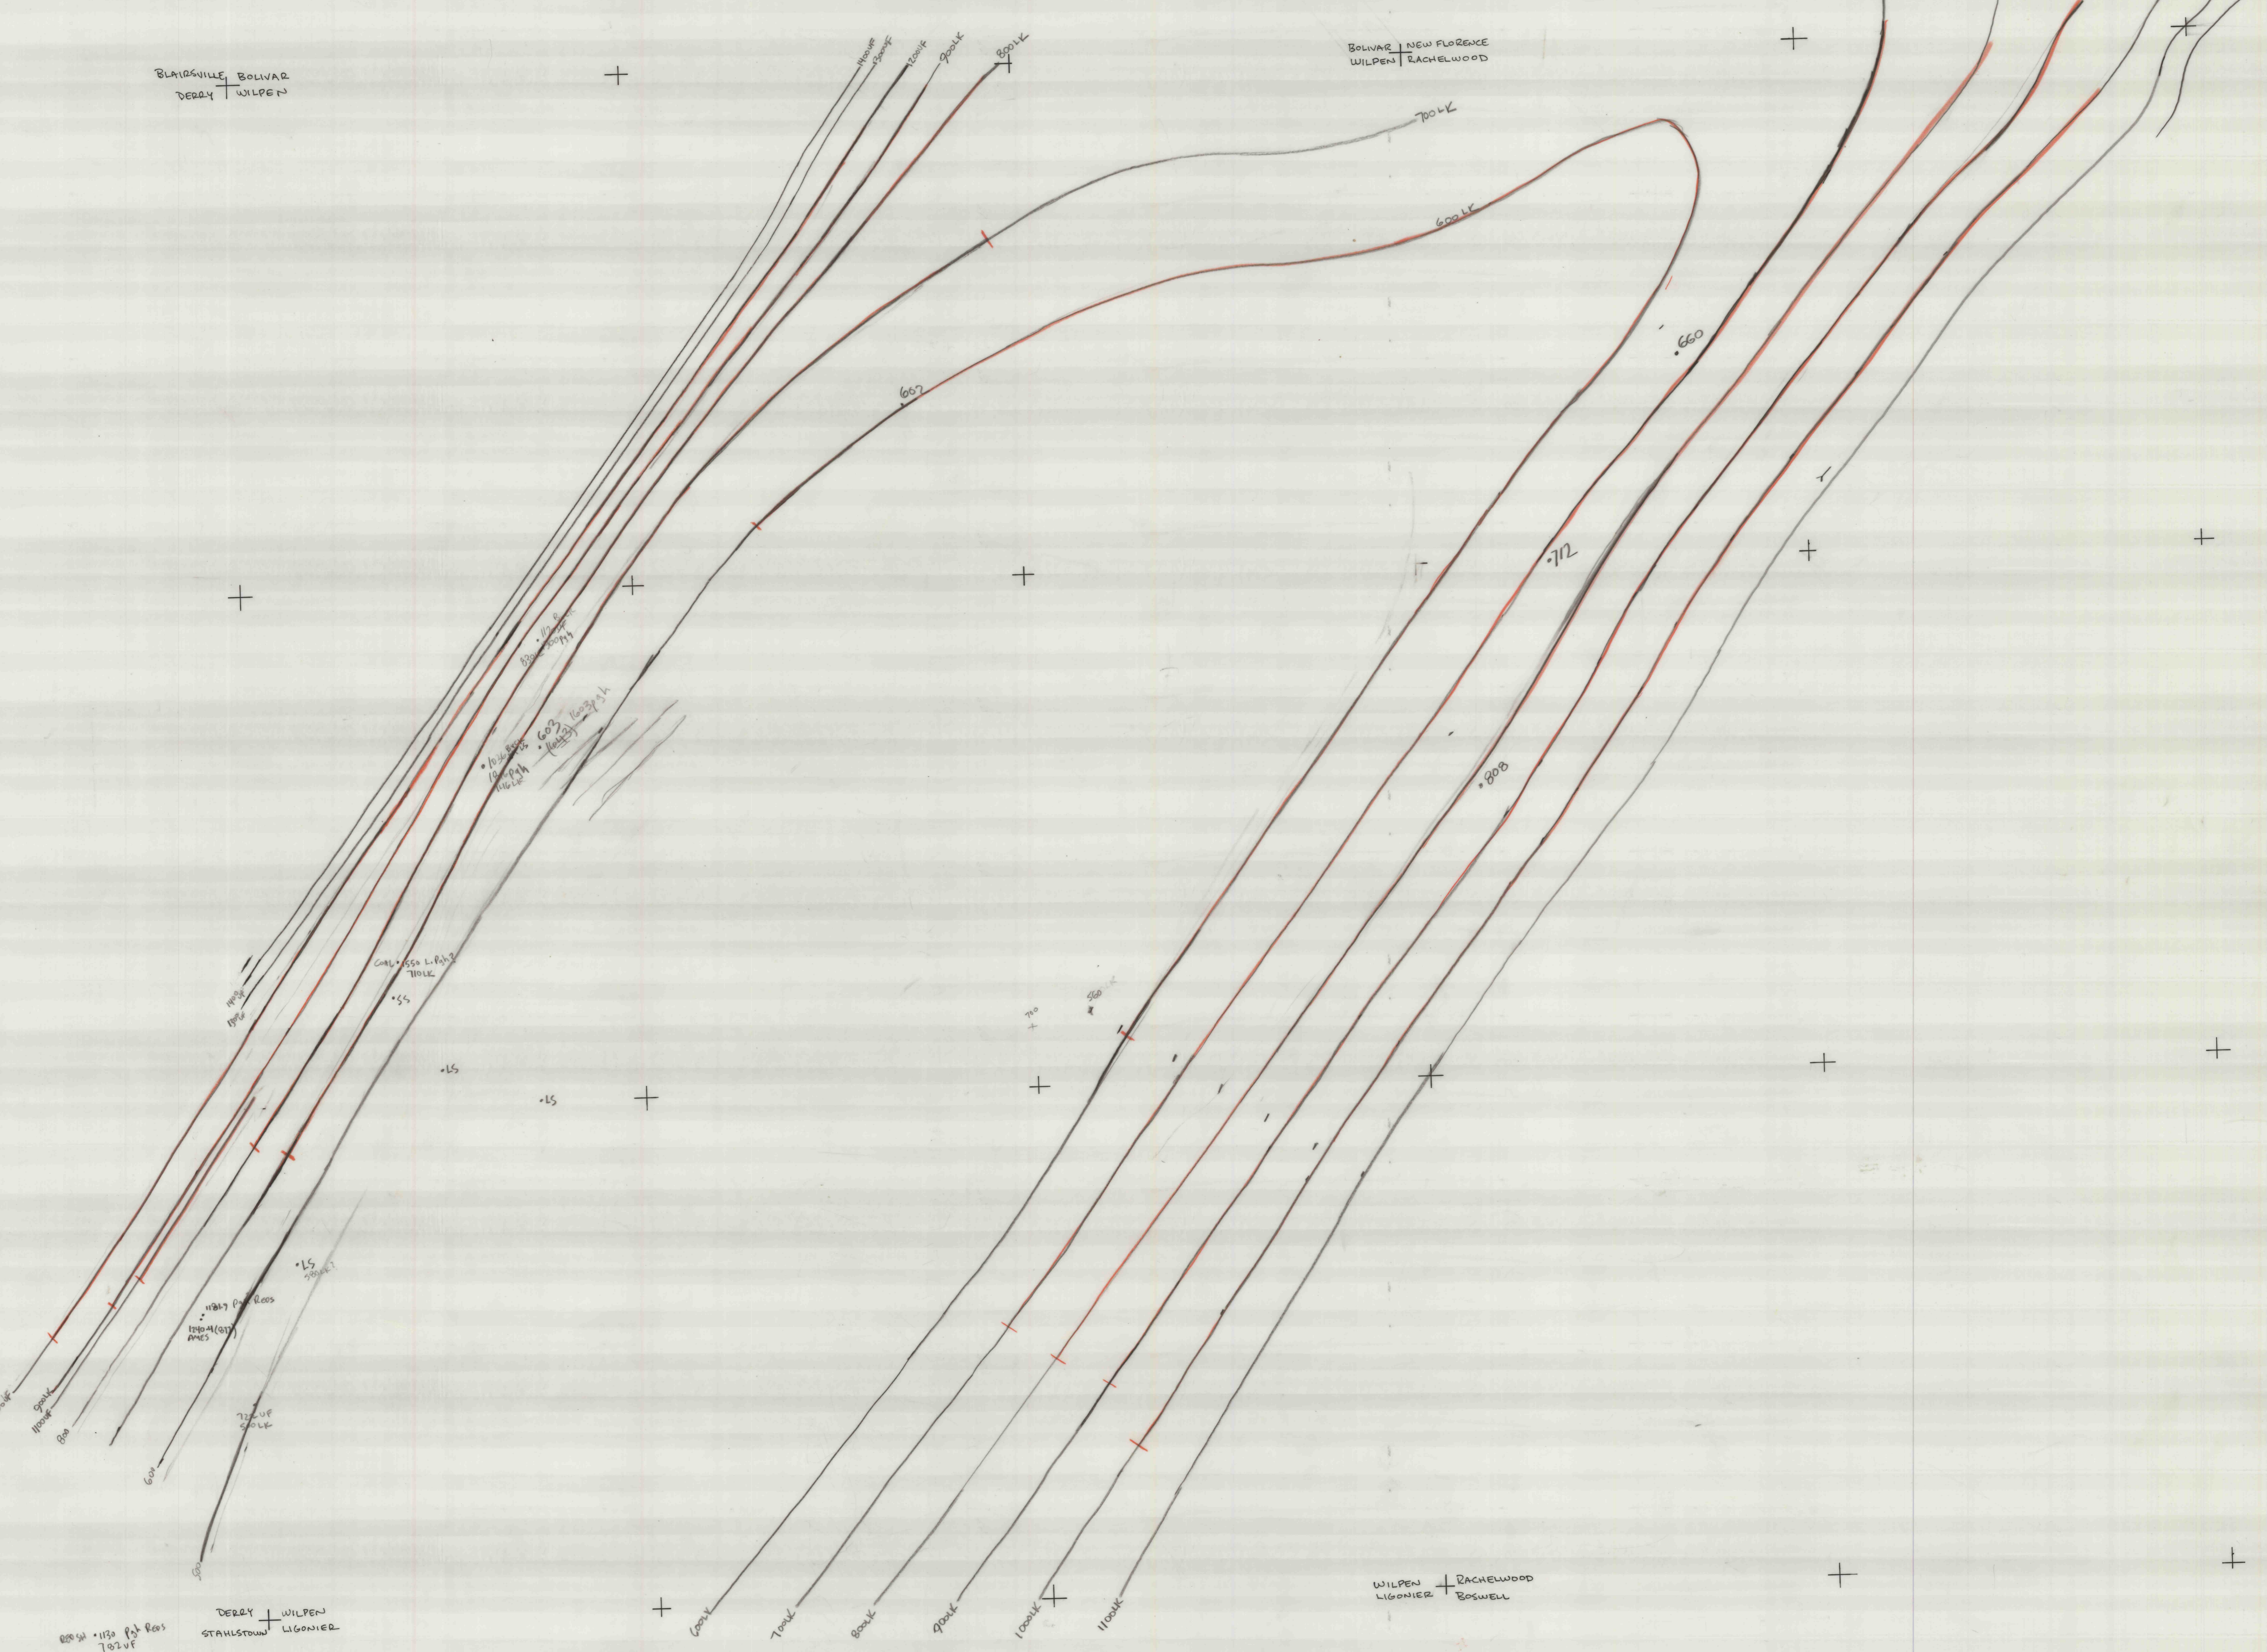

DERBY WILPEN
STAHLSTOWN LIGONIER

WILPEN RACHELWOOD
LIGONIER BOSWELL

7/7/88
REVISED STRUCTURE (BASED
ON RECENTLY ACQUIRED UTAH INT.
DATA) IN RED OVER PENCIL