

A

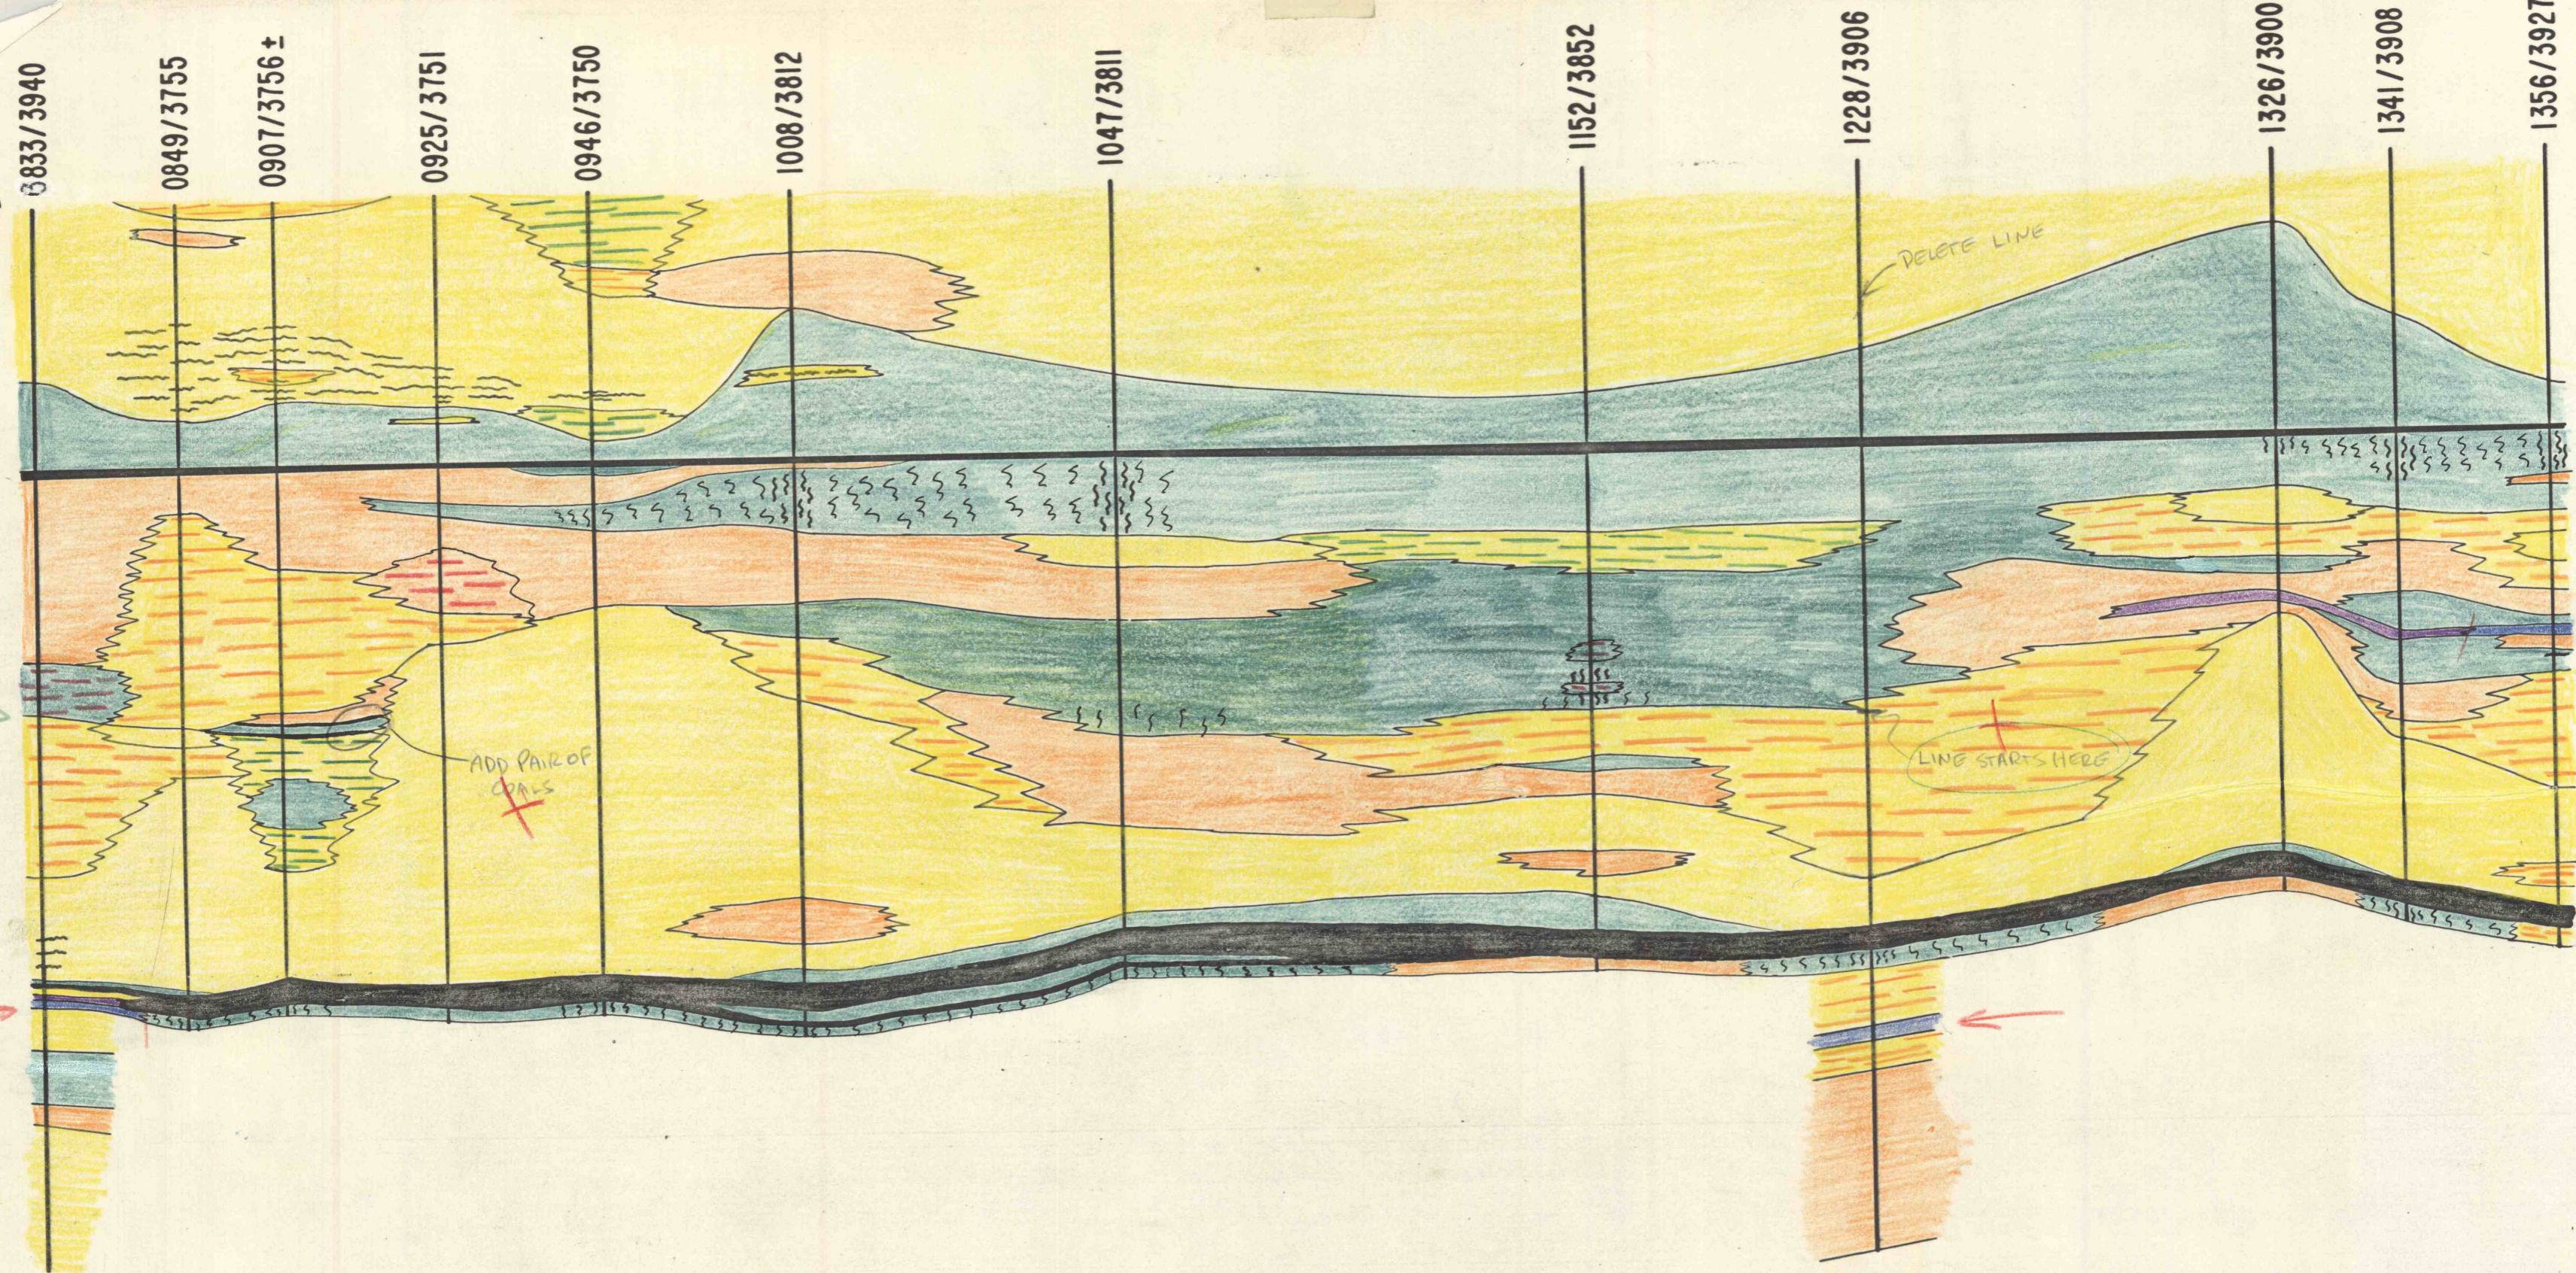


Fig. 11A