

PRELIMINARY	
C. 3226	F. 3
FINAL	
C.	F.
T.C.	T.F.

Sta. 62+17 to Sta. 65+83 Lt  
Storm Sewer  
24" Ext. Str. Pl. C.C. Pipe, or Ext. Str. V.C. Pipe, or  
20" C.M. Pipe

PRELIMINARY	
C. 1975	F. 2
FINAL	
C.	F.
T.C.	T.F.


Sta. 62+15 Lt  
Begin 16' Bench

Sta. 62+00  
30" C.I. R.C.C. Pipe

Sta. 61+62 to Sta. 61+84  
Storm Sewer Outlet  
30" Ext. Str. Pl. C.C. Pipe, or  
Ext. Str. V.C. Pipe, or  
C.M. Pipe

PRELIMINARY	
C. 756	F. 82
FINAL	
C.	F.
T.C.	T.F.

61+50  
460

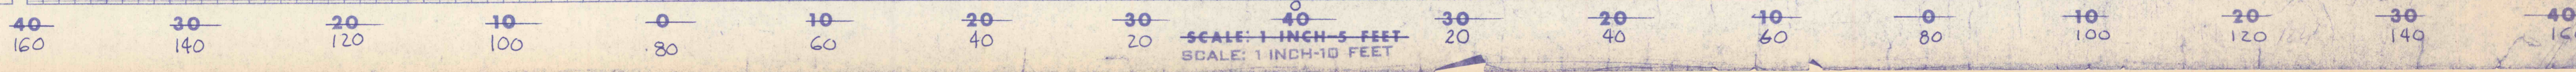

Application No. 6447  
Route No. 1070  
Original Planned by LDK  
Checked by JEM  
Template by MLE  
Finals Plotted by  
Checked by  
Area by  
Checked by