


SHEET NO. 8 SECTION H.
SCALES: HORIZONTAL: 1"=20'
VERTICAL: 1"=20'
INDEX NO. 18-3-30-50
DRAWN: M.W.D. CHECKED: J.C.M. DATE: 9-12-55

BY:	DATE:
EL. 10+00	
FINAL SURVEY	SURVEYED
NOTE BOOK	TEMPLATED
NO.	AREAS CHECKED

BY:	DATE:
EL. 8+00	
ORIGINAL SURVEY	SURVEYED
NOTE BOOK	TEMPLATED
NO.	AREAS CHECKED

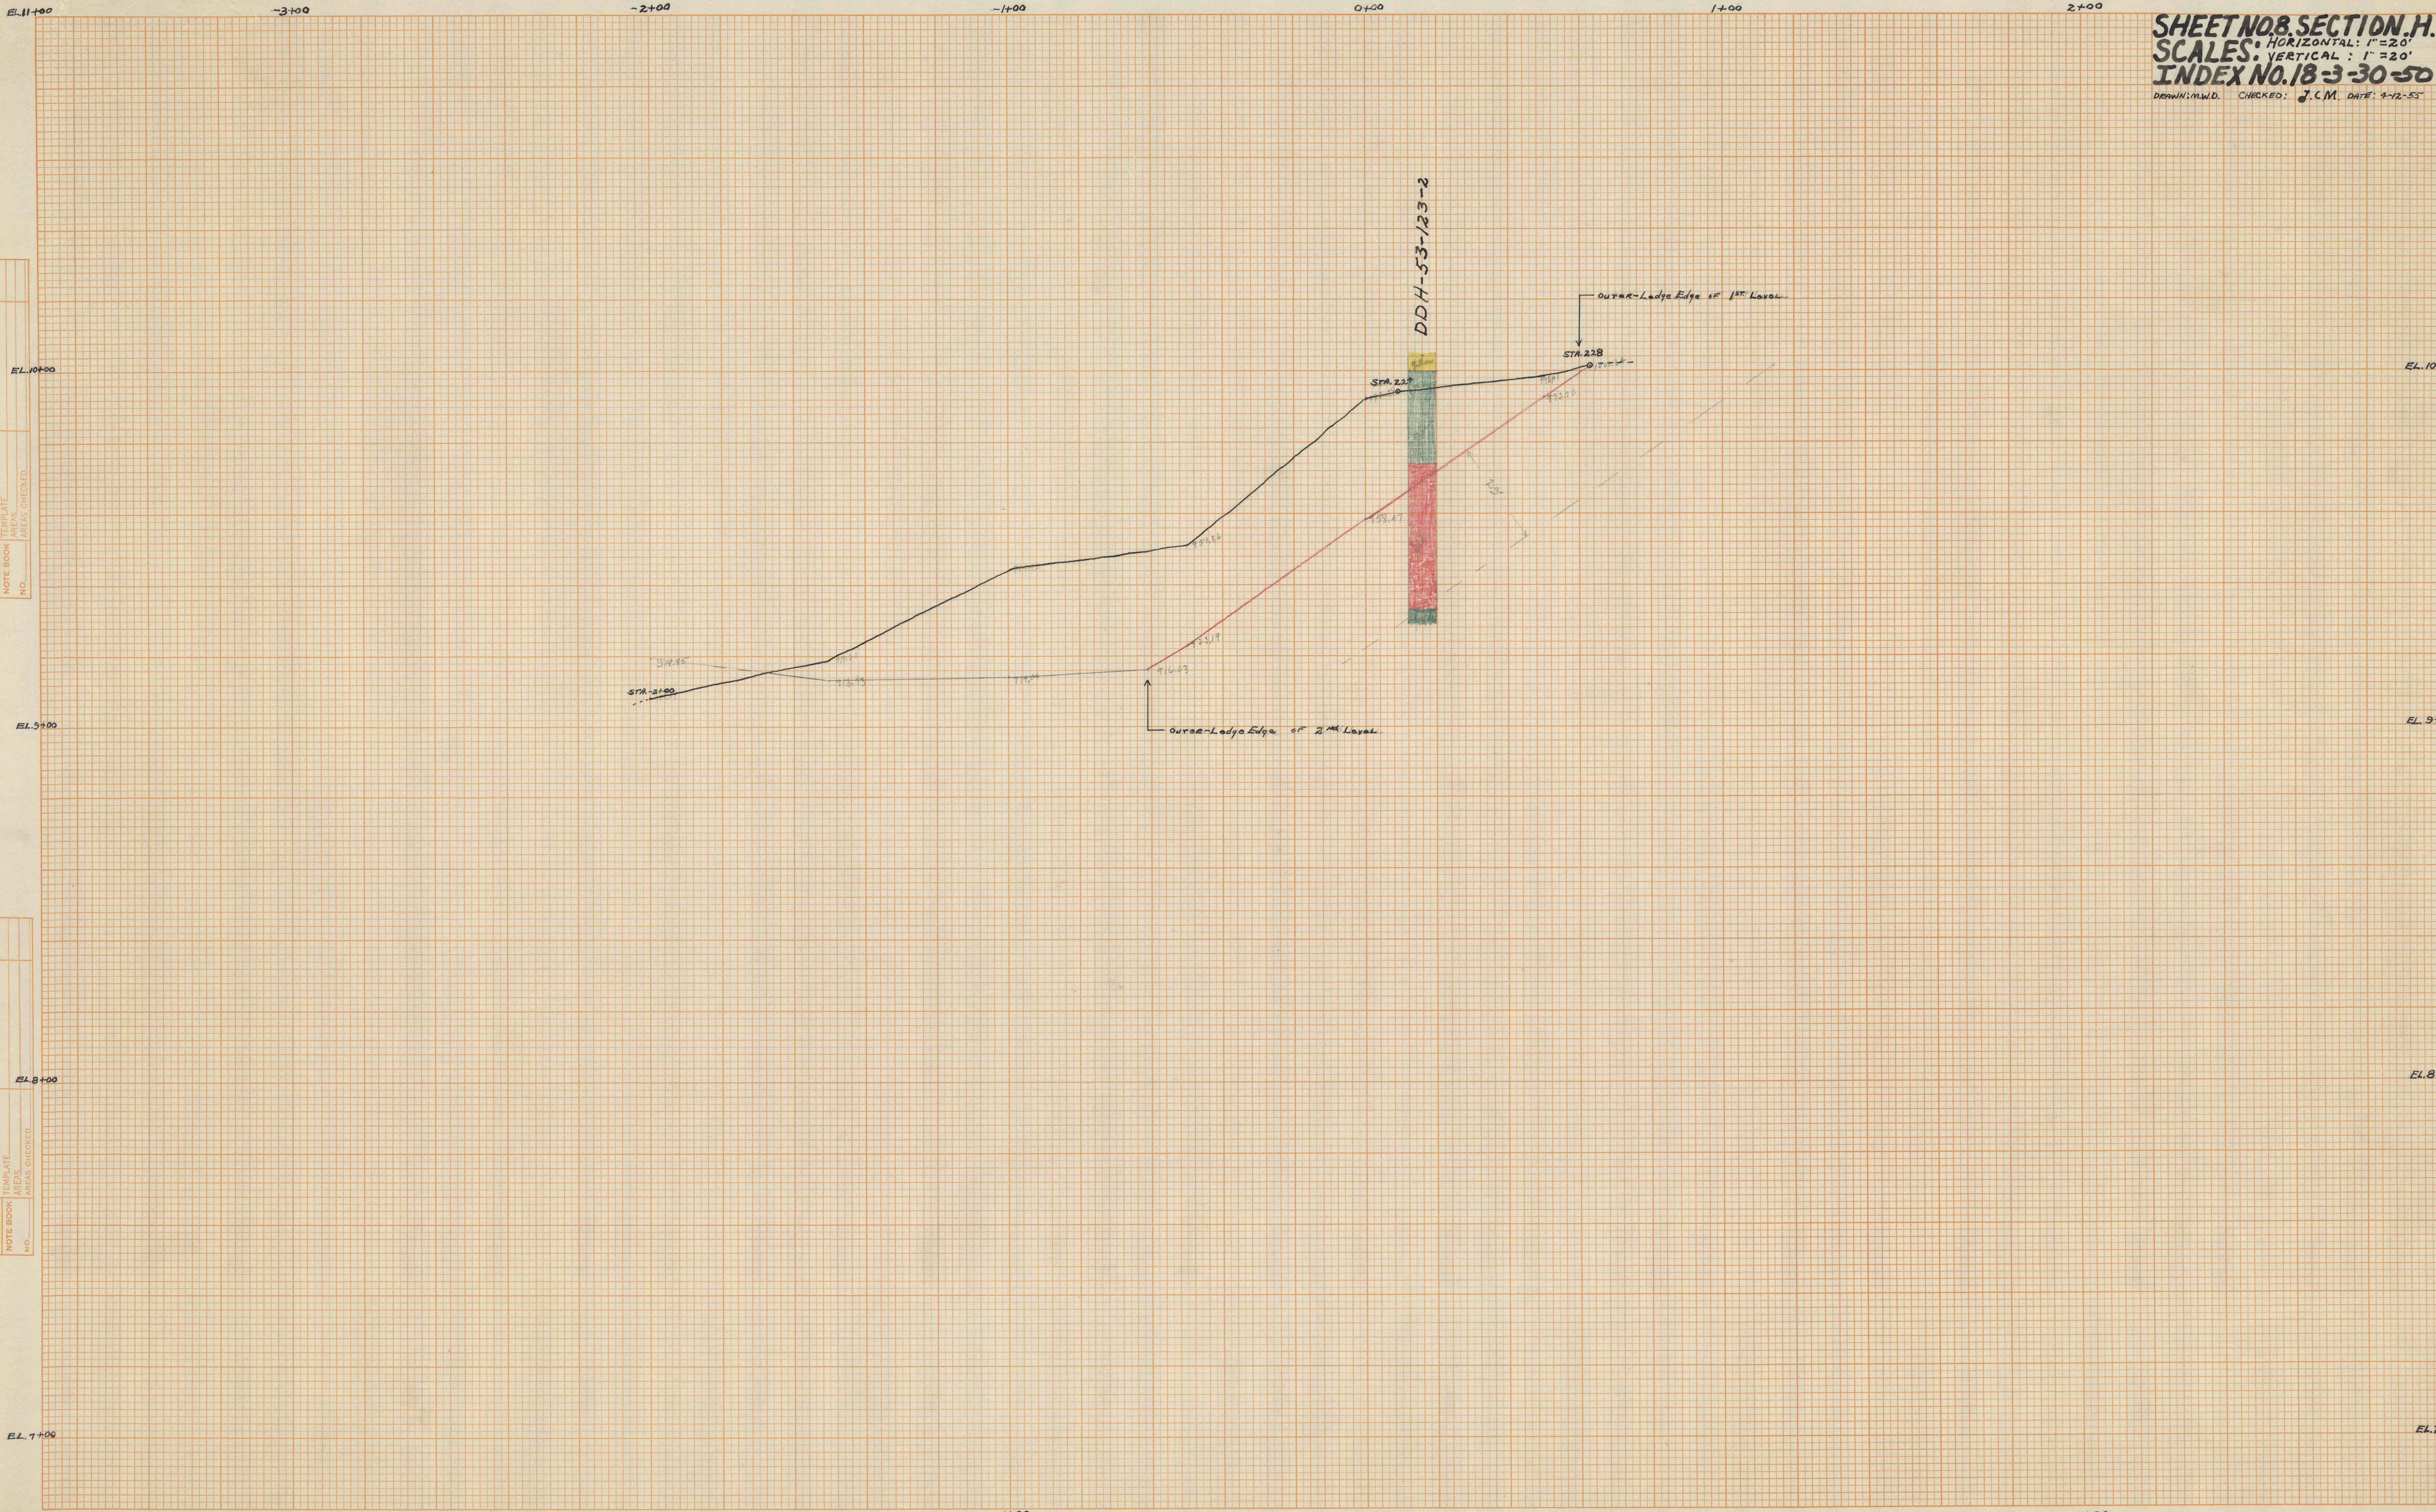

18-3-30-50

M10.M.79