


**SHEET NO. 9 SECTION I**  
**SCALES:** HORIZONTAL: 1" = 20'  
 VERTICAL: 1" = 20'  
**INDEX NO. 18-3-30-50**  
 DRAWN: M.W.D. CHECKED: J.C.M. DATE: 4-12-55

FINAL SURVEY  
 SURVEYED: \_\_\_\_\_  
 PLOTTED: \_\_\_\_\_  
 NOTE BOOK NO. \_\_\_\_\_  
 AREAS CHECKED: \_\_\_\_\_

ORIGINAL SURVEY  
 SURVEYED: \_\_\_\_\_  
 PLOTTED: \_\_\_\_\_  
 NOTE BOOK NO. \_\_\_\_\_  
 AREAS CHECKED: \_\_\_\_\_

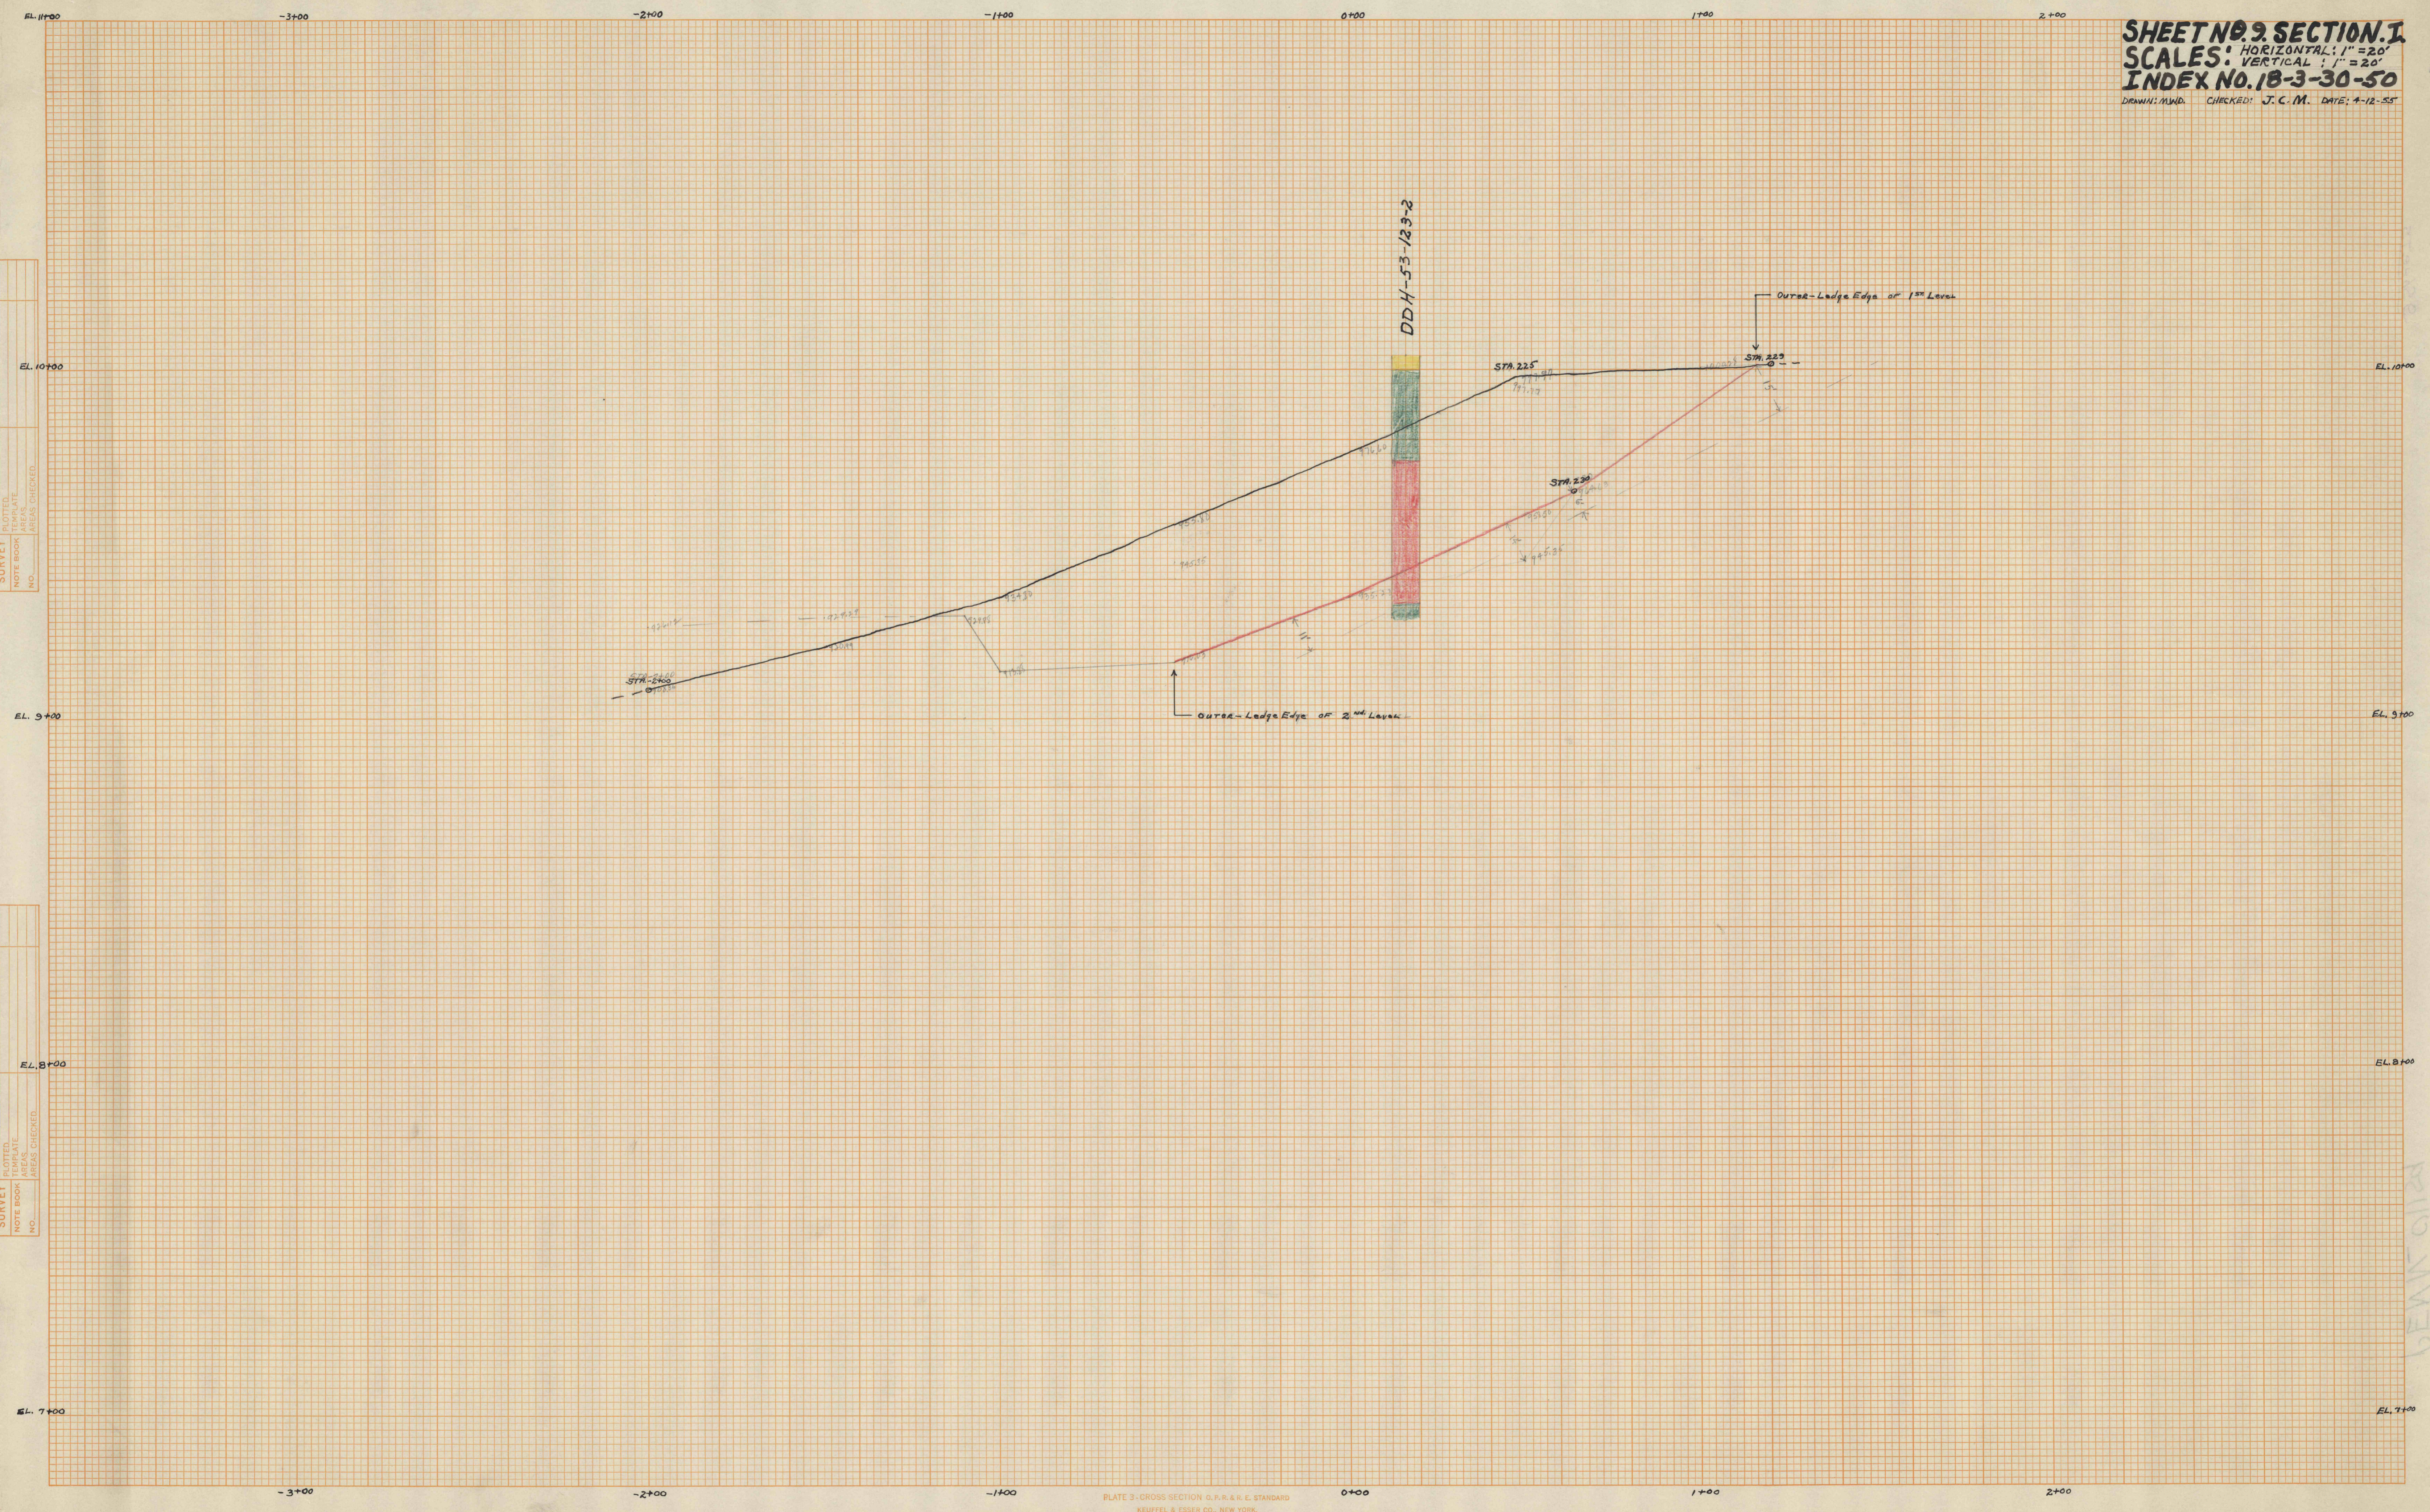

18-3-30-50

GENY-CHP