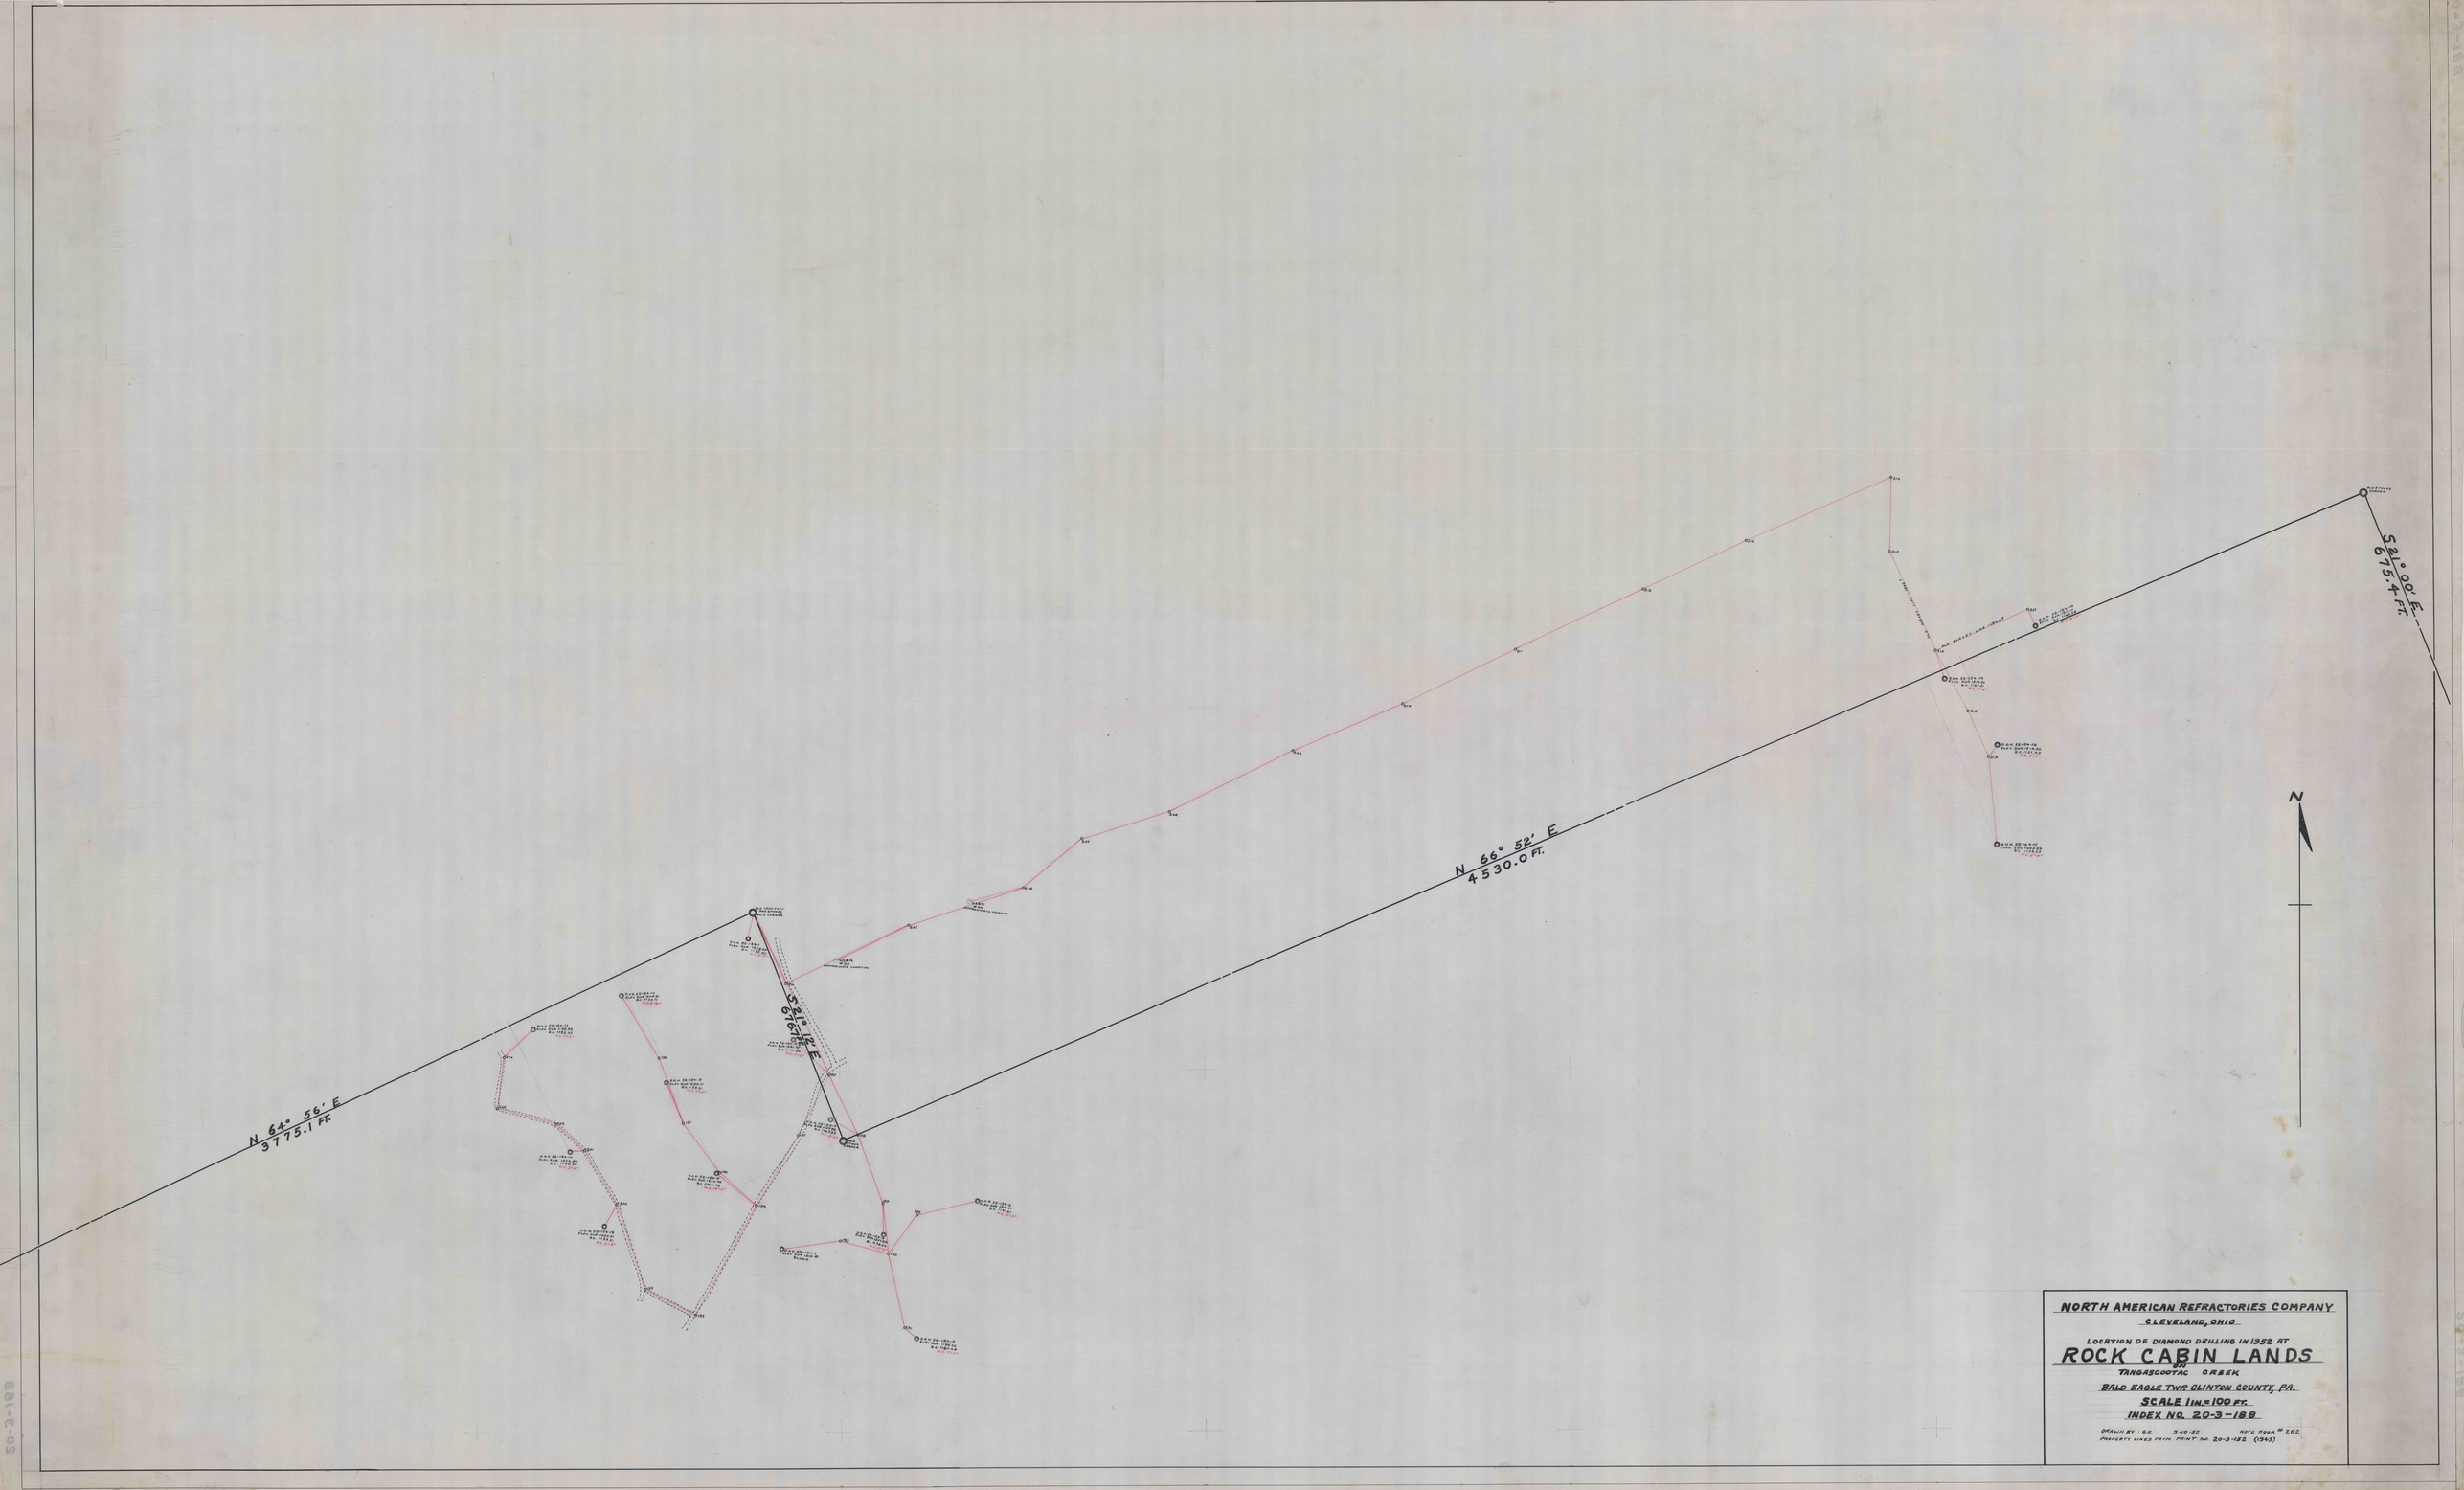

NORTH AMERICAN REFRACTORIES COMPANY
CLEVELAND, OHIO

LOCATION OF DIAMOND DRILLING IN 1952 AT
ROCK CABIN LANDS
ON
TANGASCOOTAC CREEK
BALD EAGLE TWP. CLINTON COUNTY, PA.
SCALE 1 IN. = 100 FT.
INDEX NO. 20-3-188

DRAWN BY: G.R. 3-10-52 NOTE BOOK # 262
PROPERTY LINES FROM PRINT NO. 20-3-152 (1949)

20-3-188