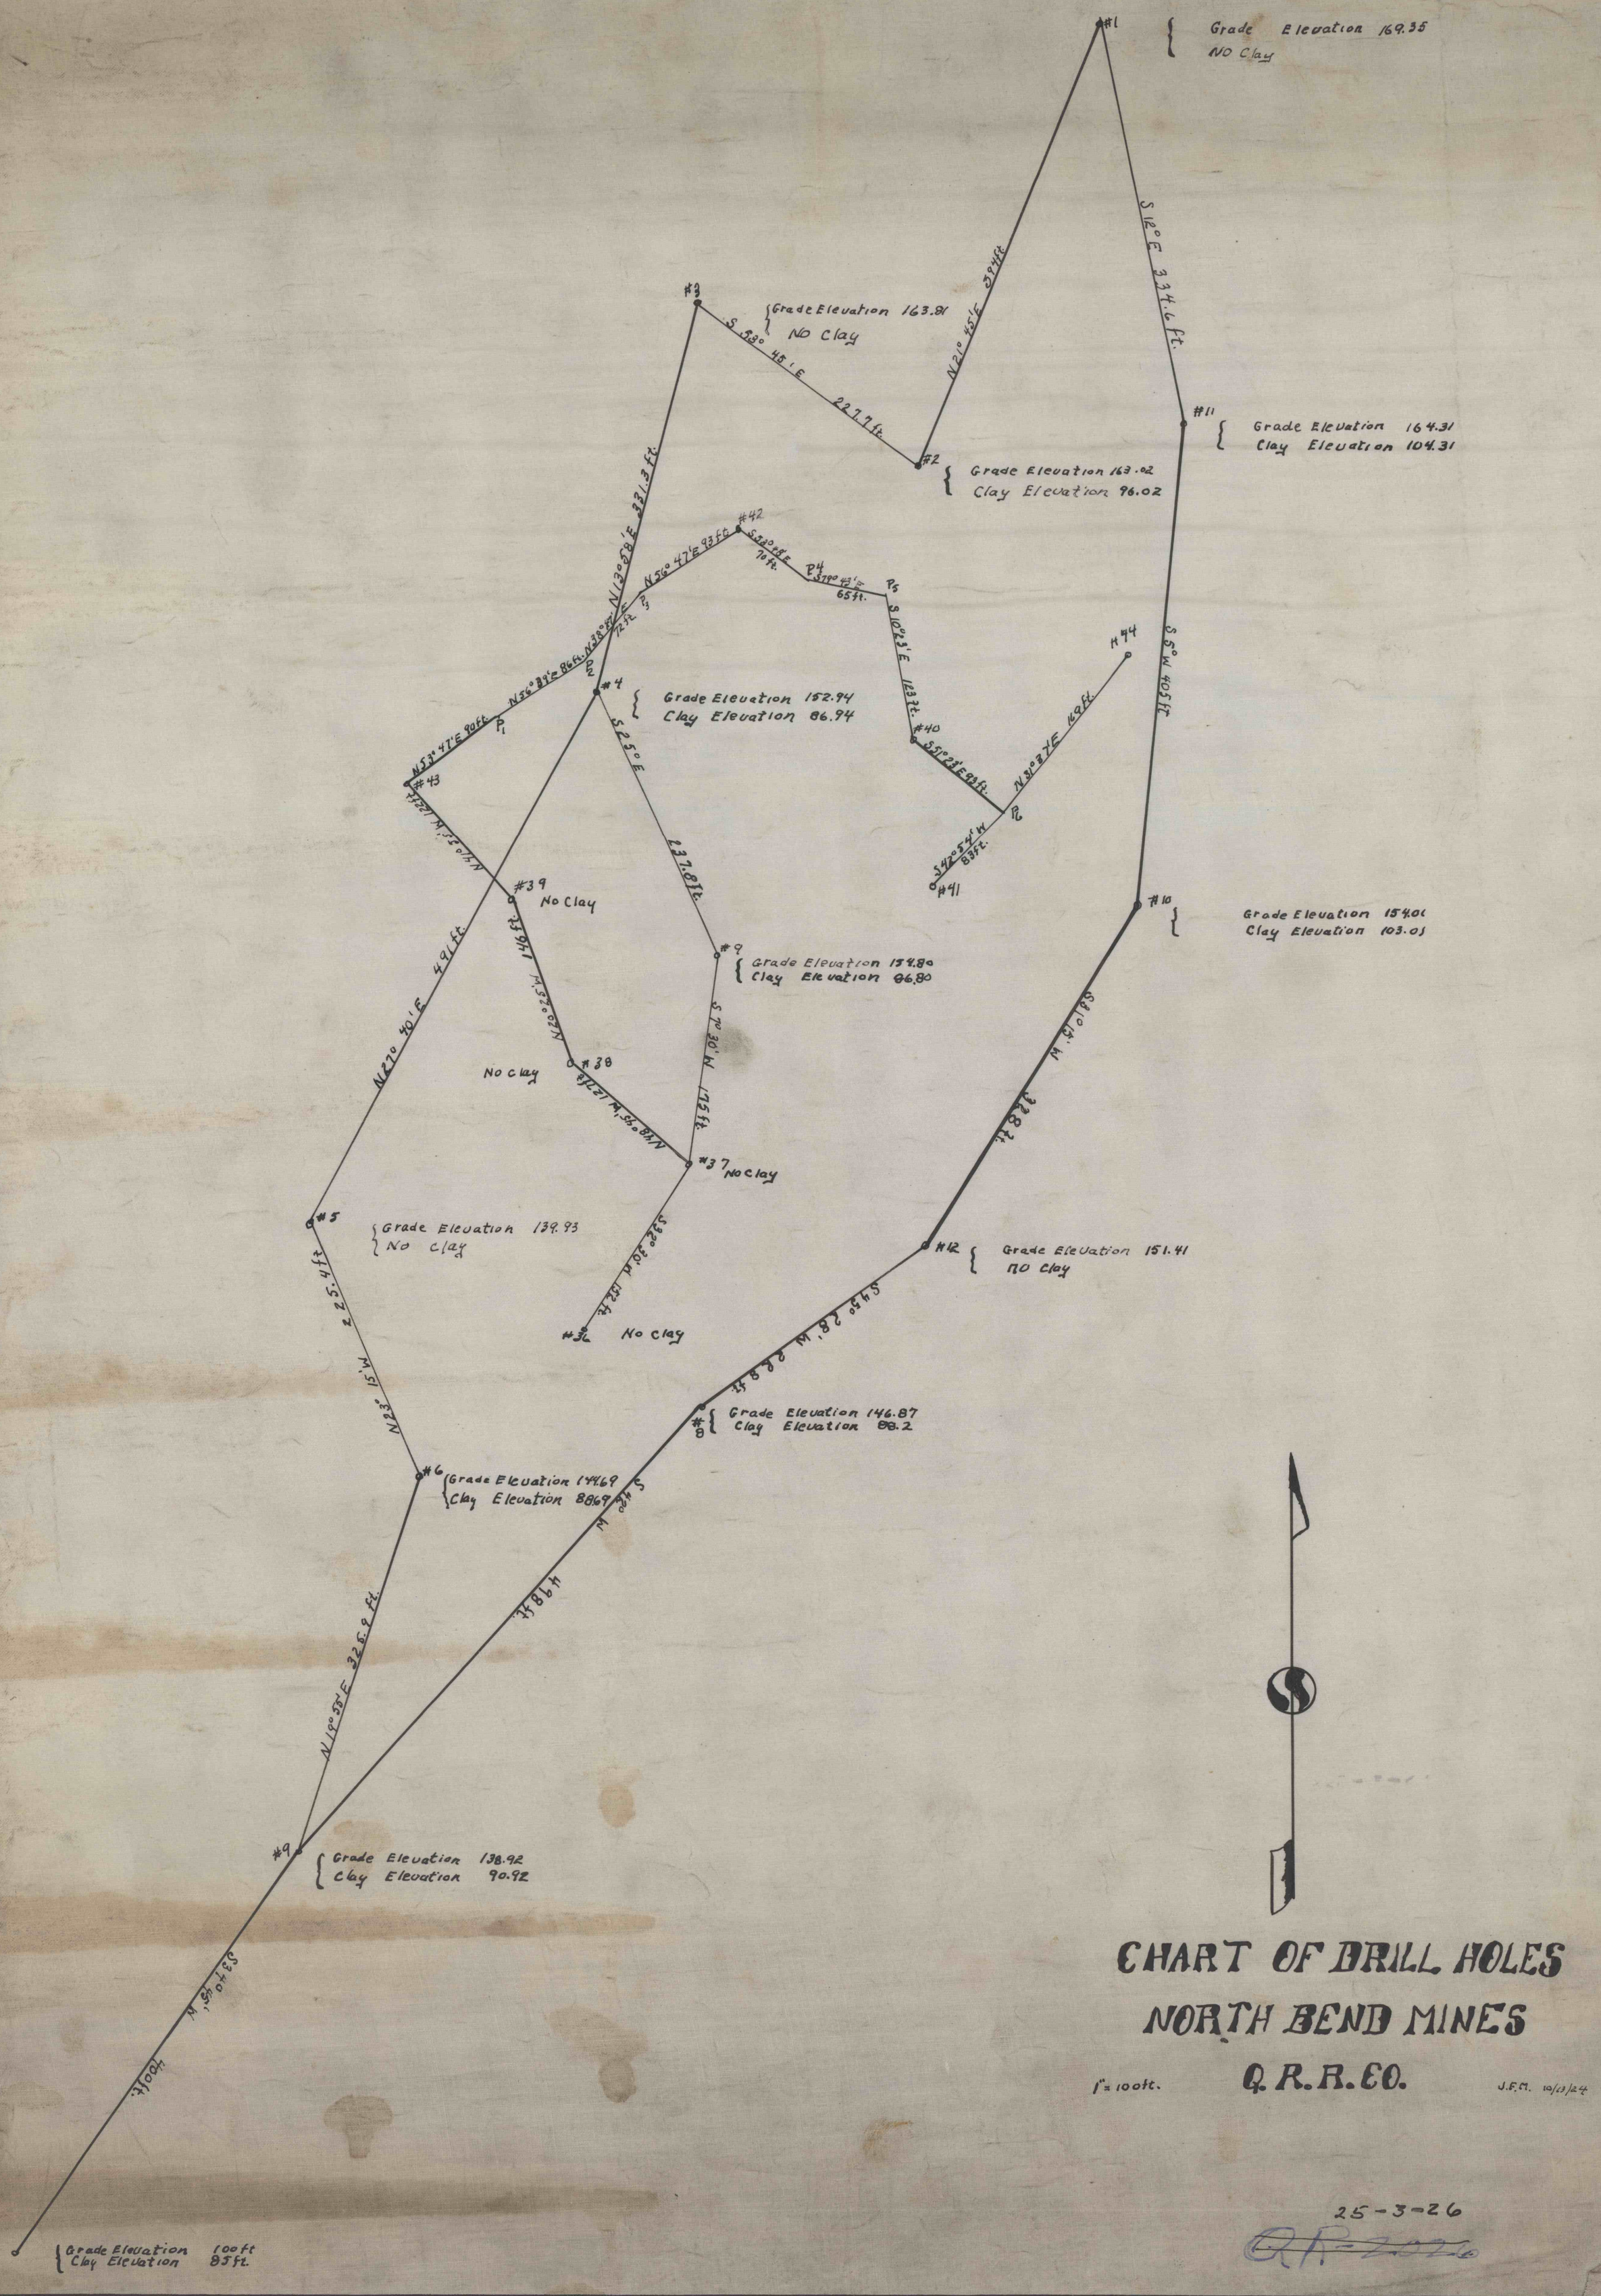
#1
Grade Elevation 169.35
NO Clay
S 12° E 334.6 ft.
#11
Grade Elevation 164.31
Clay Elevation 104.31
S 5° W 405 ft.
#10
Grade Elevation 154.0
Clay Elevation 103.0
#12
Grade Elevation 151.41
NO Clay
S 45° 28' W 228 ft.
#8
Grade Elevation 146.87
Clay Elevation 88.2
S 45° W 448 ft.
#9
Grade Elevation 138.92
Clay Elevation 90.92
S 34° 45' W 400 ft.
Grade Elevation 100 ft
Clay Elevation 85 ft.
#3
Grade Elevation 163.81
NO Clay
S 53° 45' E 227.7 ft.
#2
Grade Elevation 163.02
Clay Elevation 96.02
N 21° 45' E 394 ft.
N 13° 58' E 331.3 ft.
#42
S 32° 48' E 70 ft.
P4
S 79° 42' E 65 ft.
P5
S 10° 23' E 123 ft.
#40
S 51° 23' E 93 ft.
P6
N 31° 37' E 149 ft.
#44
S 42° 54' W 83 ft.
#41
N 56° 47' E 93 ft.
P3
72 ft.
N 56° 39' E 86 ft.
N 38° 47'
P2
#4
Grade Elevation 152.94
Clay Elevation 86.94
N 53° 47' E 80 ft.
P1
#43
N 70° 53' W 127 ft.
S 25° E
237.8 ft.
#39
No Clay
N 22° 25' W 239 ft.
#38
No Clay
N 48° 45' W 127 ft.
S 70° 30' W 175 ft.
#37
No Clay
S 32° 30' W 182 ft.
#36
No Clay
N 27° 40' E 491 ft.
#5
Grade Elevation 139.93
No Clay
N 23° 15' W 225.4 ft.
#6
Grade Elevation 144.69
Clay Elevation 88.69
N 19° 55' E 325.9 ft.
CHART OF DRILL HOLES
NORTH BEND MINES
1" = 100 ft.
Q. R. R. CO.
J.F.M. 10/13/24
25-3-26