

SARAH IRVIN


DOMENICO VESCO  
10 A.S.  
C.R.CO. CLAY LEASE

JANE NEEPER EST

ORD NORRIS

RACHEAL GOSS

JOSH. HARTSHORN EST

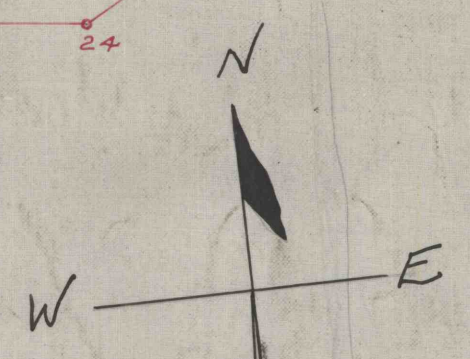

CRESCENT REFRACTORIES CO. CURWENSVILLE, CLEARFIELD COUNTY, PA. ENGINEERING DEPARTMENT		
Jane Neeper Tract Pike Township Clearfield Co. Pa.		
DRAWN H.S.C.	SCALE 1/2" = 100'	50-3-110
CHECKED	DATE July 19, 1924	46627
REFERENCE	ORDER	

G.W. WISE

72°30' 430

Surface 965.4

Surface 974.5

DDH #4

DDH #5

DDH #6

#3-4-5+6 approximate location

Cor

Cor

Write

Stone

7set

N 83° 30' W 610

S 83° 21' E 1107

S 83° 40' E 2732

N 82° 03' W

1099

N 71° 05' E

S 53° 30' W

N 5° 32' E

36° 30'

475

545

4210

3° 45'

630

515

51105

38° 45'

430

442

150

500

324

400

Write

Stone

7set